PLAT AND RECORD

COUNTY BUILDING
IN CITY OF BELOIT

Of a Survey on Section 4 T 4 R 11 E. of the 4 P. M. in Porter Township

Rock County, Wisconsin, made March the 28-30 & 31 1874

I hereby certify that the following is a correct record of said survey as made by me.

(Signed) Edward Ruger
R.P.R.B.
County Surveyor.

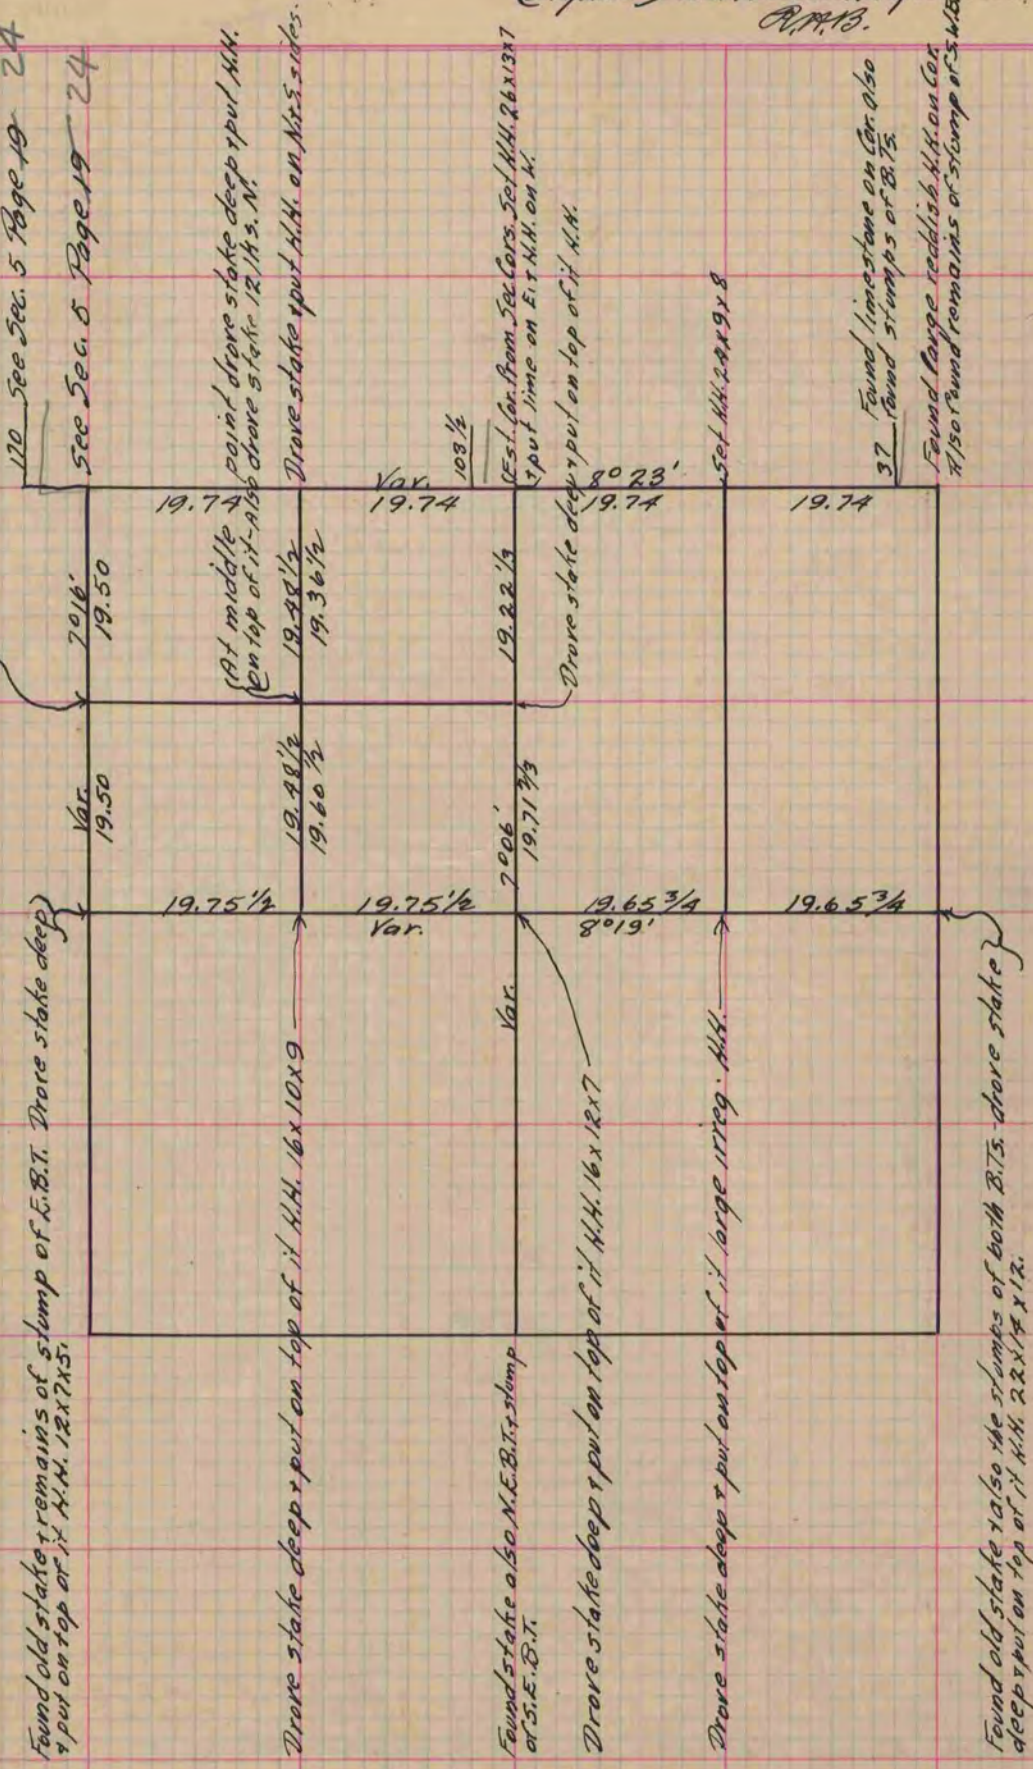

Copied from P. 87 Vol. 2 Original County Surveyor's Record.