PLAT AND RECORD

Of a Survey on Section 10 T 1 R 13 E. of the 4 P. M. in Turtle Township

Rock County, Wisconsin, made April the 20th 1865

I hereby certify that the following is a correct record of said survey as made by me.

COUNTY BUILDING
IN CITY OF BELOIT

(Signed) S. D. Locke. County Surveyor.

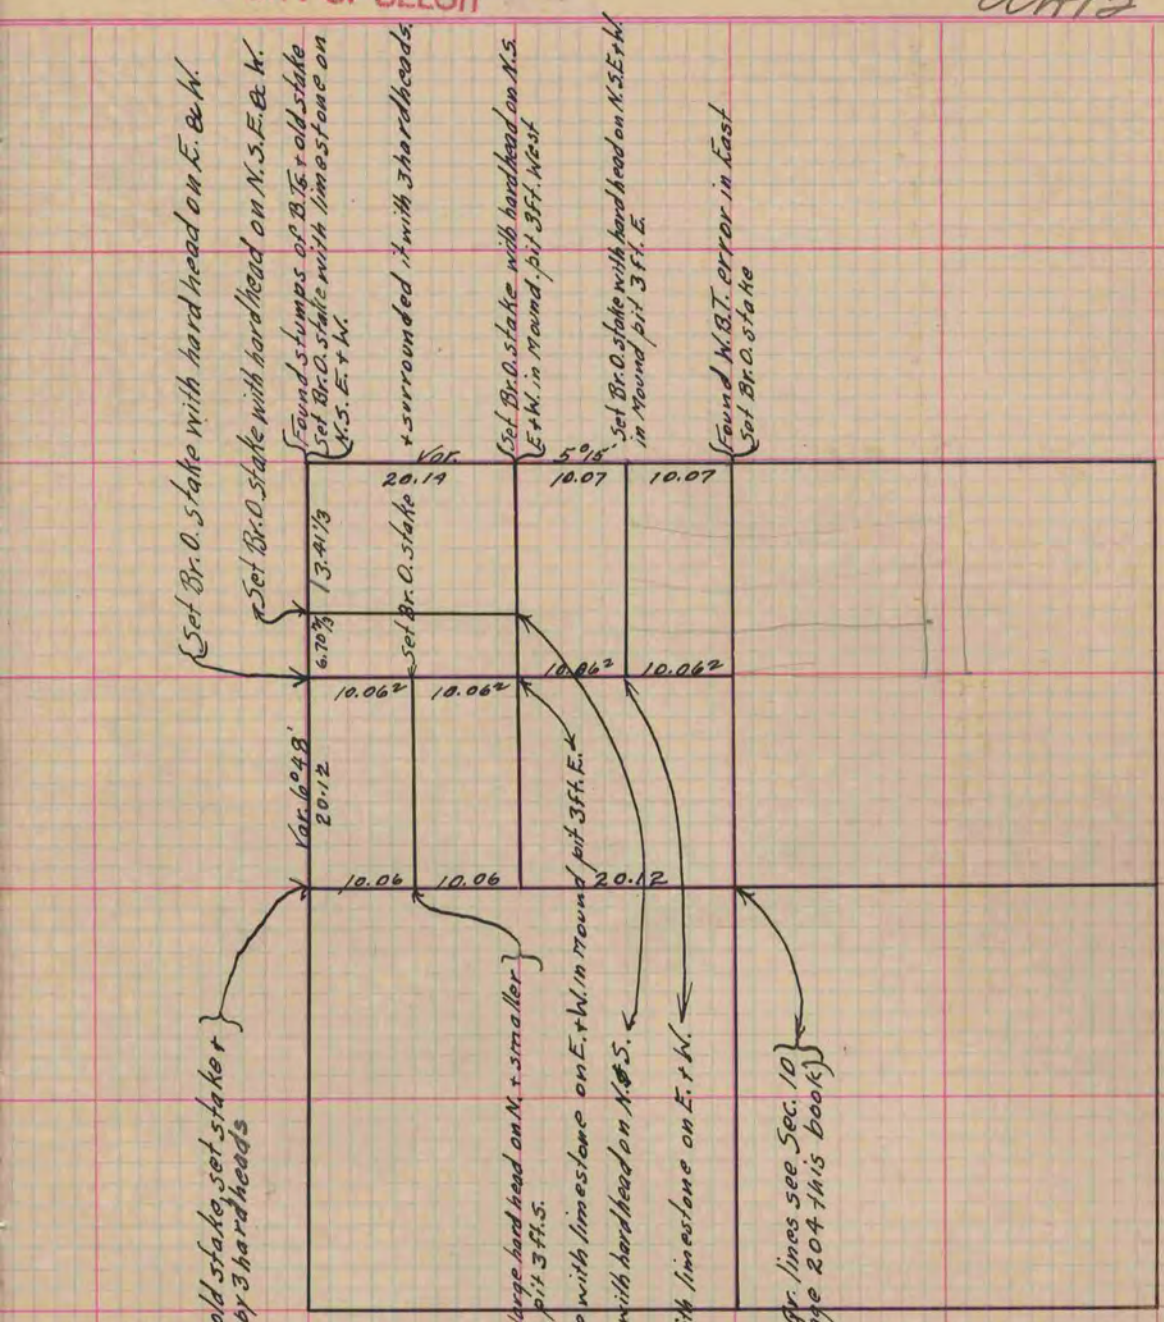

Copied from Page 215 Vol. 1. Original County Surveyor's Record.