PLAT AND RECORD

Of a Survey on Sections E½ 17 & E½ 18 T 3 R 13 E. of the 4 P. M. in Harmony Township

Rock County, Wisconsin, made September the 1-10 1886

I hereby certify that the following is a correct record of said survey as made by me.

(Signed) Edward Ruger
County Surveyor.

COUNTY BUILDING
IN CITY OF BELOIT

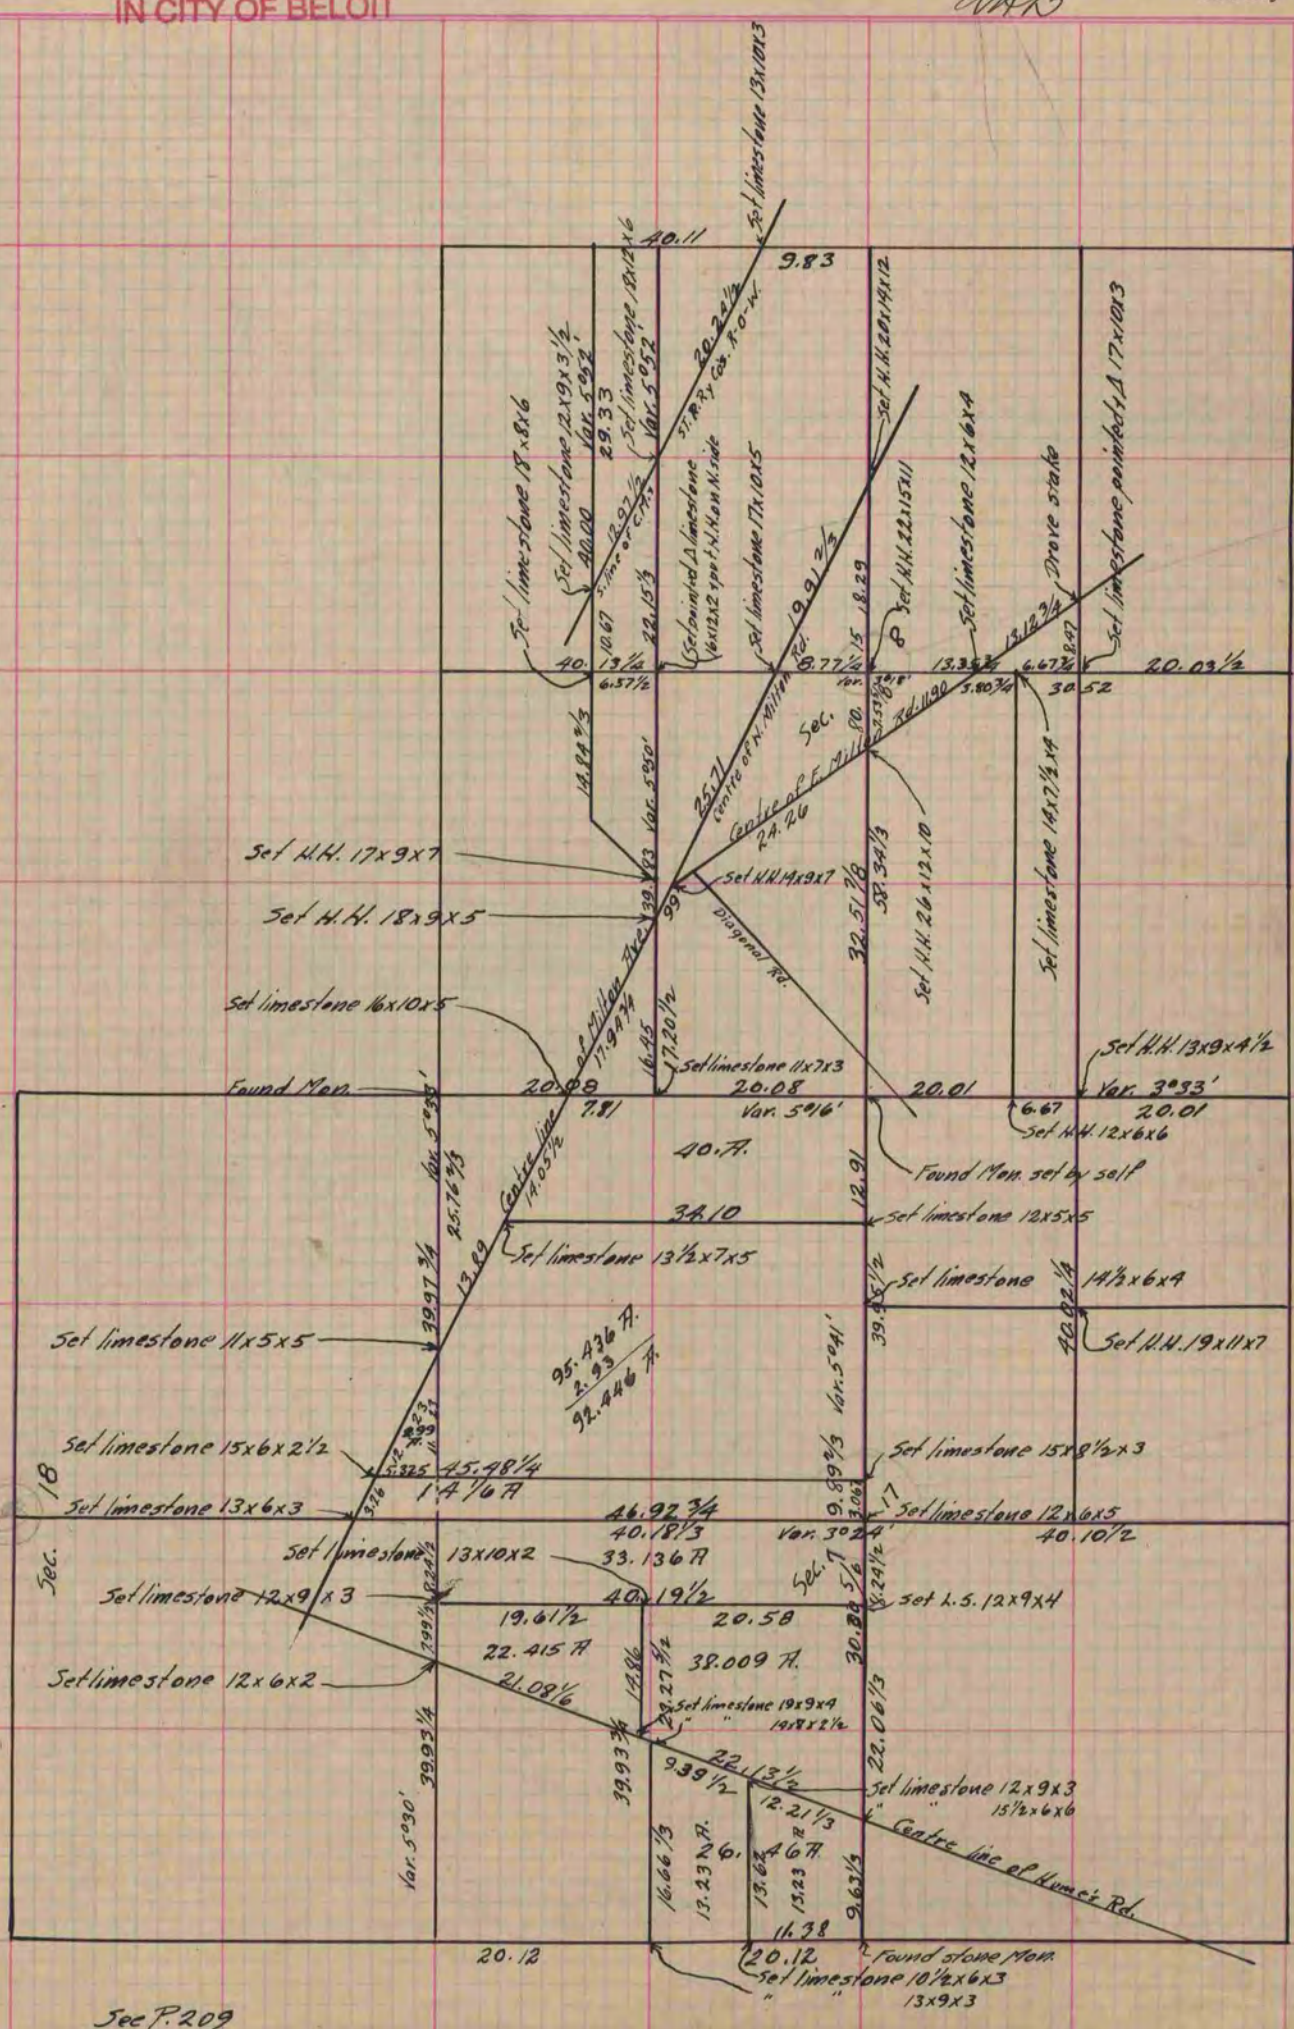

See P. 209

Copied from P. 241 Vol. 2 County Surveyor's Record