PLAT AND RECORD

Of a Survey on Section 20 T 4 R 10 E. of the 4 P. M. in Union Township

Rock County, Wisconsin, made Oct. the 23+24 1891

I hereby certify that the following is a correct record of said survey as made by me.

COUNTY BUILDING
IN CITY OF BELOIT

(Signed) O. G. Bleedorn
RMB Dep. County Surveyor.

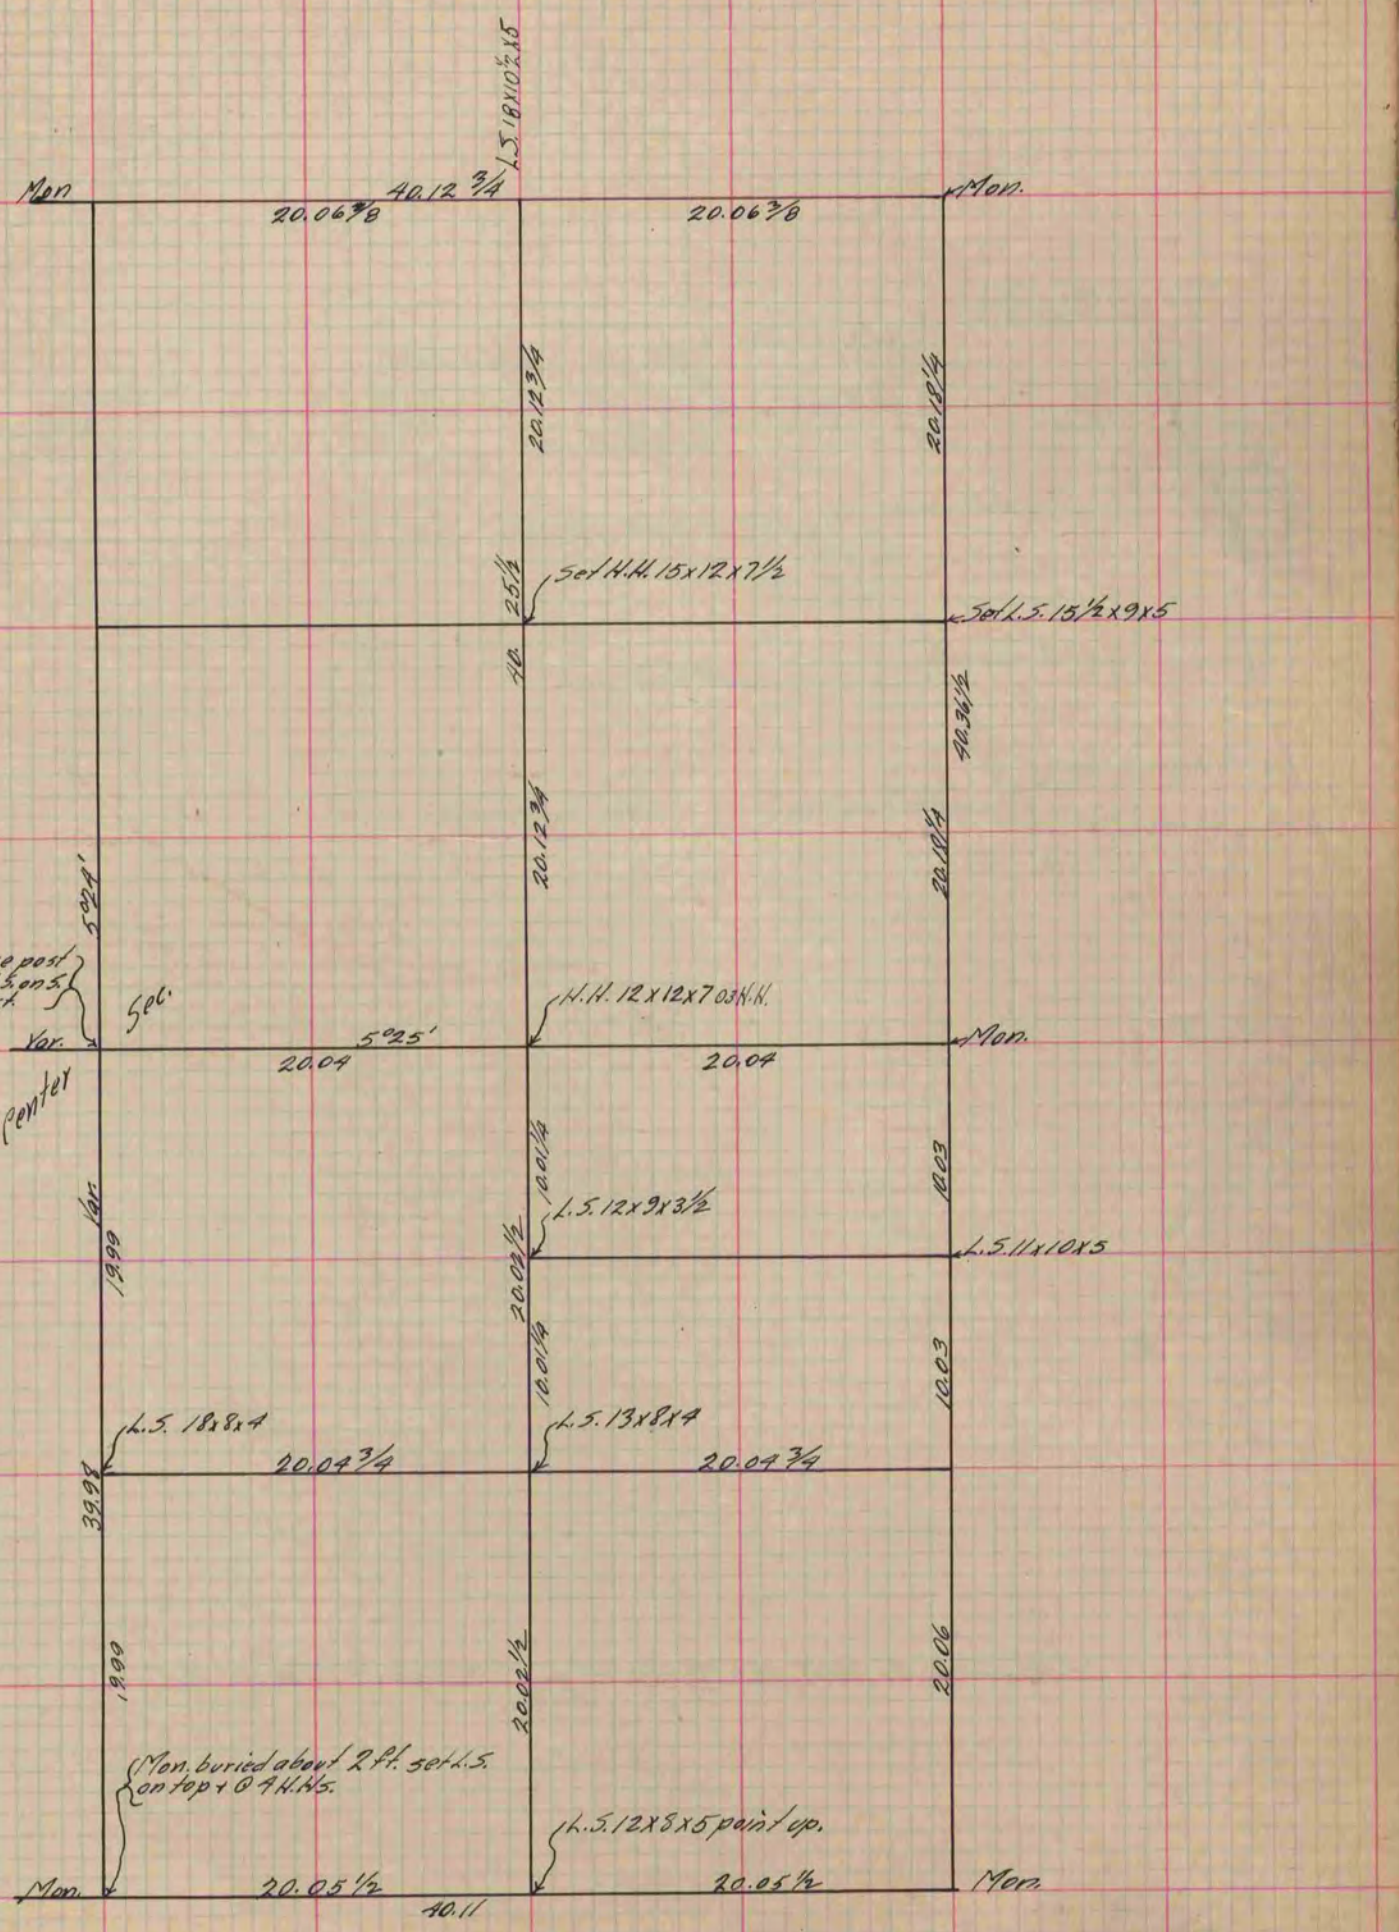

Copied from P. 363 Vol. 2 County Surveyor's Record.