PLAT AND RECORD

Of a Survey on Section 33 T 4 R 10 E. of the 4 P. M. in UNION Township

Rock County, Wisconsin, made 5 the 9 1966

I hereby certify that the following is a correct record of said survey as made by me.

COUNTY BUILDING
IN CITY OF BELOIT

THE GEO. D. BARNARD COMPANY, ST. LOUIS
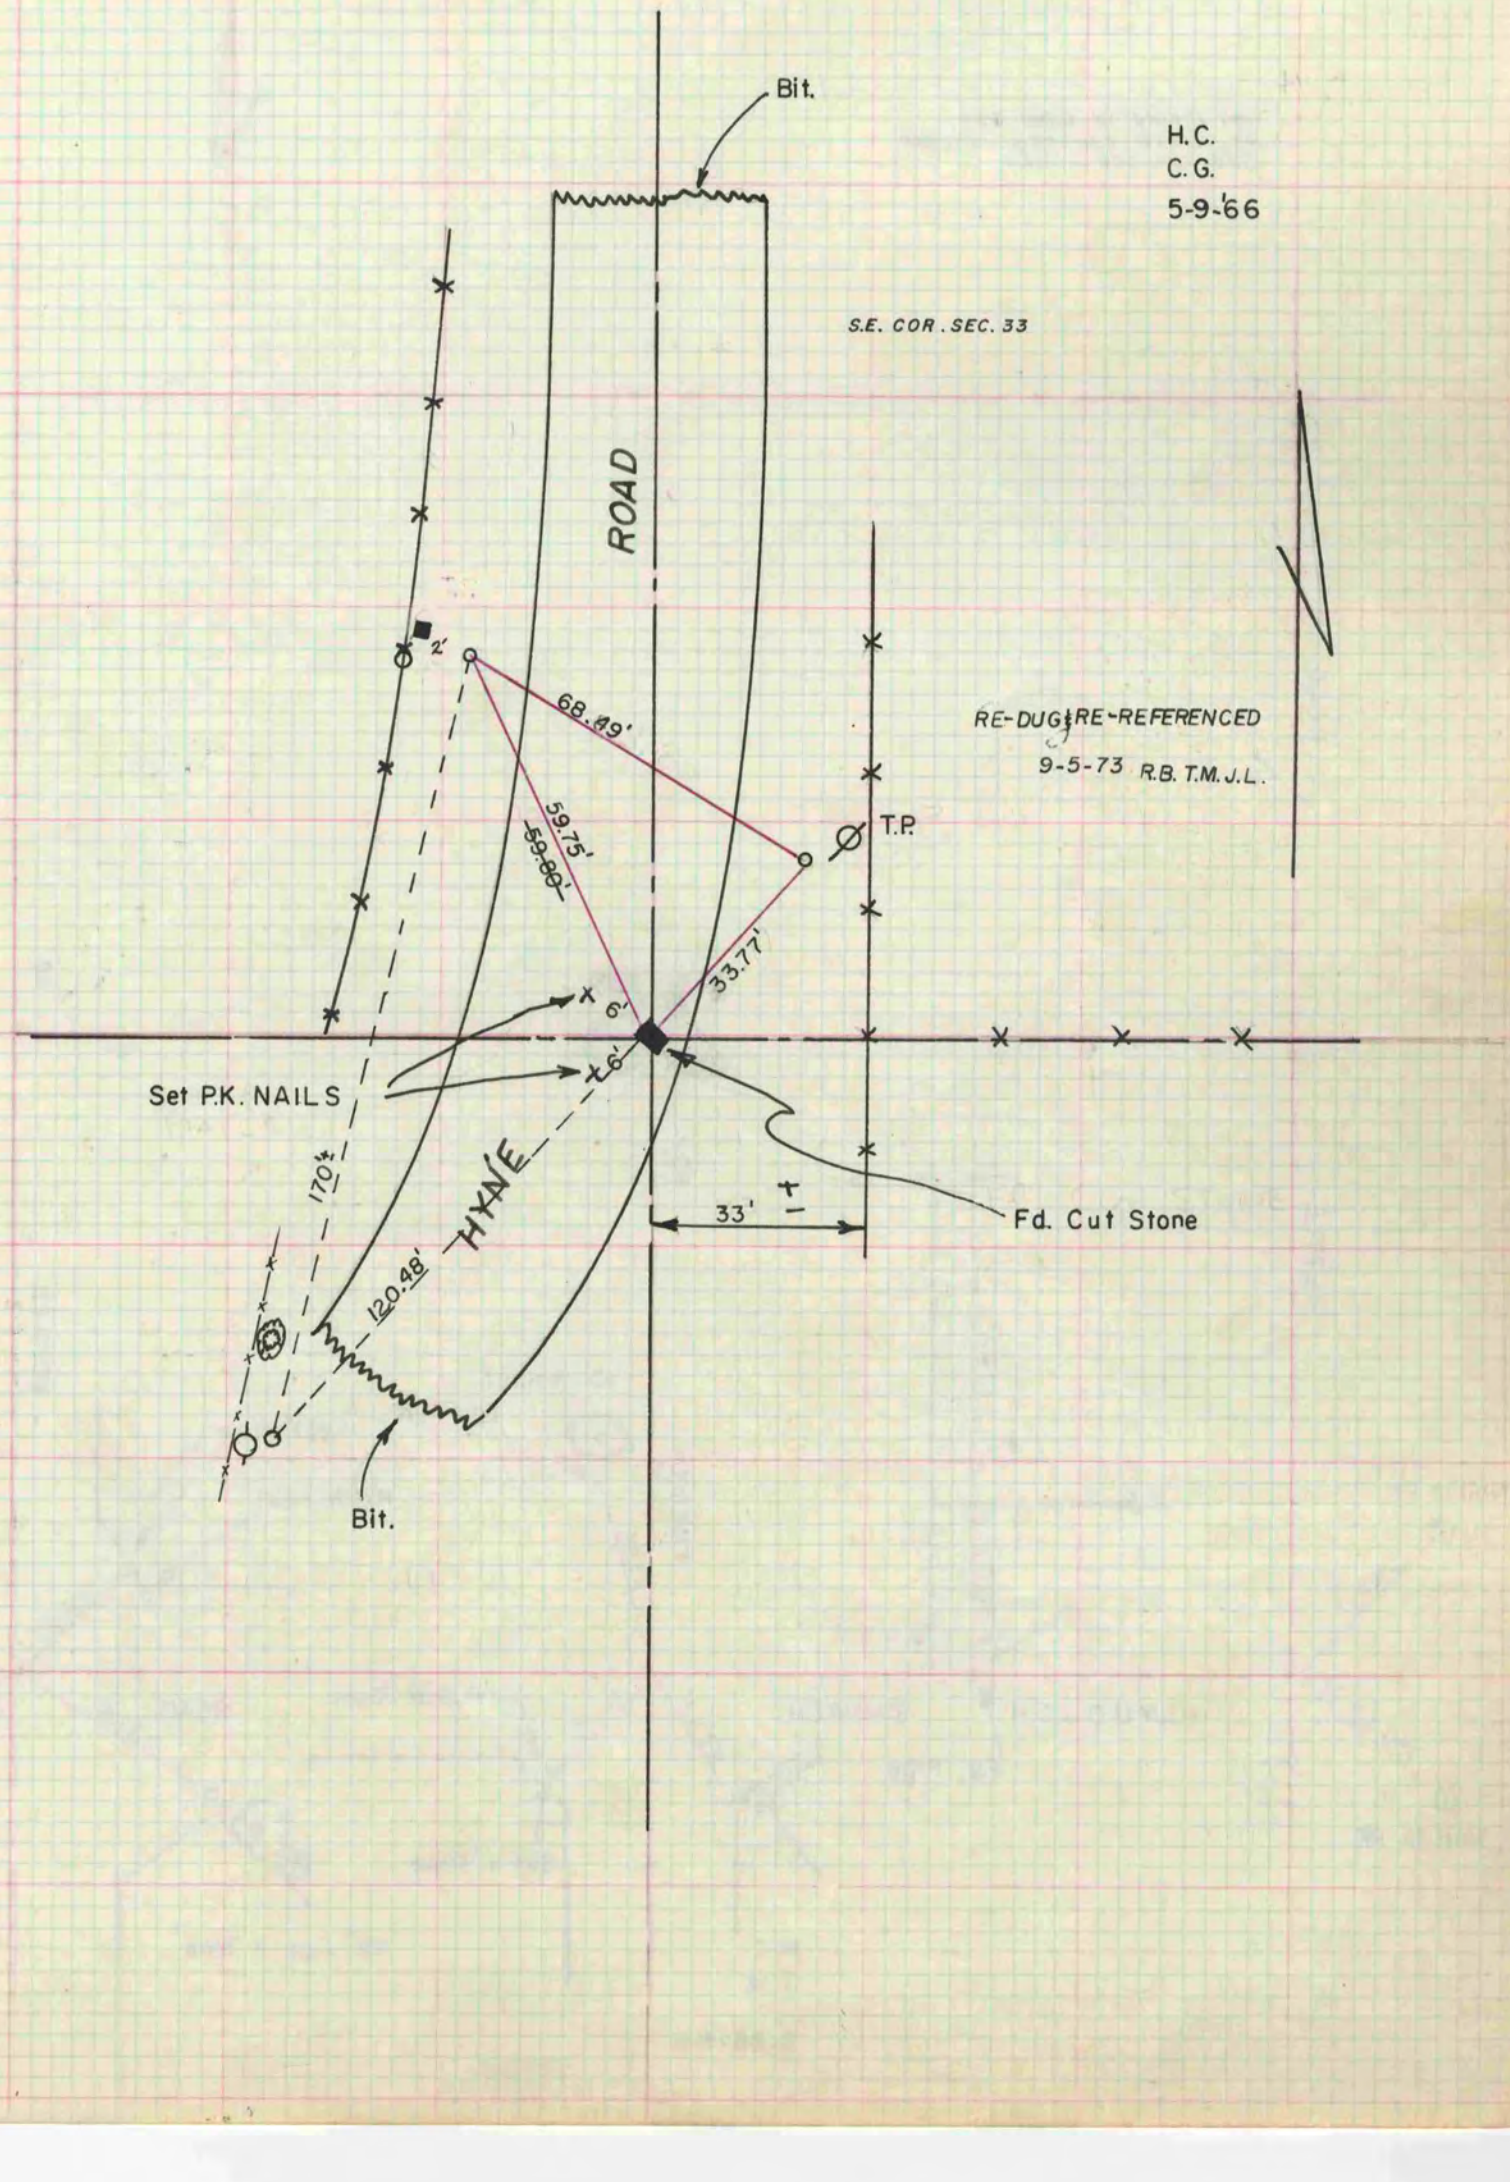
R. H. Bartelman Jr.
County Surveyor.