193

PG 204 JANESVILLE
REC 12/15/75 DAB

PLAT AND RECORD

OF O.L. #70, IN EVANSVILLE

Of a Survey on Section 27 T 4N. R 10 E. of the 4 P. M. in UNION Township

Rock County, Wisconsin, made June the 3 1931

I hereby certify that the following is a correct record of said survey as made by me.

COUNTY BUILDING
IN CITY OF BELOIT
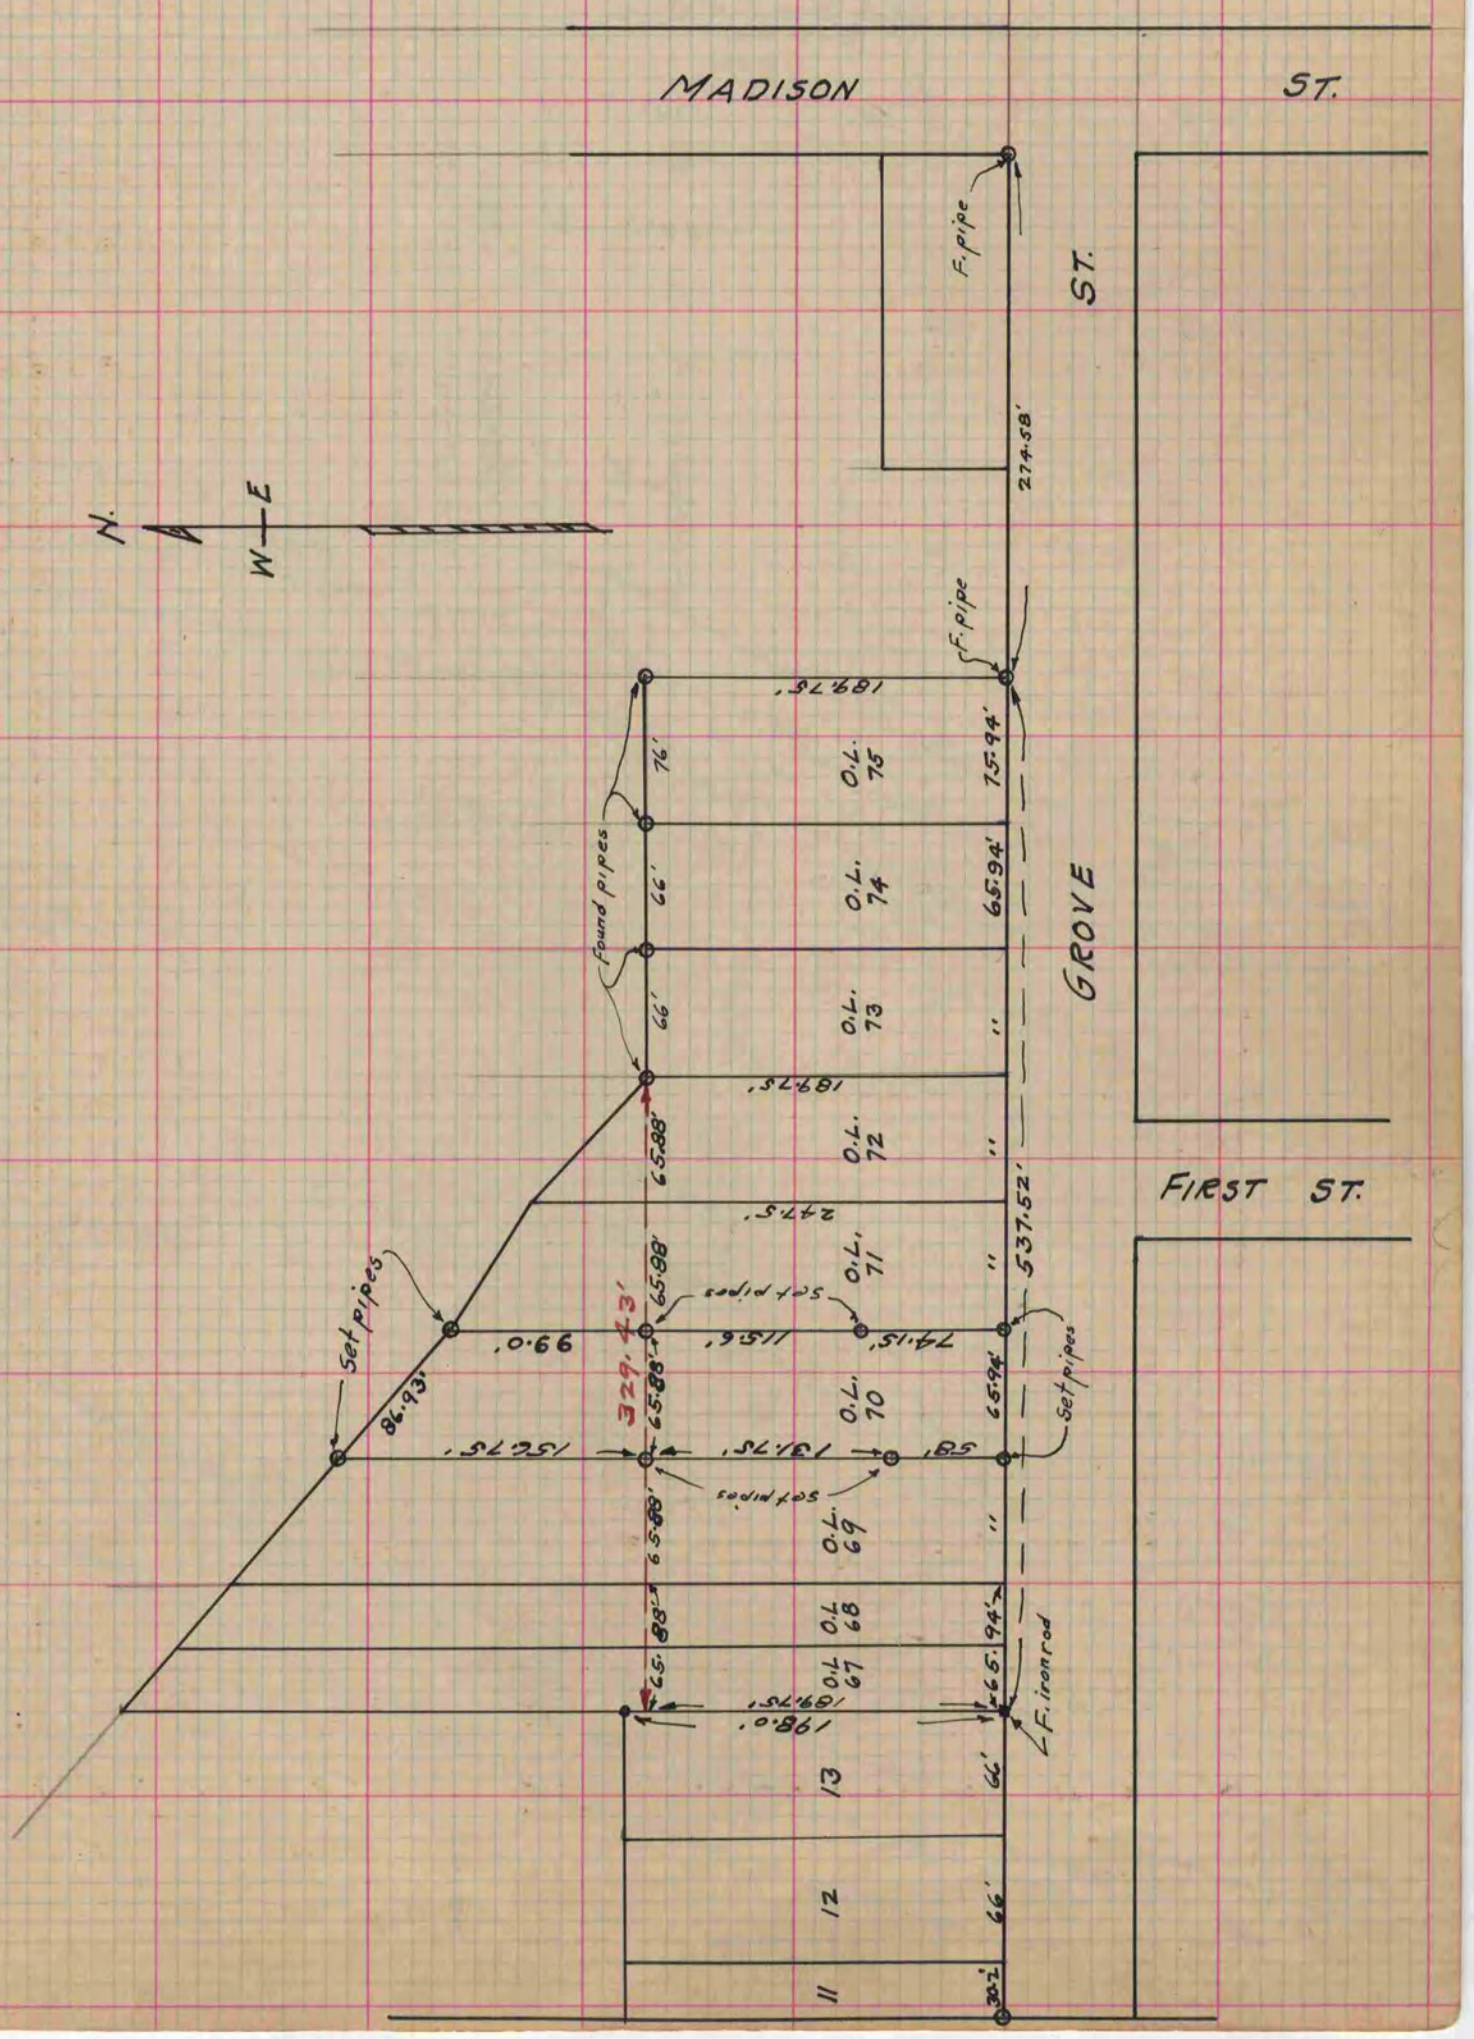
B. J. Gunny
County Surveyor.