188 PG 197 JANESVILLE REC
12/12/75 DAB

PLAT AND RECORD

COUNTY BUILDING
IN CITY OF BELOIT

Of a Survey on N.W.¼ Section 10 T4N. R12 E. of the 4 P. M. in FULTON Township

Rock County, Wisconsin, made April 24 to May 16 the 1931.

I hereby certify that the following is a correct record of said survey as made by me.

B. J. Bunny
County Surveyor.

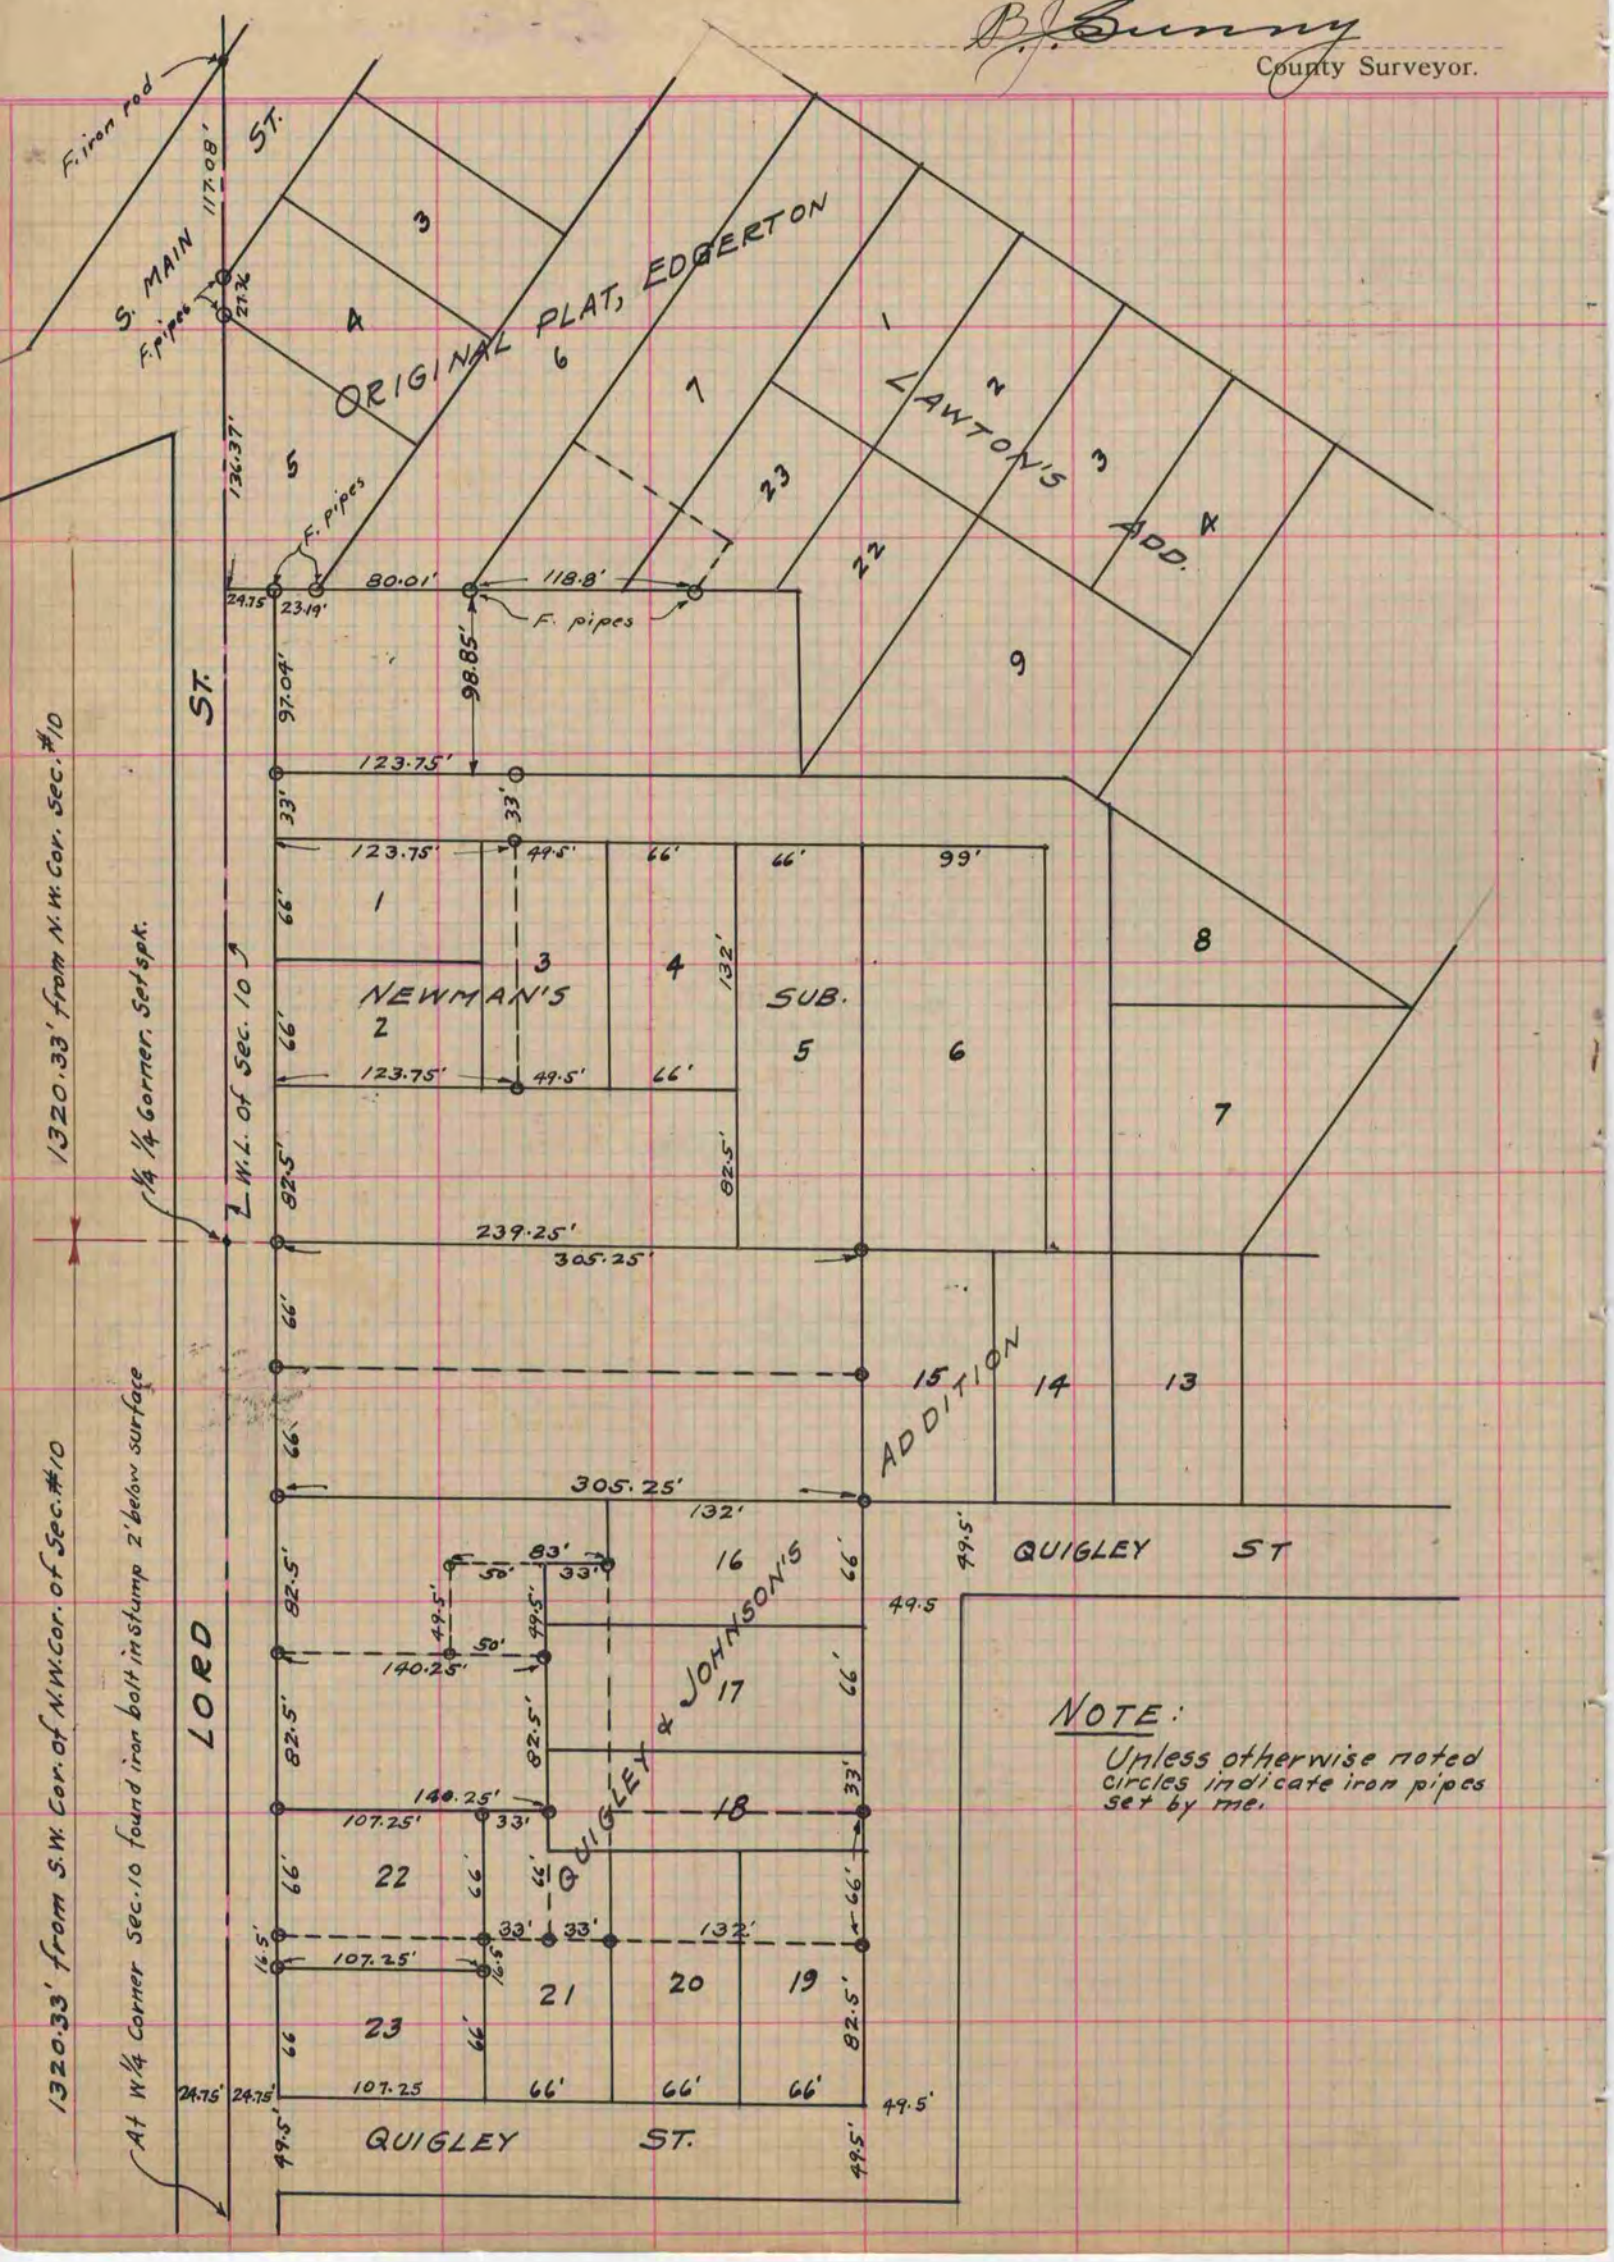

NOTE:
Unless otherwise noted circles indicate iron pipes set by me.