PLAT AND RECORD

Of a Survey on Section 11 & 12 / 13 & 14 T 2N R 12 E. of the 4 P. M. in ROCK Township

Rock County, Wisconsin, made June the 1959

I hereby certify that the following is a correct record of said survey as made by me.

COUNTY BUILDING
IN CITY OF BELOIT

County Surveyor.
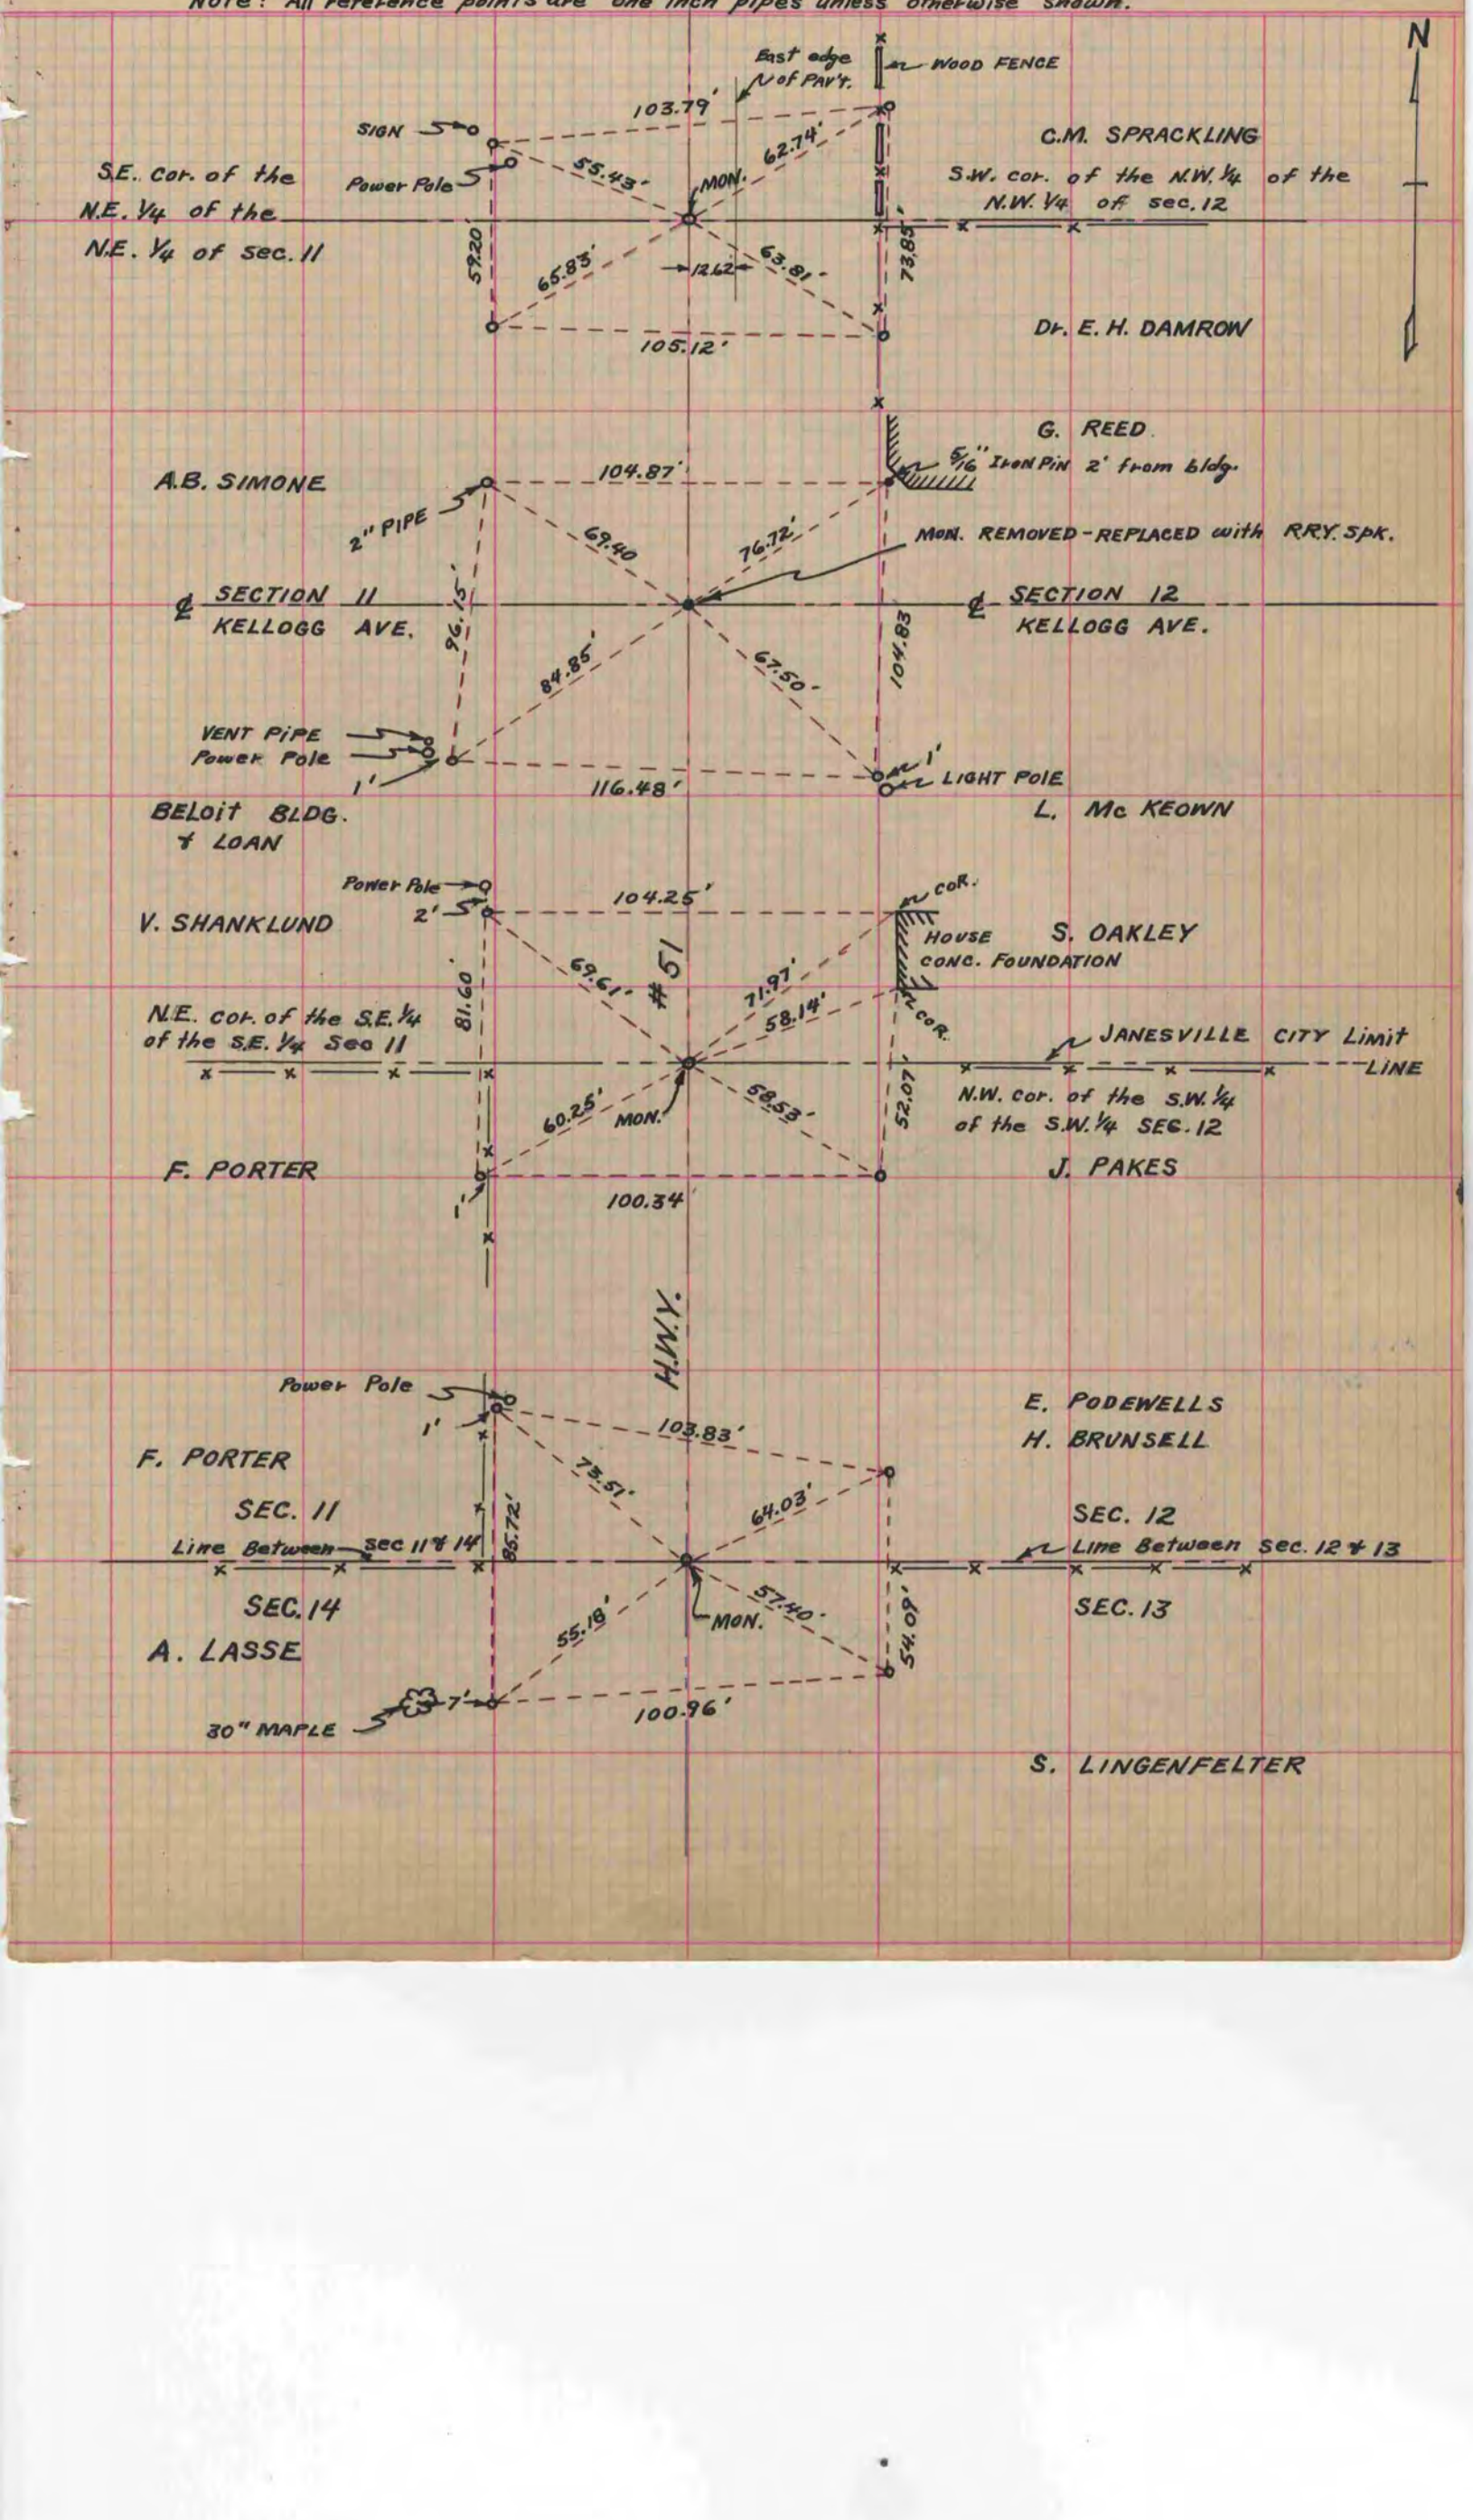
Note: All reference points are one inch pipes unless otherwise shown.