Paper weight-110# (minimum) Black nonfading ink required

# U.S. PUBLIC LAND SURVEY MONUMENT RECORD

For Public Land Survey Corners In:

T. 4 N. R. 13 E. 4th P.M.

WI ADMINISTRATIVE CODE A-E 7.08 REQUIREMENT

REV 10/23/2004 USMONREC.DWG

CORNER CODE INDEX

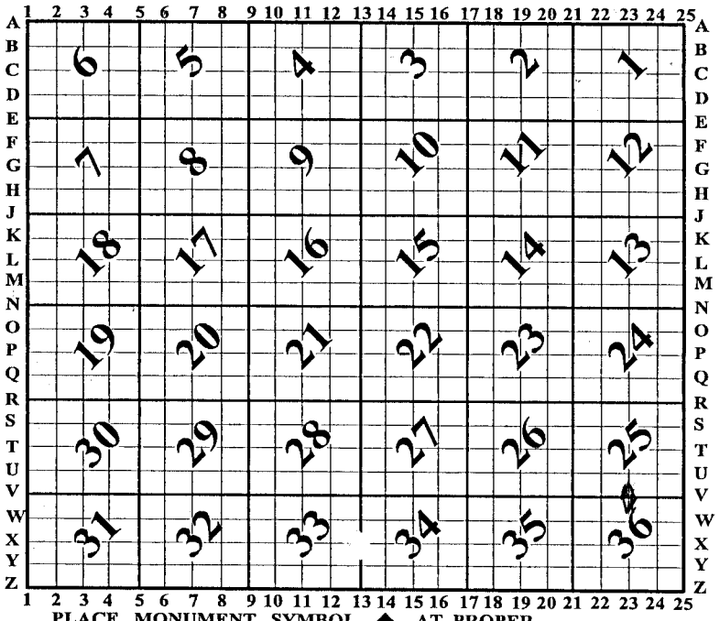


PLACE MONUMENT SYMBOL ◆ AT PROPER LOCATION ON ABOVE INDEX

MILTON TWP

ROCK COUNTY WI

IF AVAILABLE
ROCK COUNTY COORDINATES PERFERRED

North _____ Elev. _____

East _____

Hor. Datum _____ Vert. Datum _____

LATITUDE _____ ELLIPS. HT.

LONGITUDE _____ _____

NAD83(91) _____ NETWORK ADJ. YR _____

GPS (X) ____ TRAVERSE (X) ____

BASED ON THE FOLLOWING CONTROL:

◆ CORNER MONUMENT ○ WITNESS MONUMENT

(a)

BEARINGS ARE BASED ON: _____

WIDOT PROJECT 1390-04-92 MAR 4 2008
WIDOT NOTE: COORDINATES & BEARINGS SHOWN ON THIE PLAT ARE REFERENCED TO THE WI COUNTY COORDINATE SYSTEM, ROCK COUNTY ZONE, NAD83/97 ADJUSTMENT, THE COORDINAES SHOWN ARE GRID COORDINATES AND ARE TO BE USED AS GRID OR GROUND VALUES ON THIS PLAT

IT APPEARS THE COORDINATES ON THE WIDOT PLAT MAY BE THE VALUES THAT I PUBLISHED AND WERE NOT INDEPENDENTLY DETERMINED. THIS IS BASED ON SIMILIARTY OF THE VALUES.

S 1/4 COR SEC 26 T4N R13E MILTON 610MI

| | EASTING | NORTHING | |
|---|---|---|---|
| BARNES | 519255.224 | 301805.599 | |
| WIDOT | 519255.225 | 301805.600 | ALUM MON |

SE COR SEC 26 T4N R13E MILTON 611MI

| | EASTING | NORTHING | |
|---|---|---|---|
| BARNES | 521919.498 | 301716.904 | |
| WIDOT | 521919.499 | 301716.907 | ALUM MON |

S 1/4 COR SEC 25 T4N R13E MILTON 612MI

| | EASTING | NORTHING | |
|---|---|---|---|
| BARNES | 524566.683 | 301676.088 | |
| WIDOT | 524566.685 | 301676.089 | ALUM MON |

E 1/4 COR SEC 33 T4N R13E MILTON 617MI

| | EASTING | NORTHING | |
|---|---|---|---|
| BARNES | 511373.943 | 299450.066 | |
| WIDOT | 511373.94 | 299450.07 | CUT LIMESTONE |

Donald Barnes
10/03/08

FIELD BOOK _____ PAGE # _____ SHEET 1 OF 1

SHOW A PLAN VIEW DRAWING DEPICTING THE CORNER MONUMENT AND SURROUNDING PHYSICAL FEATURES, INCLUDING THE EXCAVATION AREA AND DEPTH.

PLANNING & ZONING COMMITTEE ADOPTED THIS FORM ON 12/2/1982

V #-23(3)

CORNER CODE _____