Paper weight ___ (minimum) _____ Black non_____ required

U.S. PUBLIC LAND SURVEY MONUMENT RECORD

For Public Land Survey Corners in:

T. 1 N., R. 12 E

WI ADMINISTRATIVE CODE A-E 7.08 REQUIREMENT

CORNER CODE INDEX

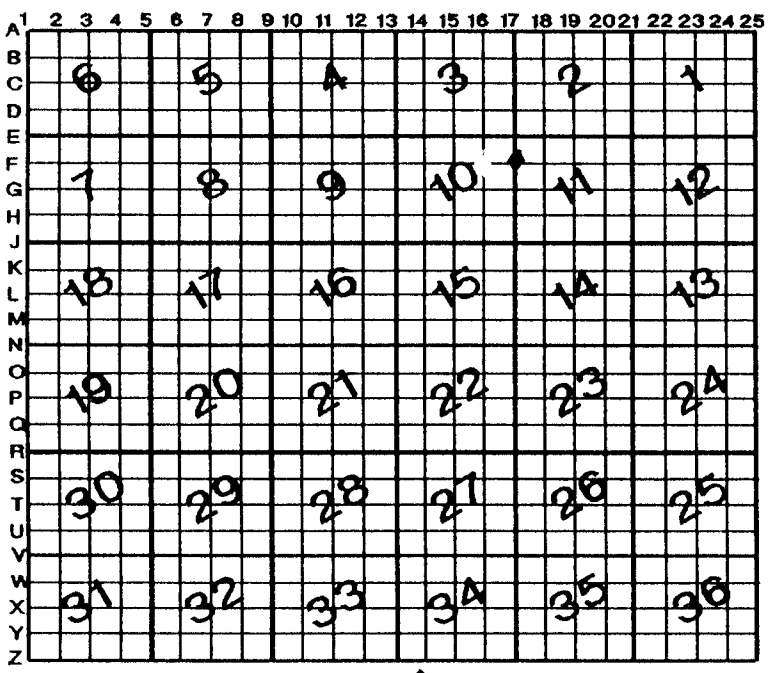

PLACE MONUMENT SYMBOL ◆ AT PROPER LOCATION ON ABOVE INDEX

BELOIT TWP

ROCK COUNTY WI

IF AVAILABLE
ROCK COUNTY COORDINATES PERFERRED

North 226,269.48 Elev. _____

East 485,713.09

Hor. Datum _____ Vert. Datum _____

LATITUDE _____ ELLIPS. HT.

LONGITUTE _____ _____

GPS (X) ___ TRAVERSE (X) ___

BASED ON THE FOLLOWING CONTROL:

◆CORNER MONUMENT ○ WITNESS MONUMENT

(a)

BEARINGS ARE BASED ON: _____

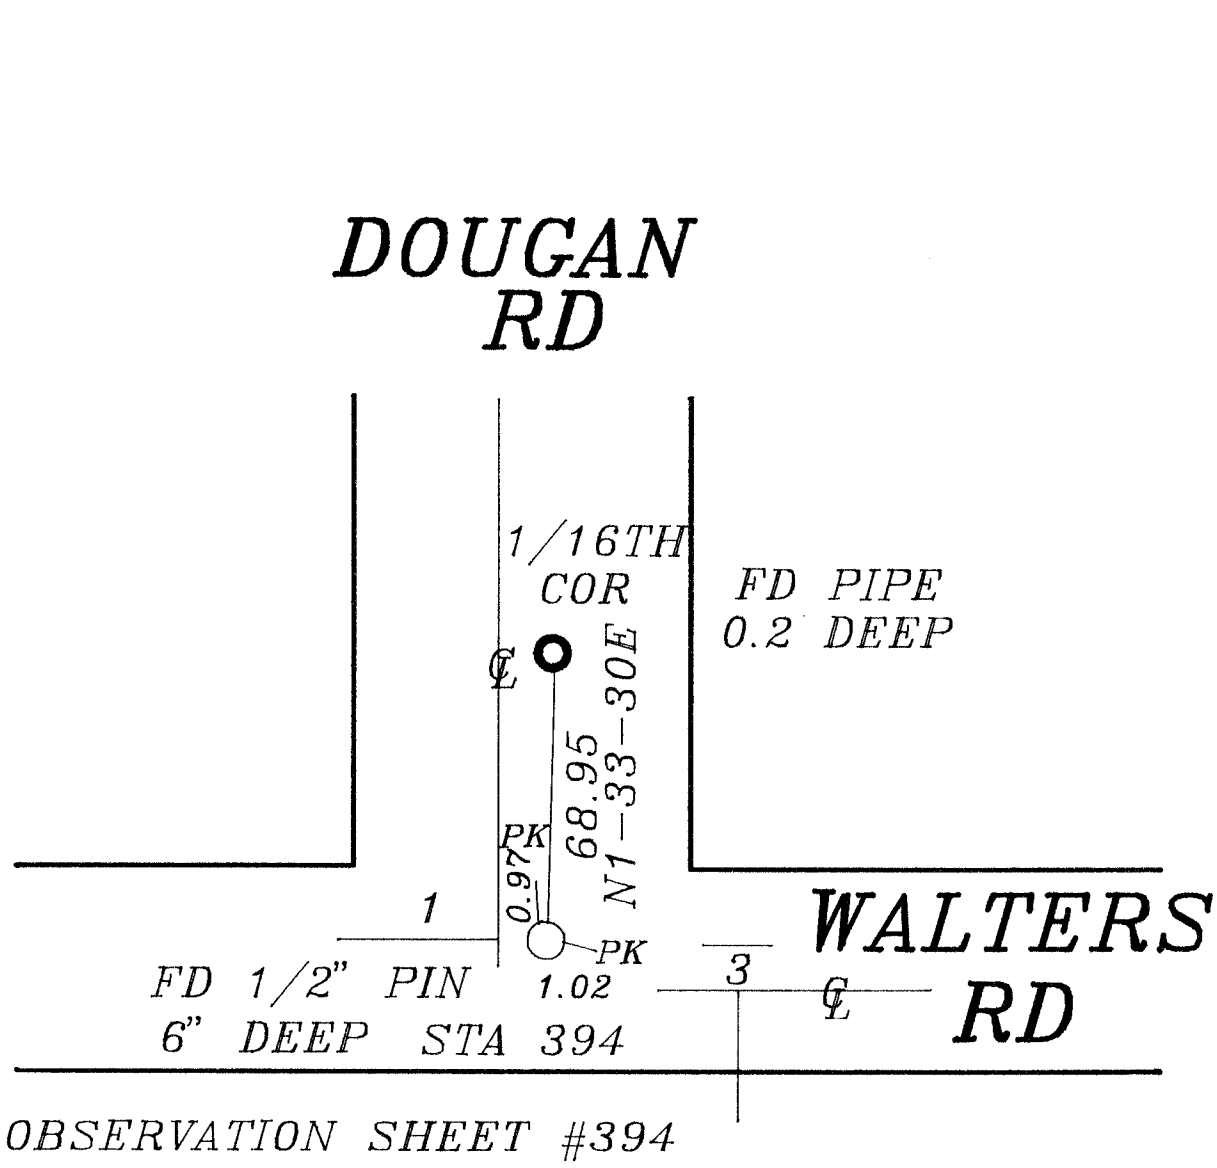

Donald Barnes
2/4/98

FIELD BOOK _____ PAGE # _____ SHEET ____ OF ____

SHOW A PLAN VIEW DRAWING DEPICTING THE CORNER MONUMENT AND SURROUNDING PHYSICAL FEATURES, INCLUDING THE EXCAVATION AREA AND DEPTH.

PLANNING & ZONING COMMITTEE ADOPTED THE ABOVE FORM ON 12/2/1982

CORNER CODE F 17