100

PAG 199 JANESVILLE
REC 12/15/75
DAB

PLAT AND RECORD

N.E.¼

Of a Survey on Section 9 T 4N. R 12 E. of the 4 P. M. in Fulton Township

Rock County, Wisconsin, made May the 15, 1931

I hereby certify that the following is a correct record of said survey as made by me.

COUNTY BUILDING
IN CITY OF BELOIT
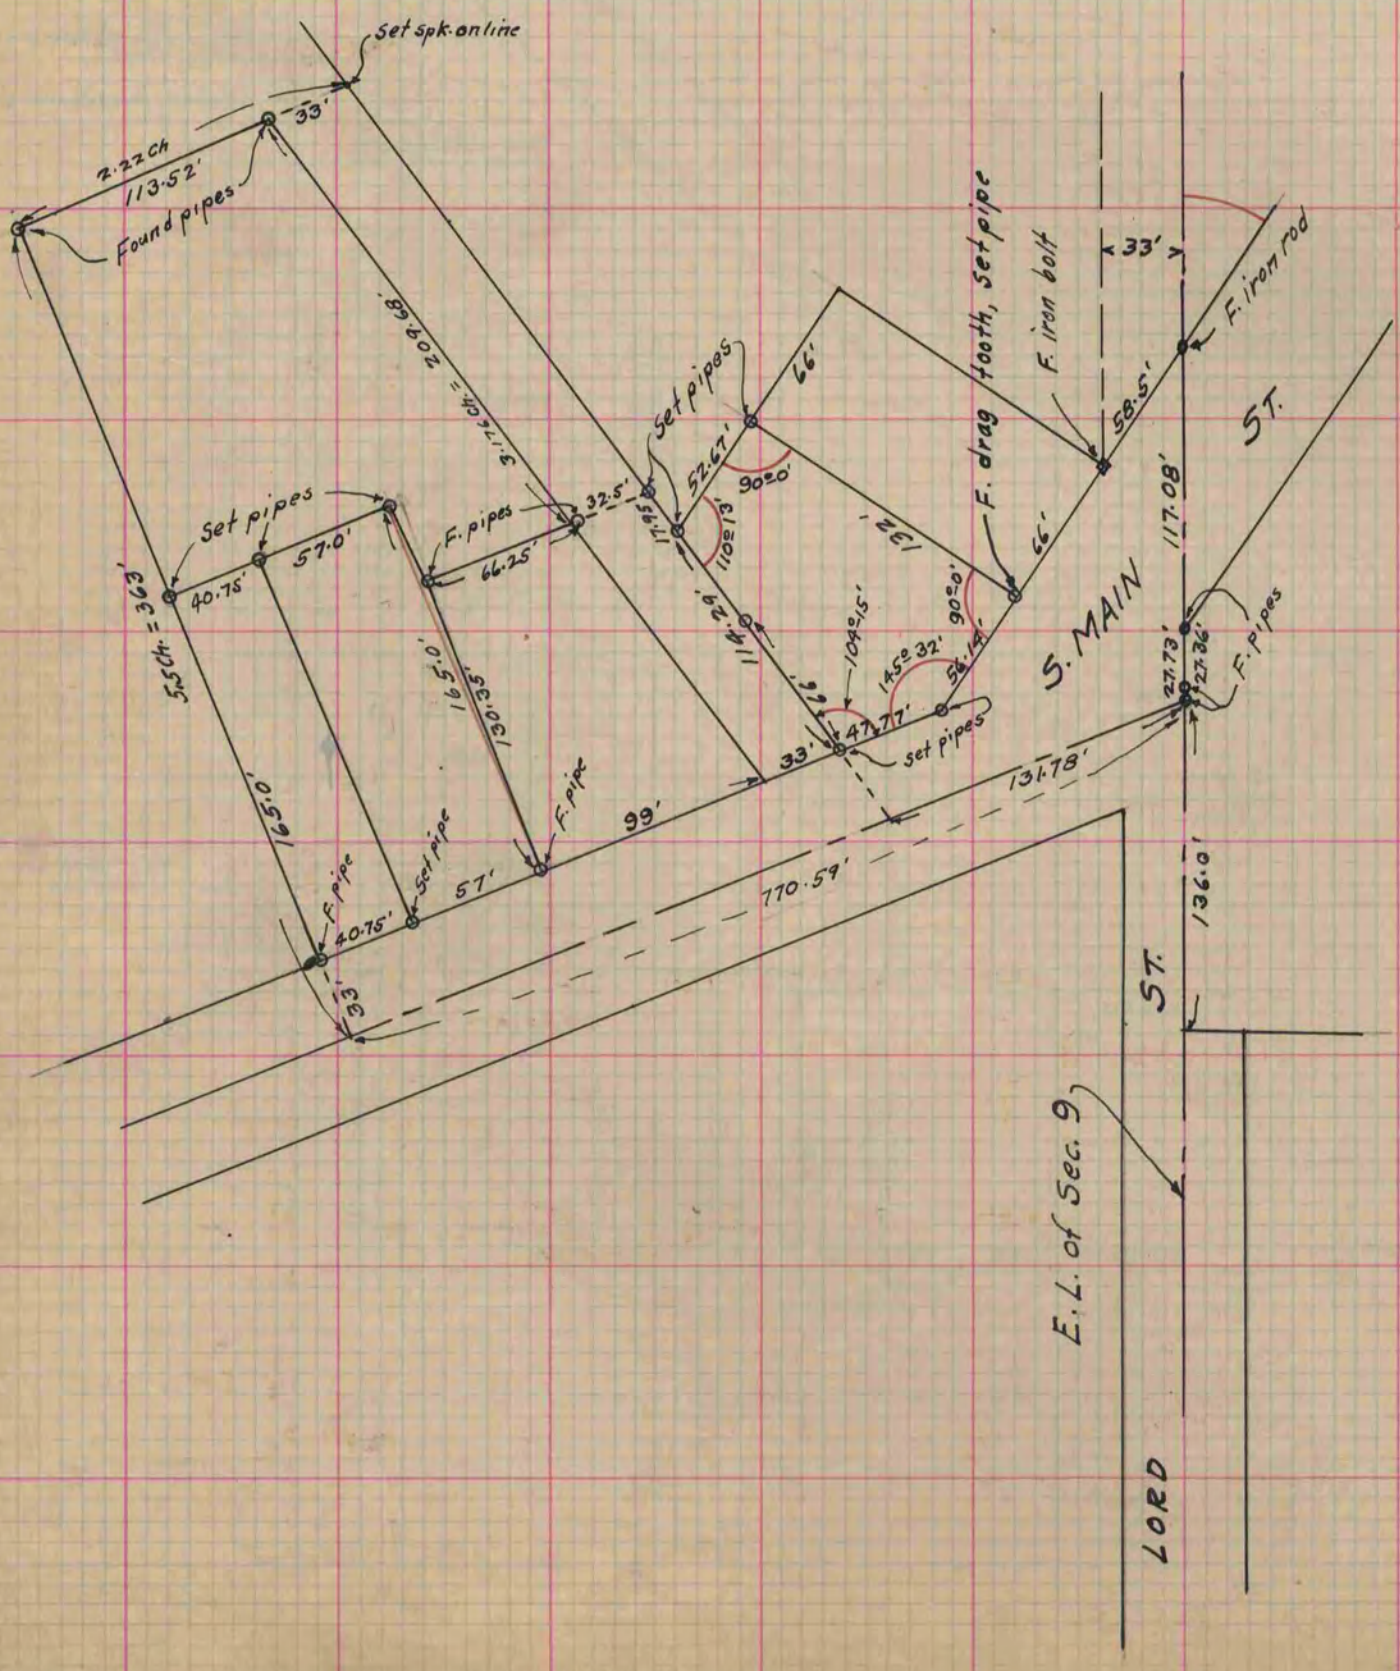
B. J. Bunny
County Surveyor.