PLAT AND RECORD

Of a Survey on Section 2 / 35 T 3 / 4 R 11 / 11 E. of the 4 P. M. in Center / Porter Township

Rock County, Wisconsin, made May the 23rd 1883

I hereby certify that the following is a correct record of said survey as made by me.


(Signed) Edward Ruger
County Surveyor.

35

T. 4 N. & 11 E

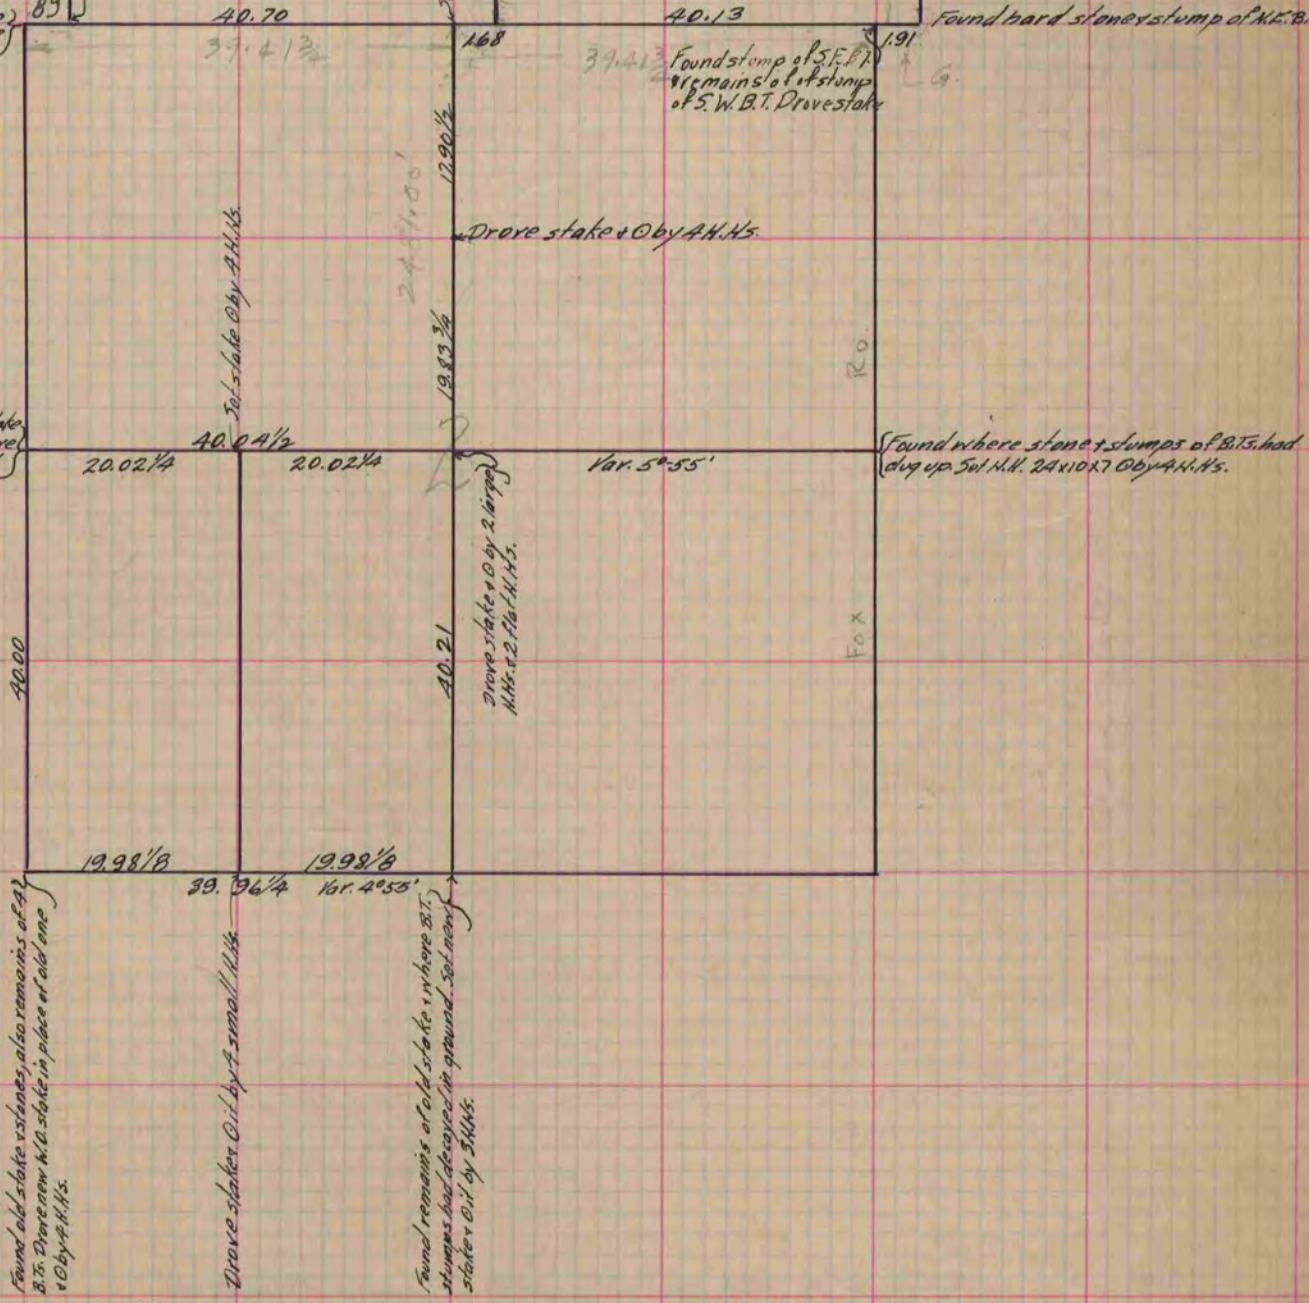

Copied From P. 333 Vol. 2 County Surveyor's Record.