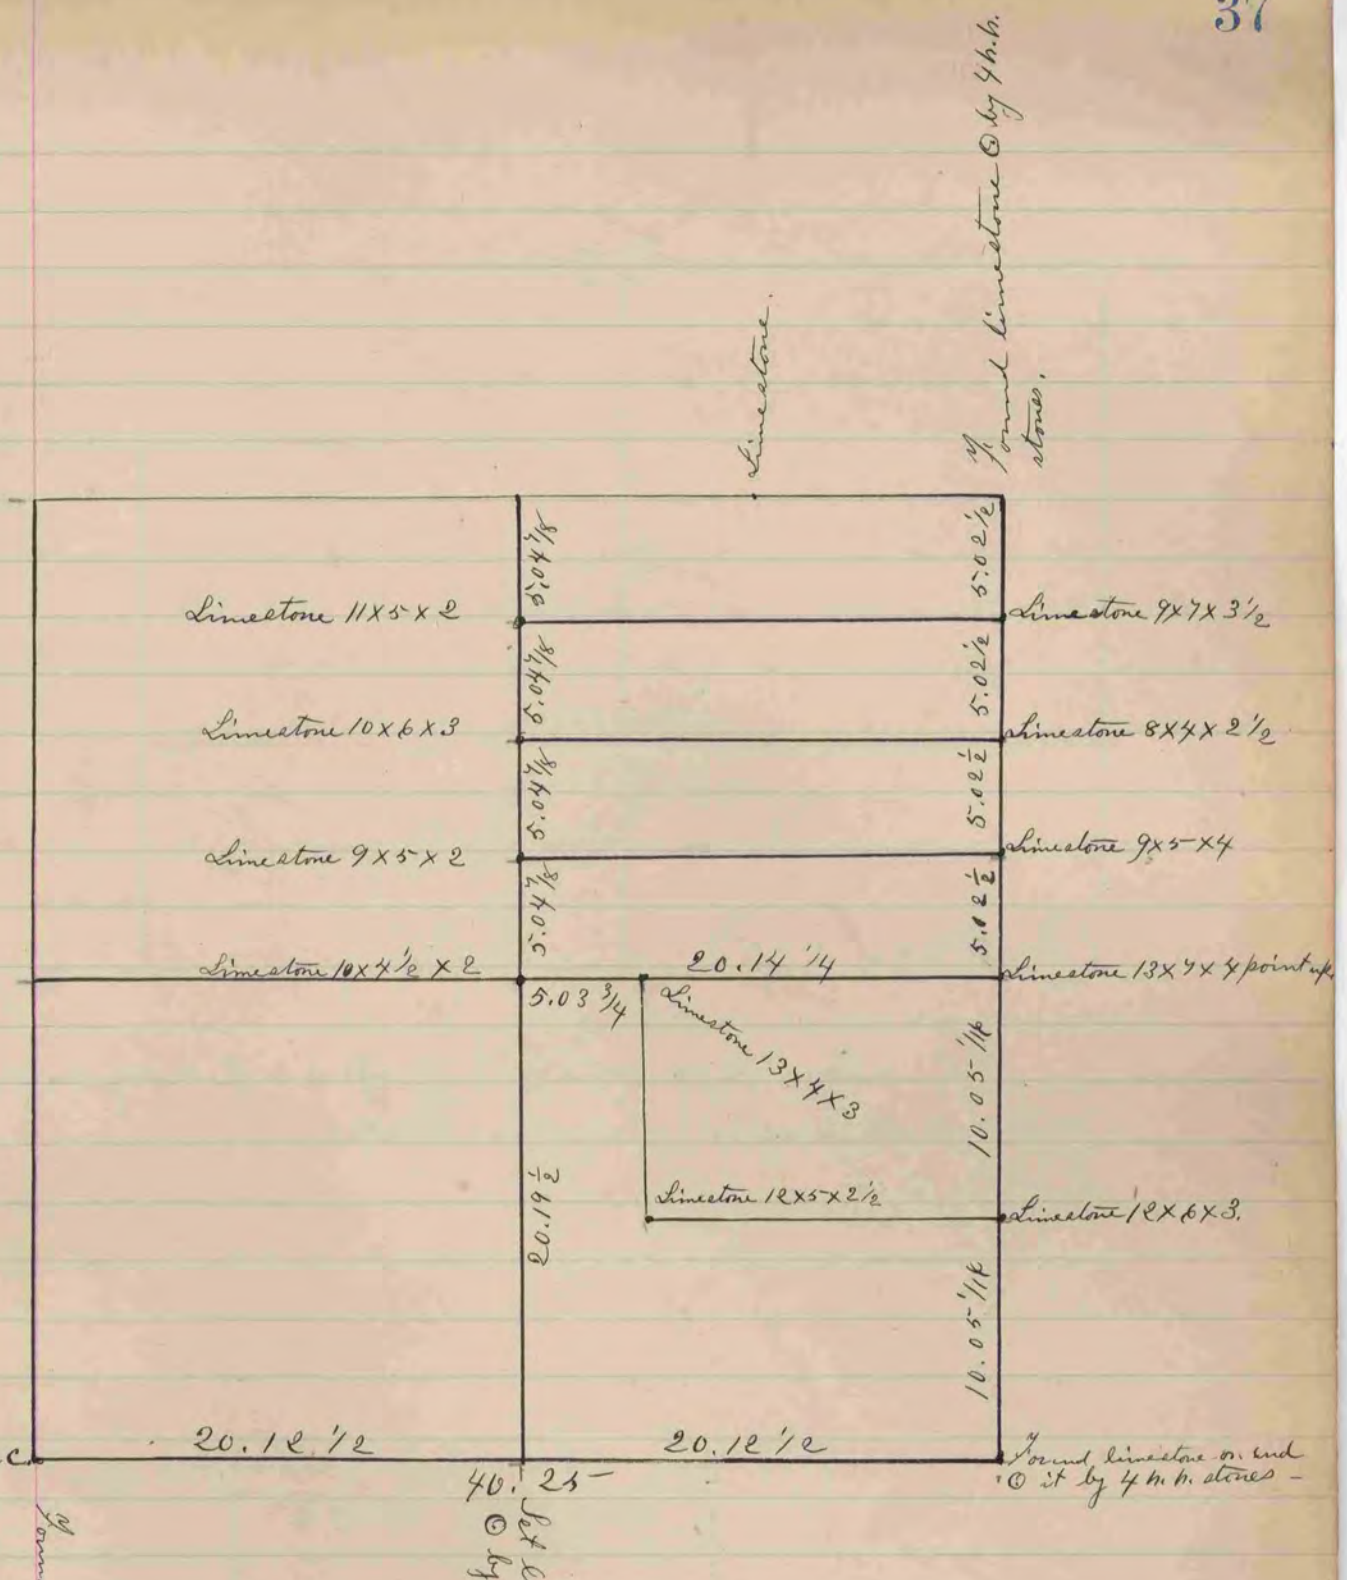

The above is a record & plat of a survey made by me on N. E 1/4 of Sec. 34 Janesville March 31, 1882.

COUNTY SURVEYOR
RECORD 1859-1906