Twp N 3 N. Range 9 East - Surveyed and and staked out a 3 rods wide road on the east side of the N. E. 1/4 of Sec. 23. T. 3 R. 9. Drove stakes every 10.00 chains on each side of said road -

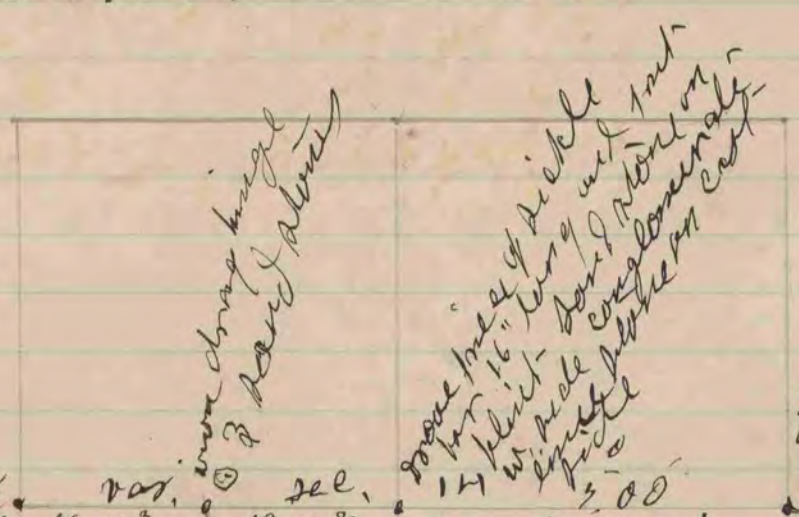

The above is a record and plat of a survey made by me on Section 14 & 23, Town 3 Range 9 - August 1st & 4th - 1905

Edward Ruger Surveyor.

Ref field book 136 pages 3rd & 4th inclusive, also book 142 pages 199 & 201

COUNTY SURVEYOR
RECORD 1859-1906