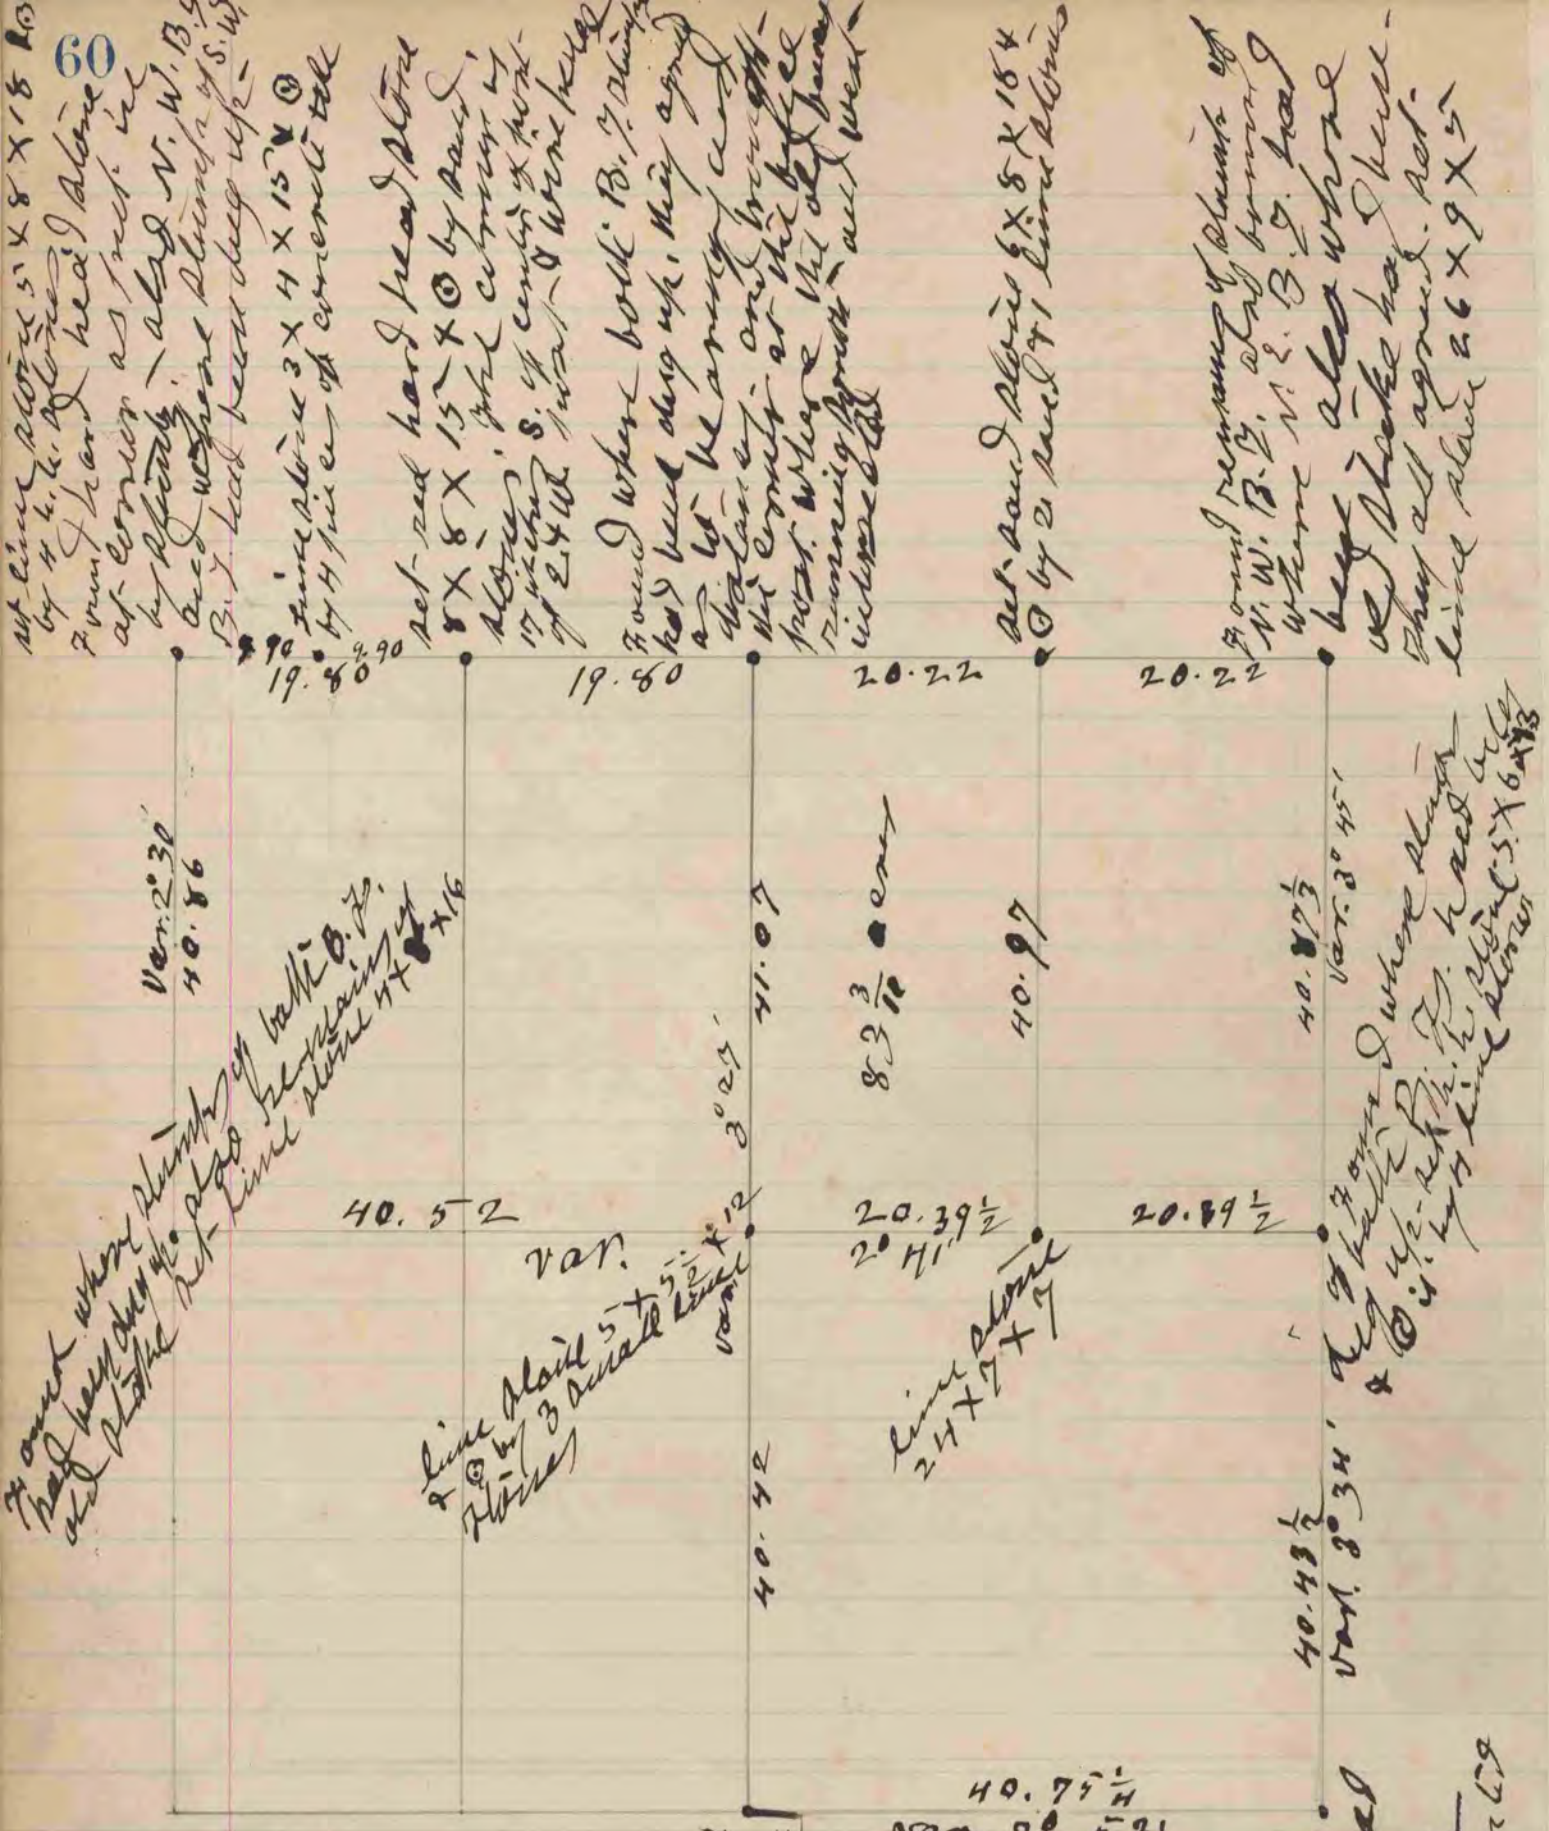

The above is a record on plat of a survey made by me on Section 10 Exeter. May 18 to 20 inclusive, 1904

Edward Rieger
Surveyor

See field book 148, pages 130 to 146 inclusive also field book 153. page 16

COUNTY SURVEYOR
RECORD 1859-1906