80

PLAT AND RECORD

Of a Survey on Section 30 T 4 R 14 E. of the 4 P. M. in Lima Township

Rock County, Wisconsin, made November the 24+25 1871

I hereby certify that the following is a correct record of said survey as made by me.

COUNTY BUILDING
IN CITY OF BELOIT

(Signed) Edward Ruger.
C.R.C.
County Surveyor.

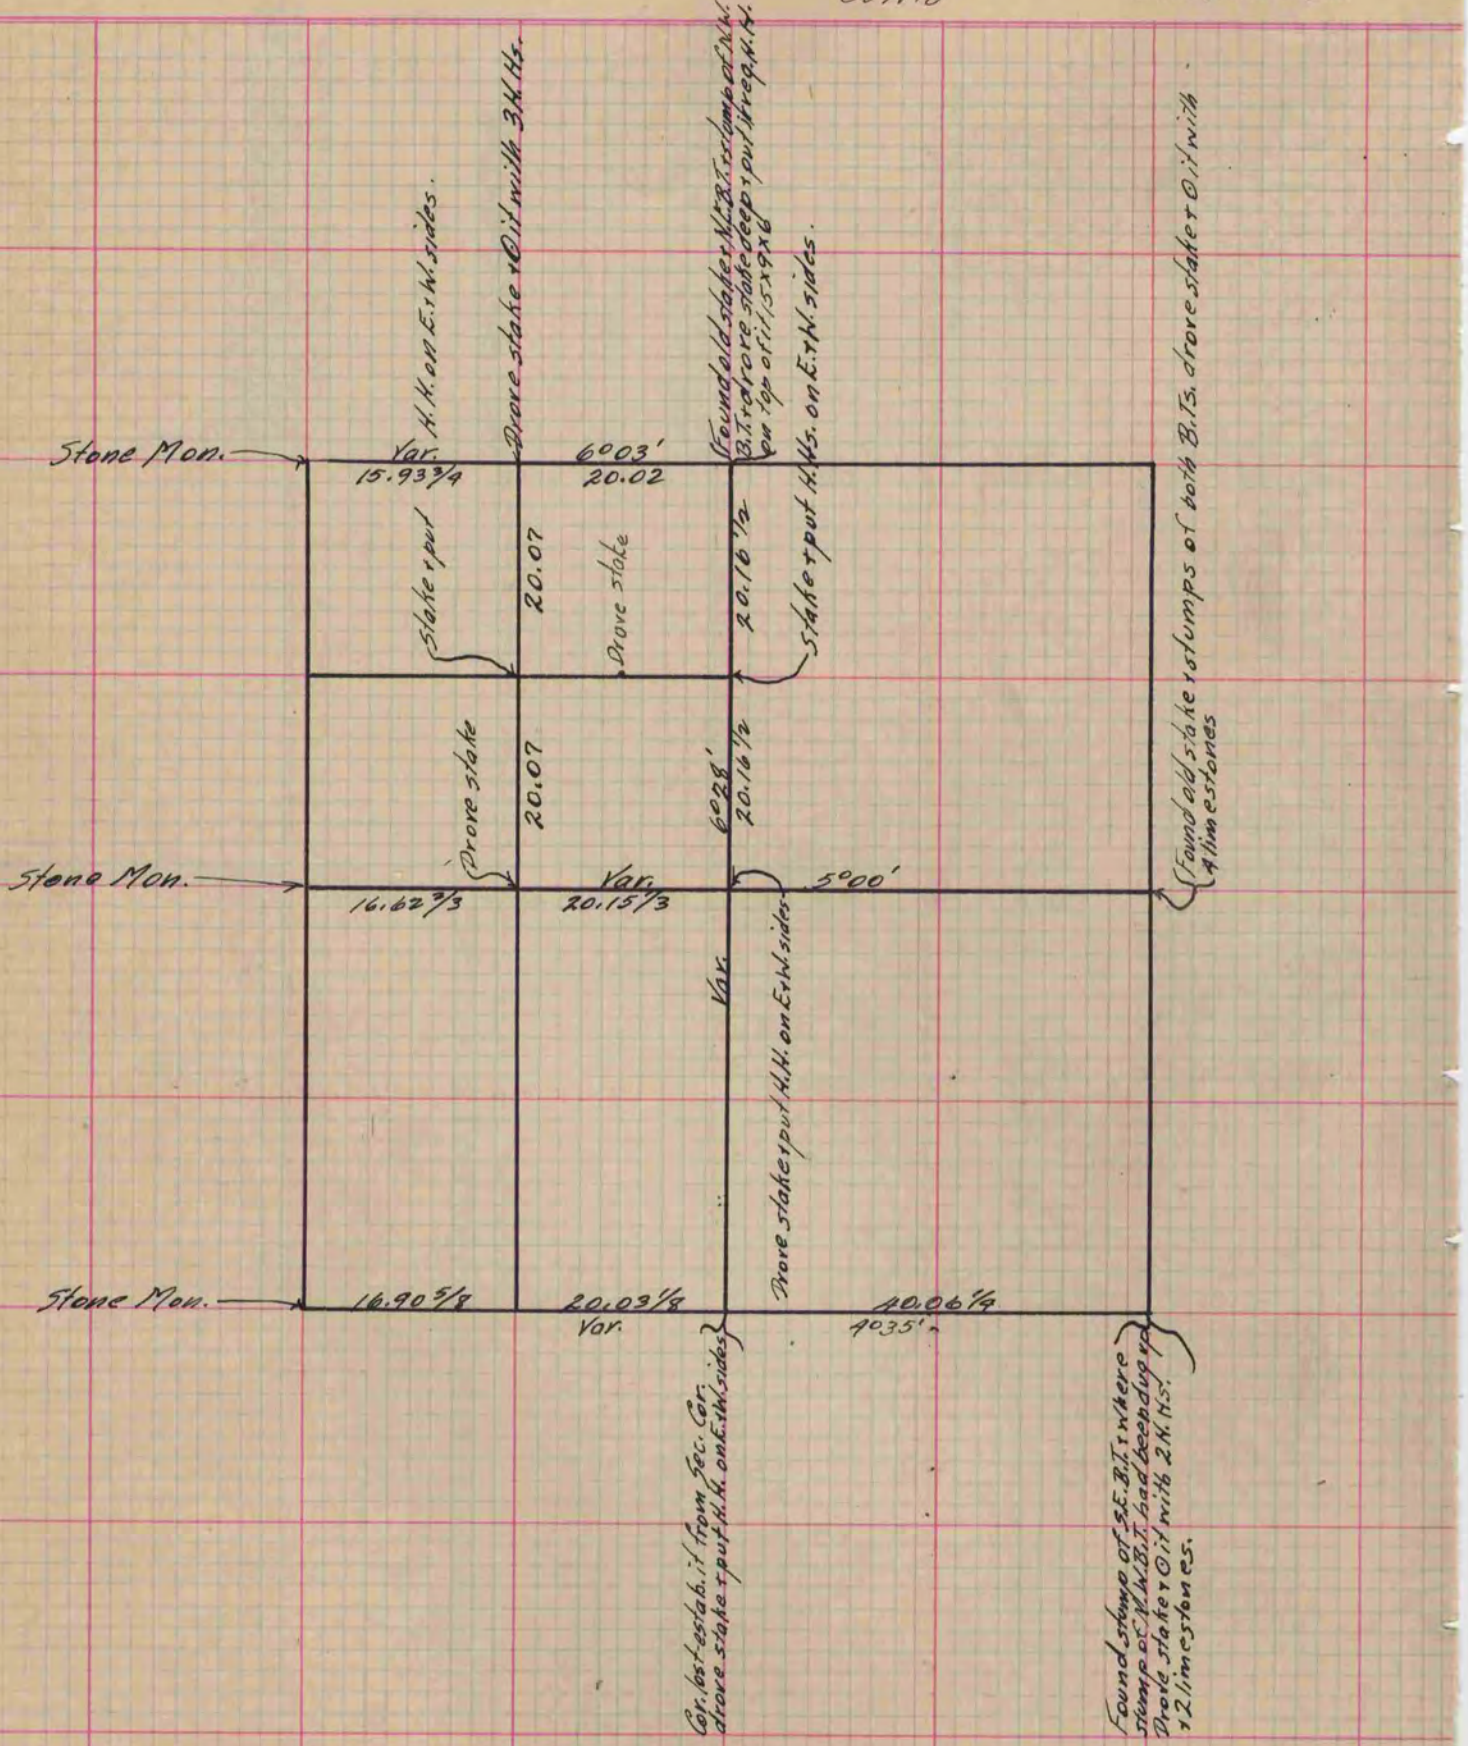

Copied from Page 47 Vol. 2 Original County Surveyor's Record.