# PLAT AND RECORD

89

Of a Survey on Section 9 T 4 R 12 E. of the 4 P. M. in Fulton Township

Rock County, Wisconsin, made December the 16th & 23rd 1872

I hereby certify that the following is a correct record of said survey as made by me.

COUNTY BUILDING
IN CITY OF BELOIT

(Signed) R.K. Lee
ARB
{Deputy County Surveyor.

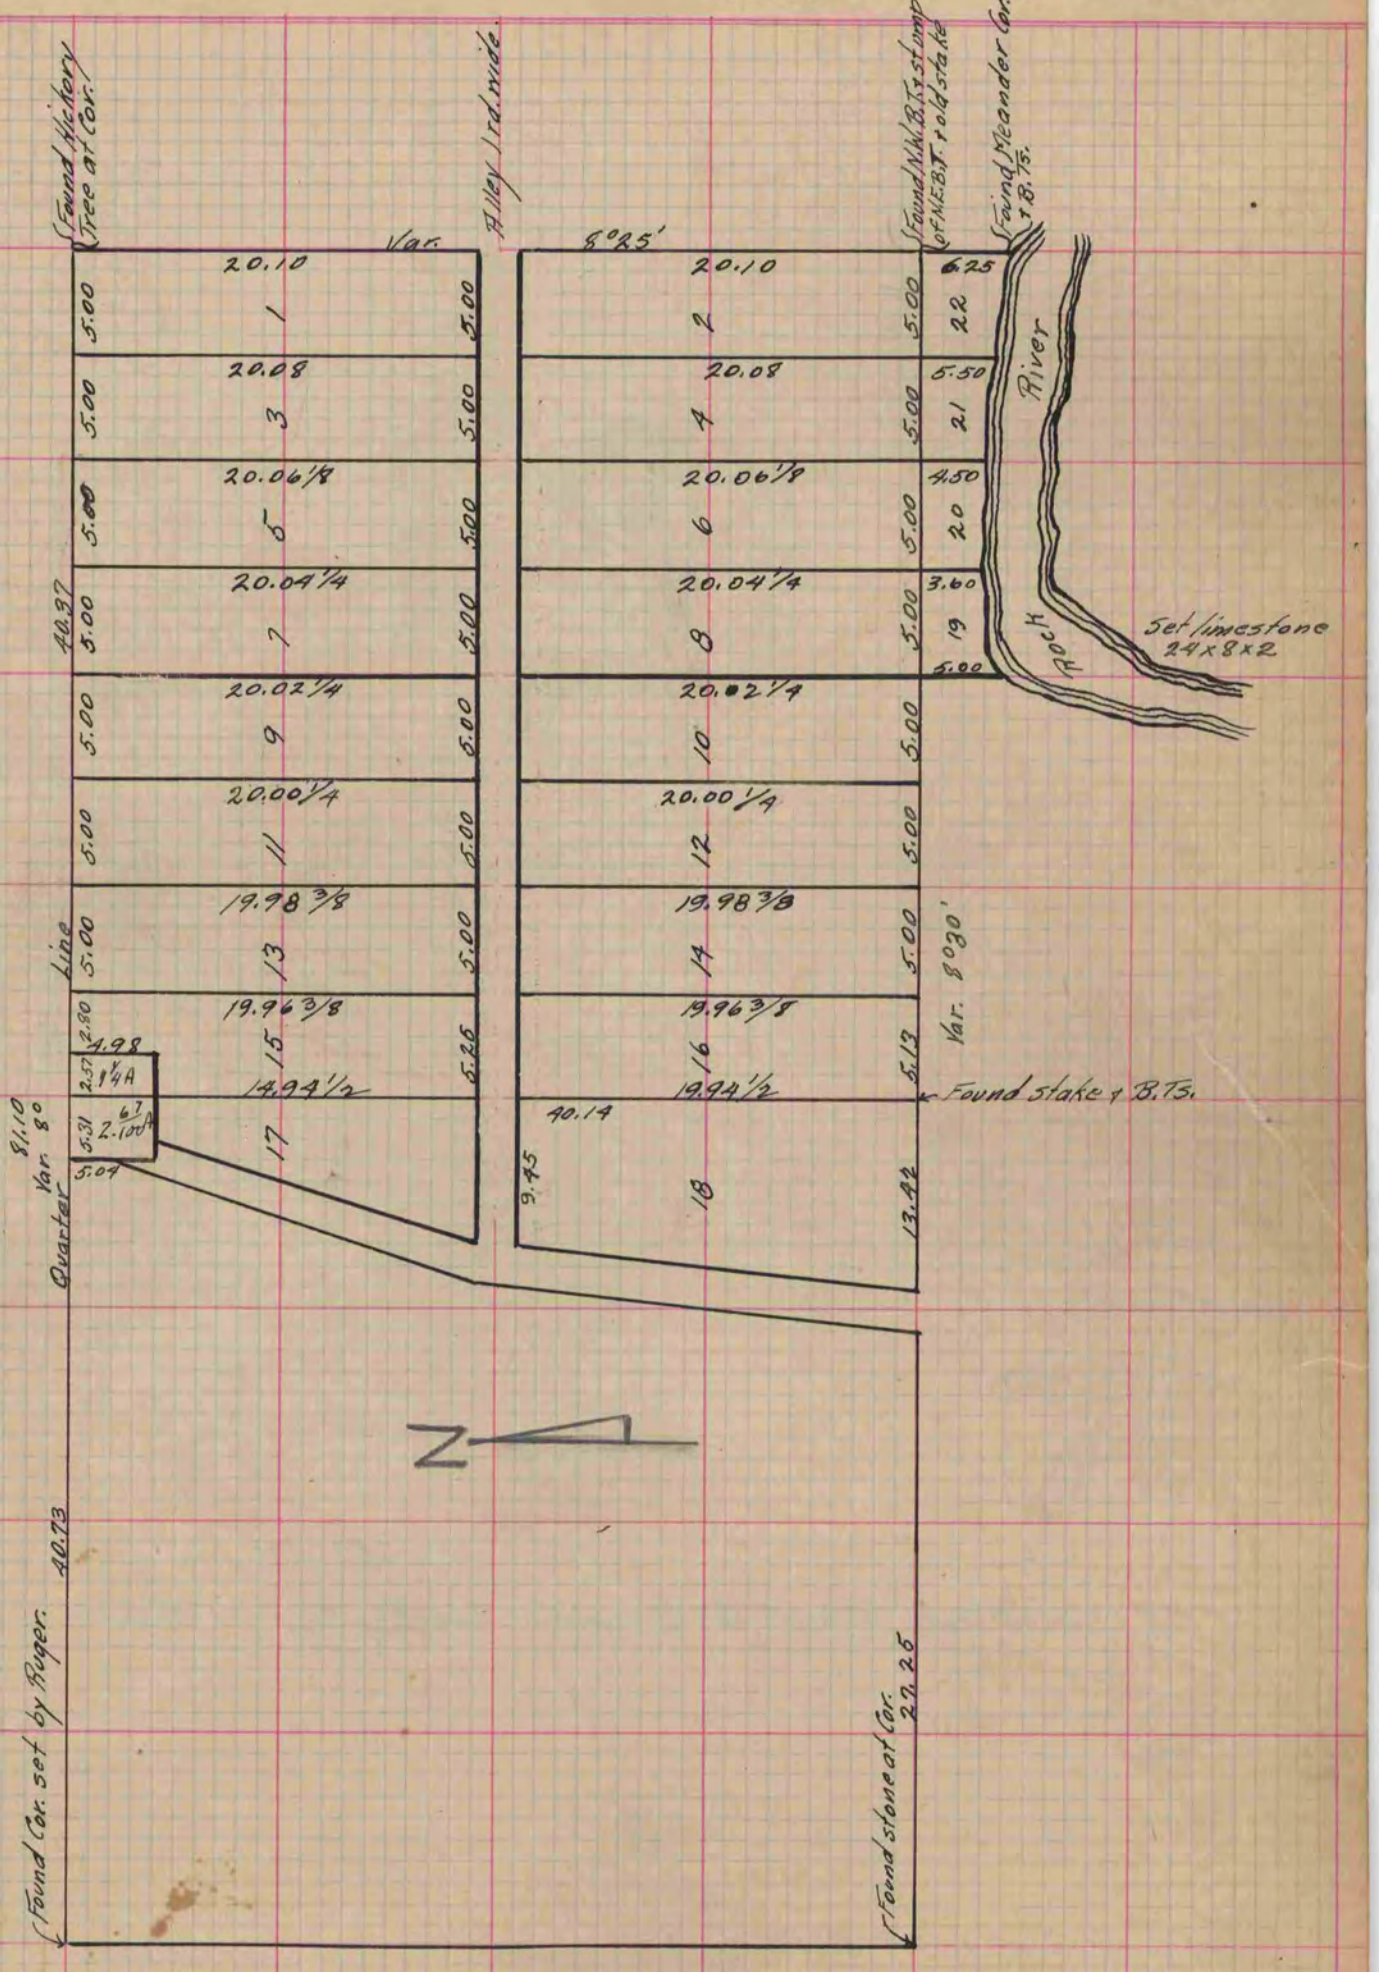


Copied from Page 54 Vol. 2. Original County Surveyor's Record.