PLAT AND RECORD

Of a Survey on Section 29 T 4 R 11 E. of the 4 P. M. in Porter Township

Rock County, Wisconsin, made June the 6-7+8 1871

I hereby certify that the following is a correct record of said survey as made by me.

COUNTY BUILDING
IN CITY OF BELOIT

(Signed) Edward Ruger
RAB
County Surveyor.

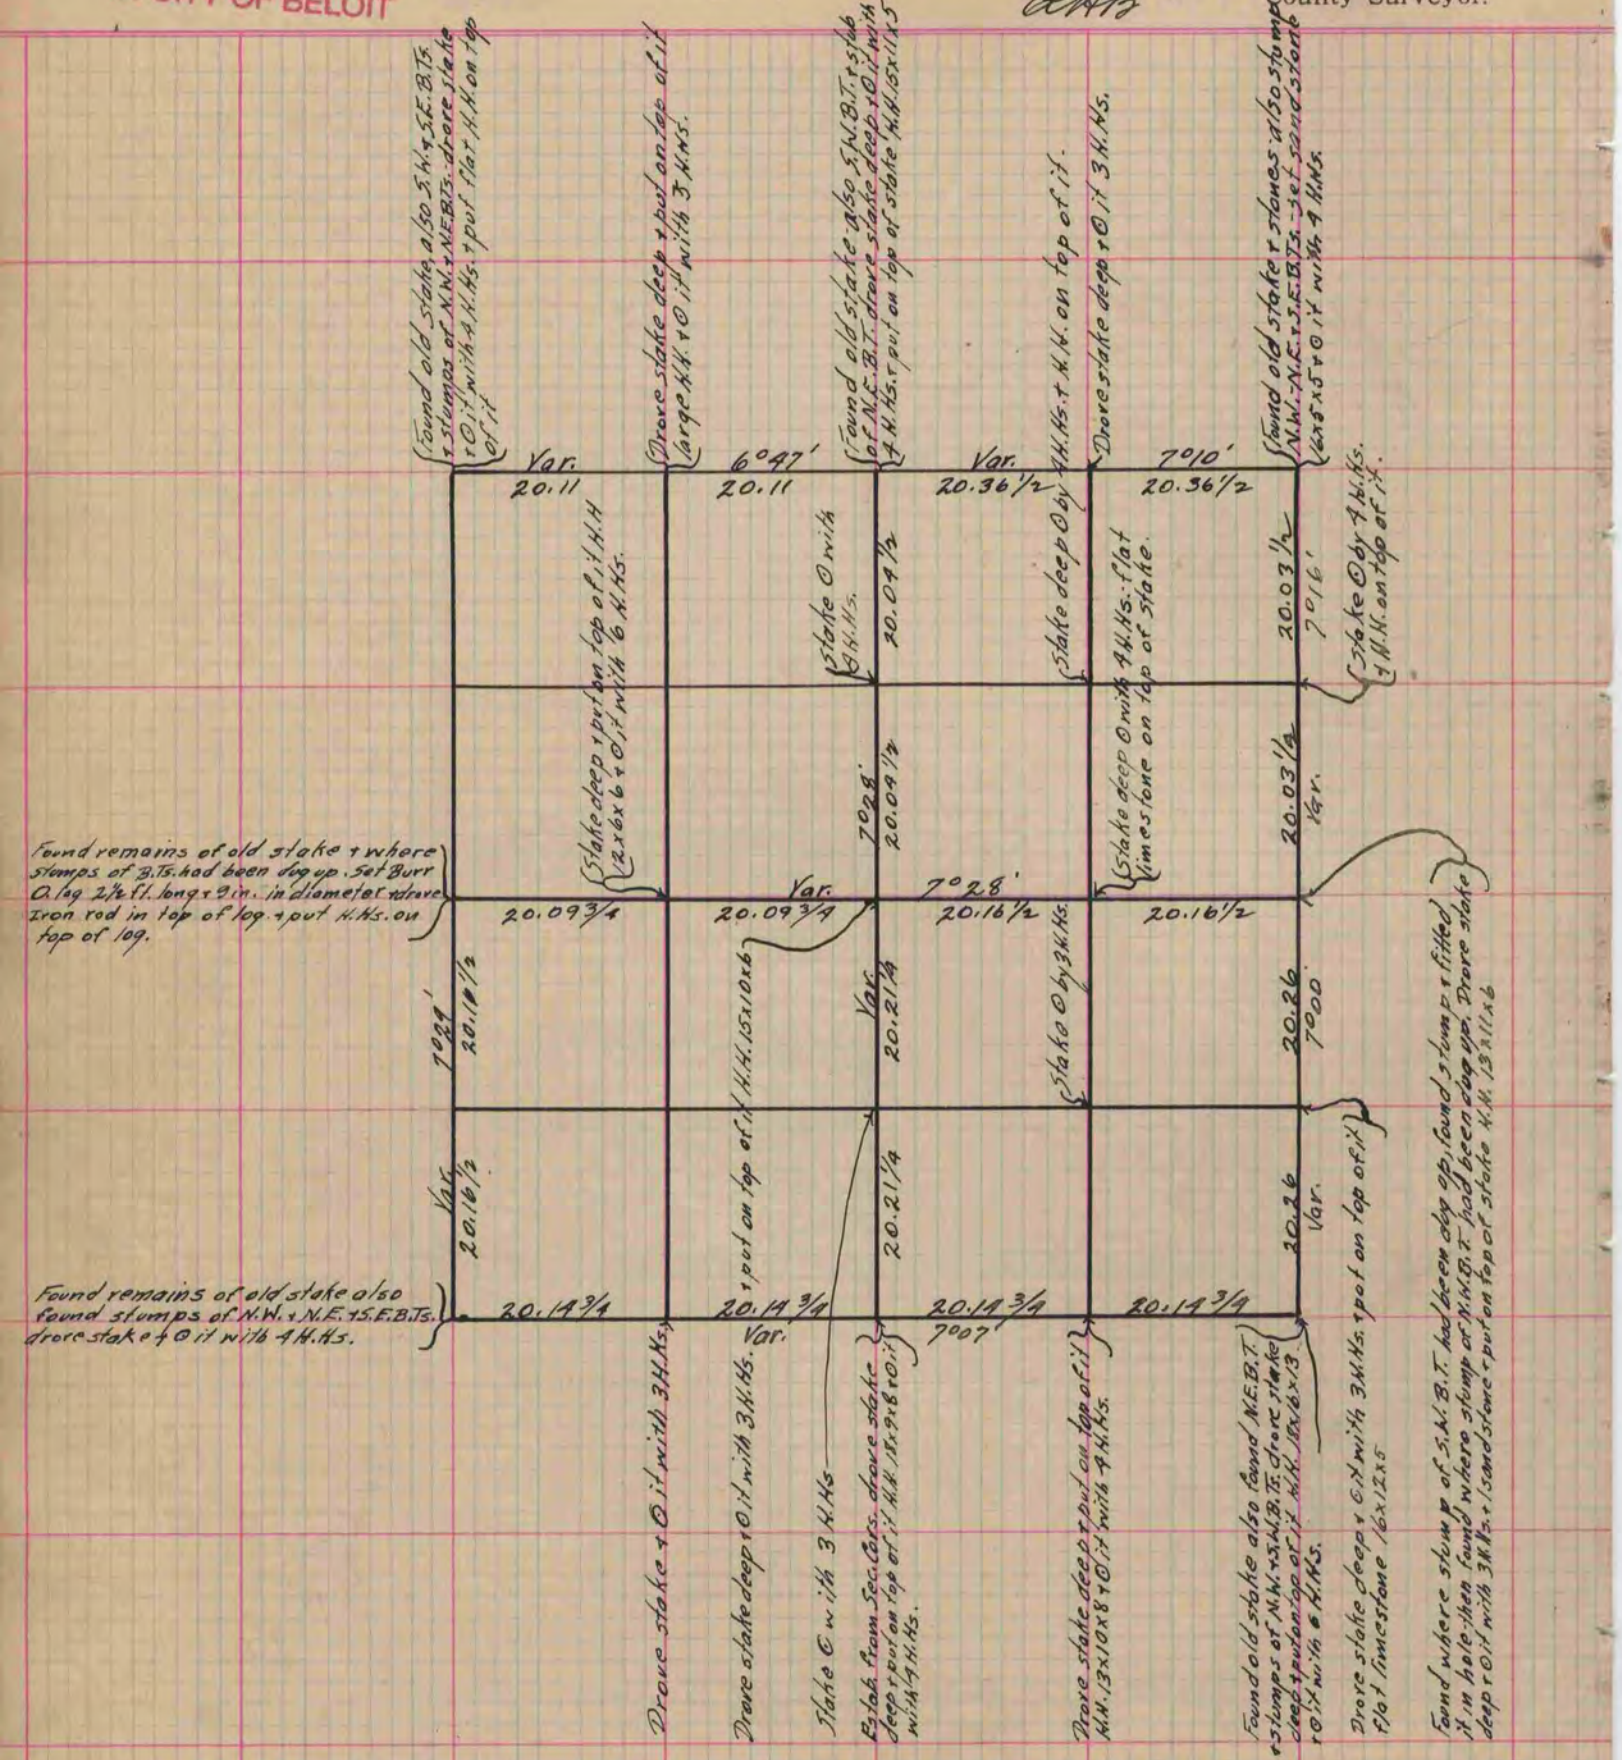

Copied from Lower ½ Page 41 Vol. 2 Original County Surveyor's Record.