36

PLAT AND RECORD

Of a Survey on Section 36 T 3 R 10 E. of the 4 P. M. in Magnolia Township

Rock County, Wisconsin, made July the 8th & 9th 1870

I hereby certify that the following is a correct record of said survey as made by me.

COUNTY BUILDING
IN CITY OF BELOIT

(Signed) Edward Ruger {Deputy County Surveyor.
R.H.B.

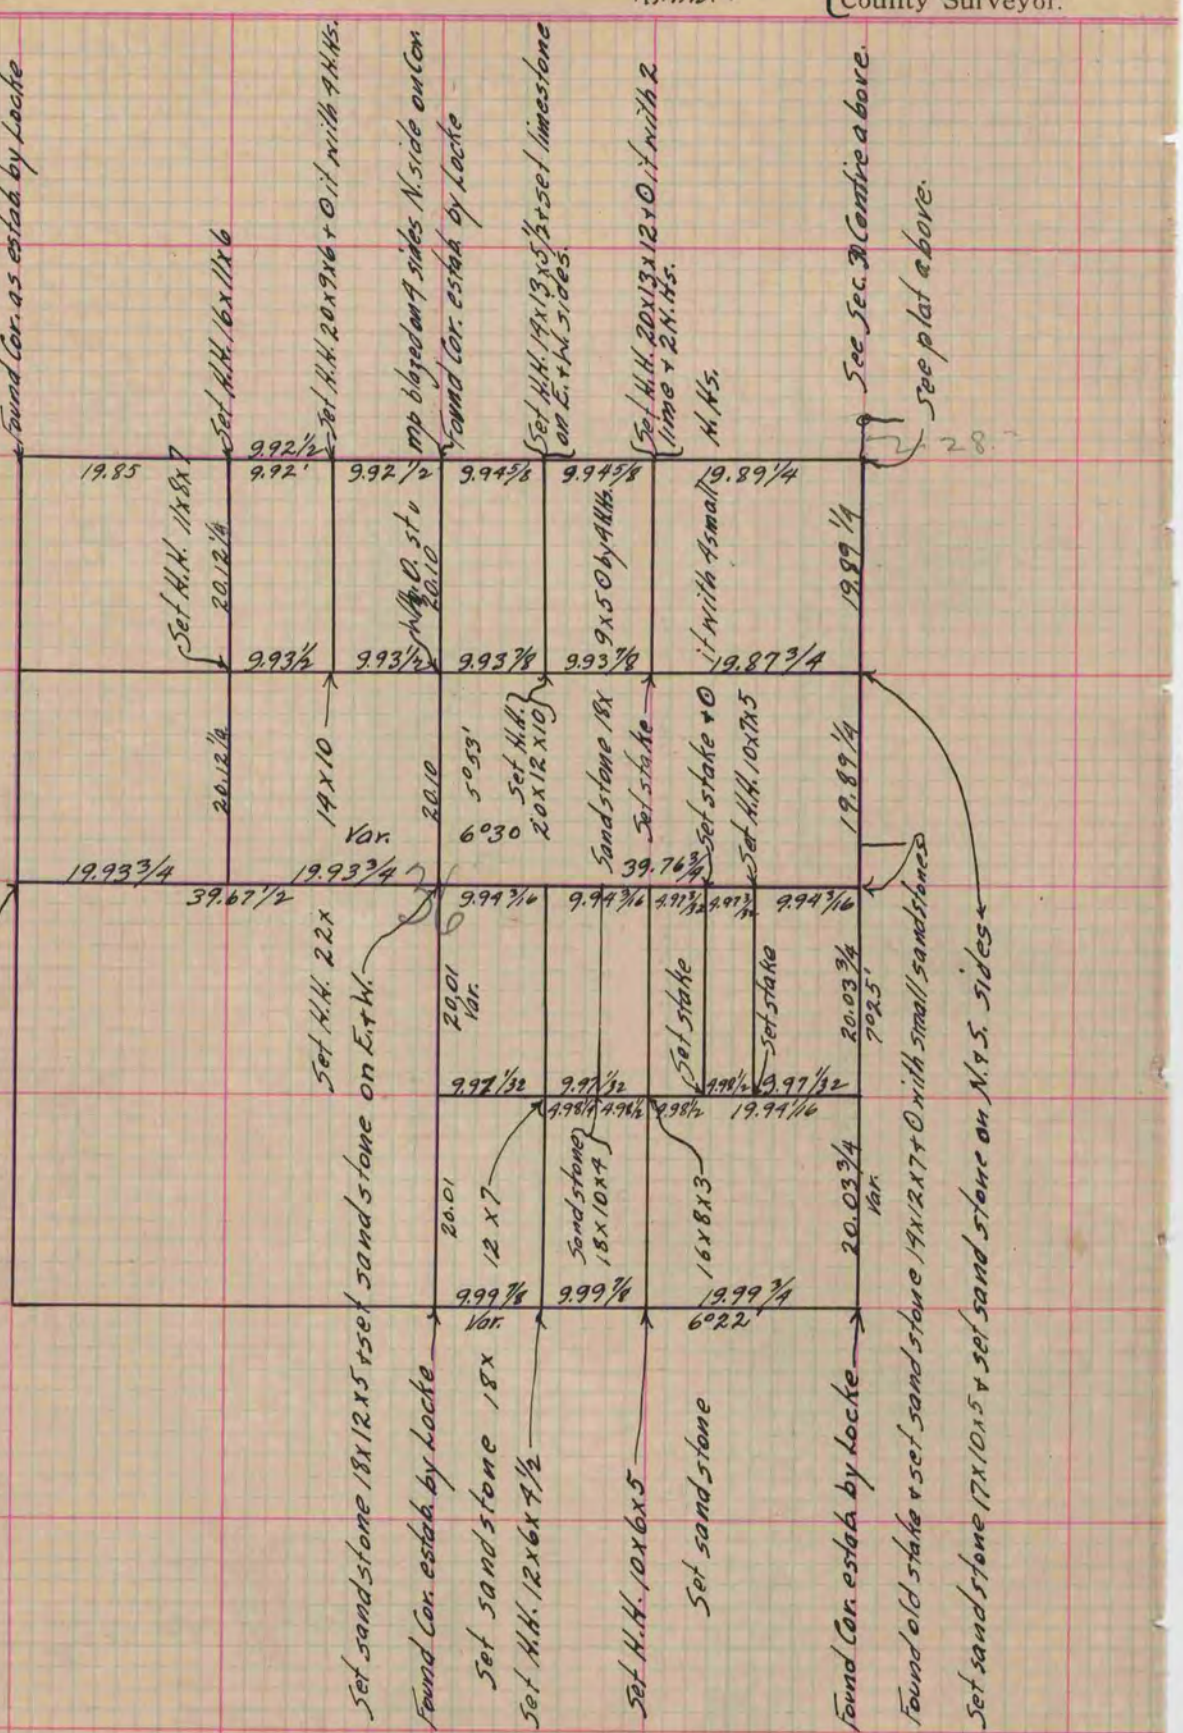

Copied from lower 1/2 P. 25 Vol. 2 Original County Surveyor's Record.