412

PLAT AND RECORD

Of a Survey on S.W. 1/4 Section 4 T 4 R 12 E. of the 4 P. M. in Fulton Township

Rock County, Wisconsin, made May the 29th 1883

I hereby certify that the following is a correct record of said survey as made by me.

COUNTY BUILDING
IN CITY OF BELOIT

(Signed) Edward Ruger
County Surveyor.

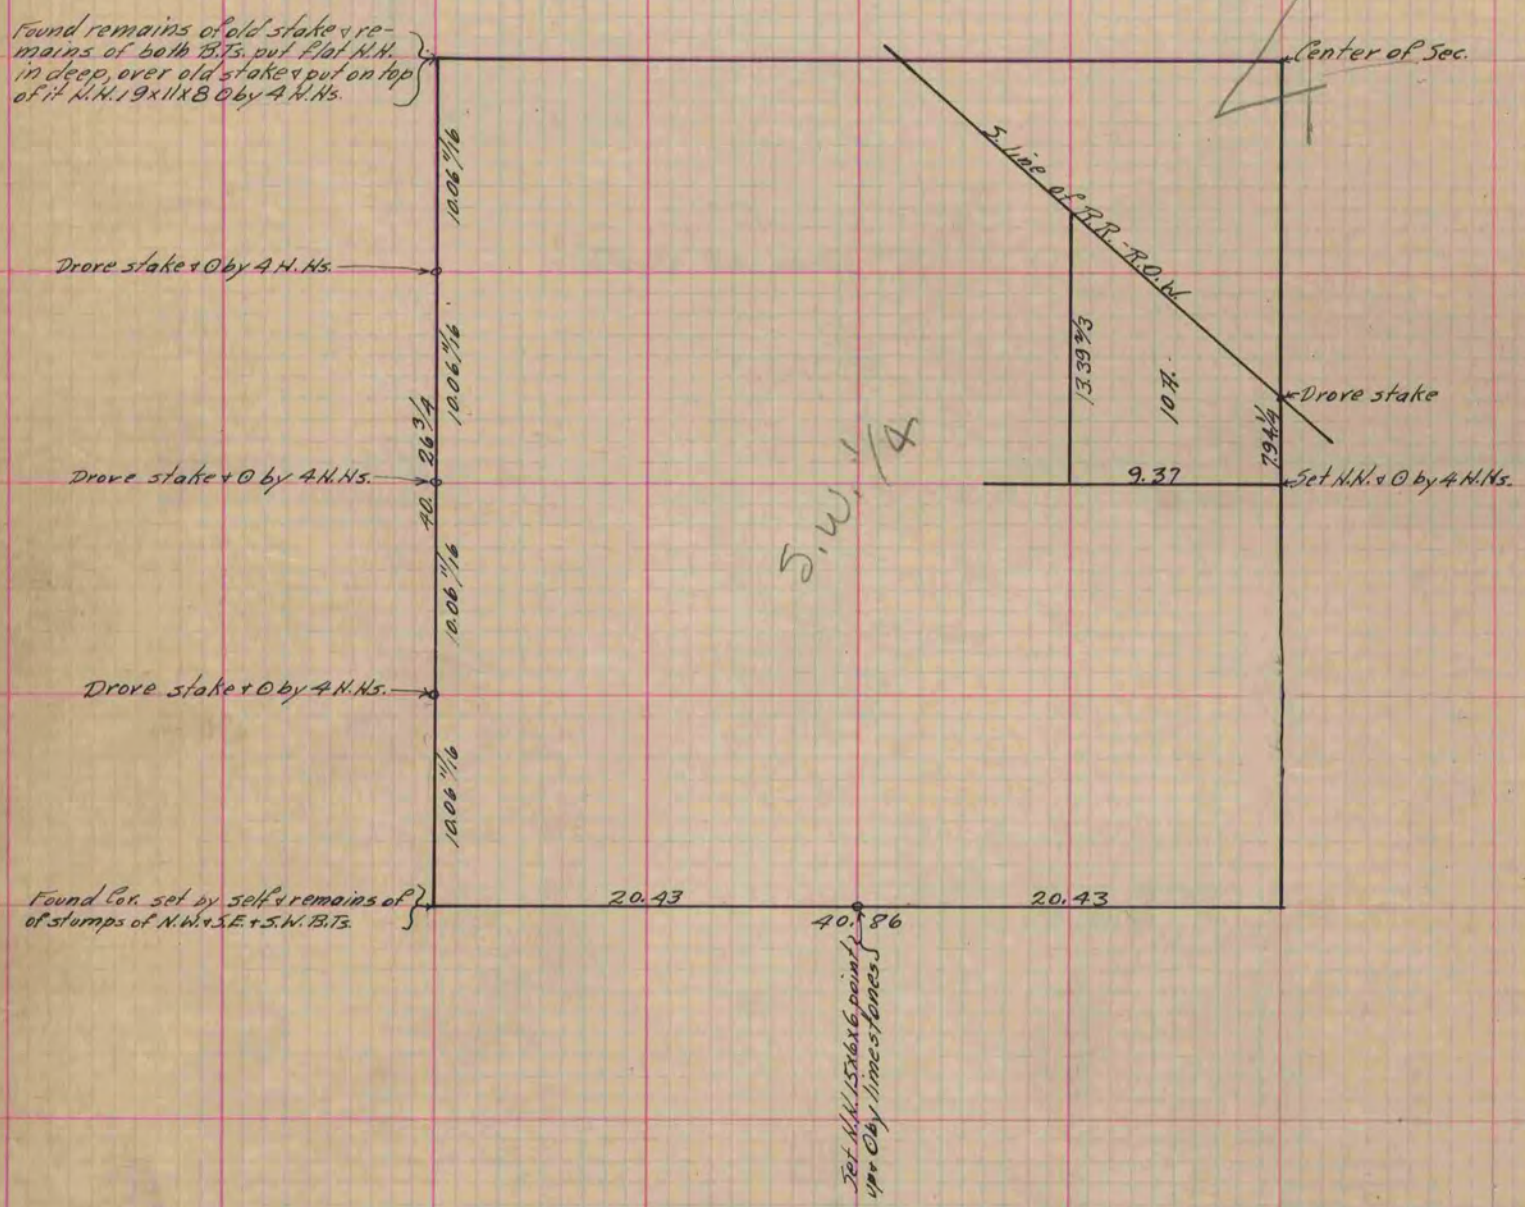

Copied from P. 334 Vol. 2 County Surveyor's Record.