PLAT AND RECORD

Of a Survey on Section 31 T 4 R 10 E. of the 4 P. M. in Union Township

Rock County, Wisconsin, made Oct. the 24 & 25 1890

I hereby certify that the following is a correct record of said survey as made by me.


(Signed) O. G. Bleecborn
Dep. County Surveyor.

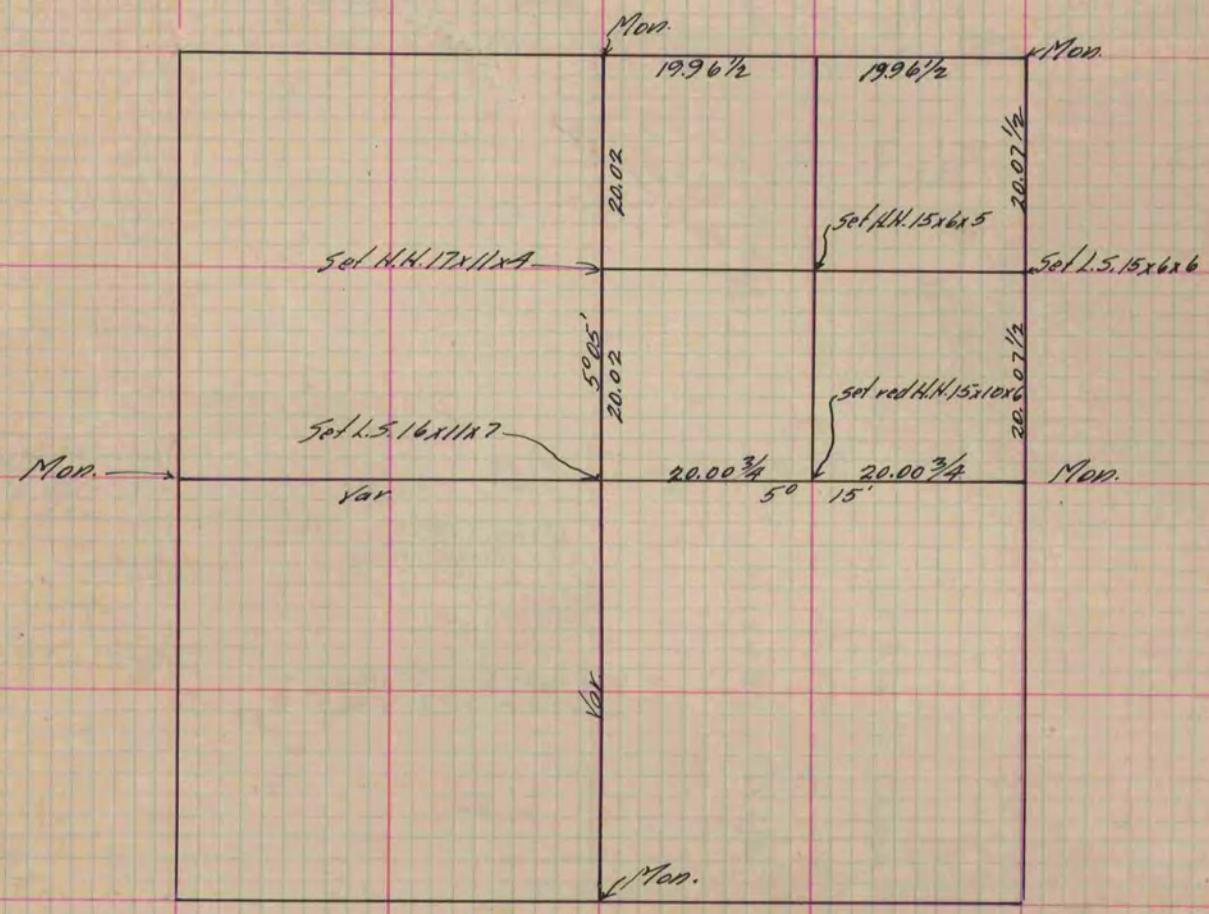

Copied from P. 352 Vol. 2 County Surveyor's Record.