PLAT AND RECORD

Of a Survey on Sections 34+35 T 2 R 11 E. of the 4 P. M. in Plymouth Township

Rock County, Wisconsin, made January the 8+9 1874

I hereby certify that the following is a correct record of said survey as made by me.

Re-survey of a Highway + the Alteration of a portion of it.

(Signed) Edward Ruger
County Surveyor.

COUNTY BUILDING
IN CITY OF BELOIT

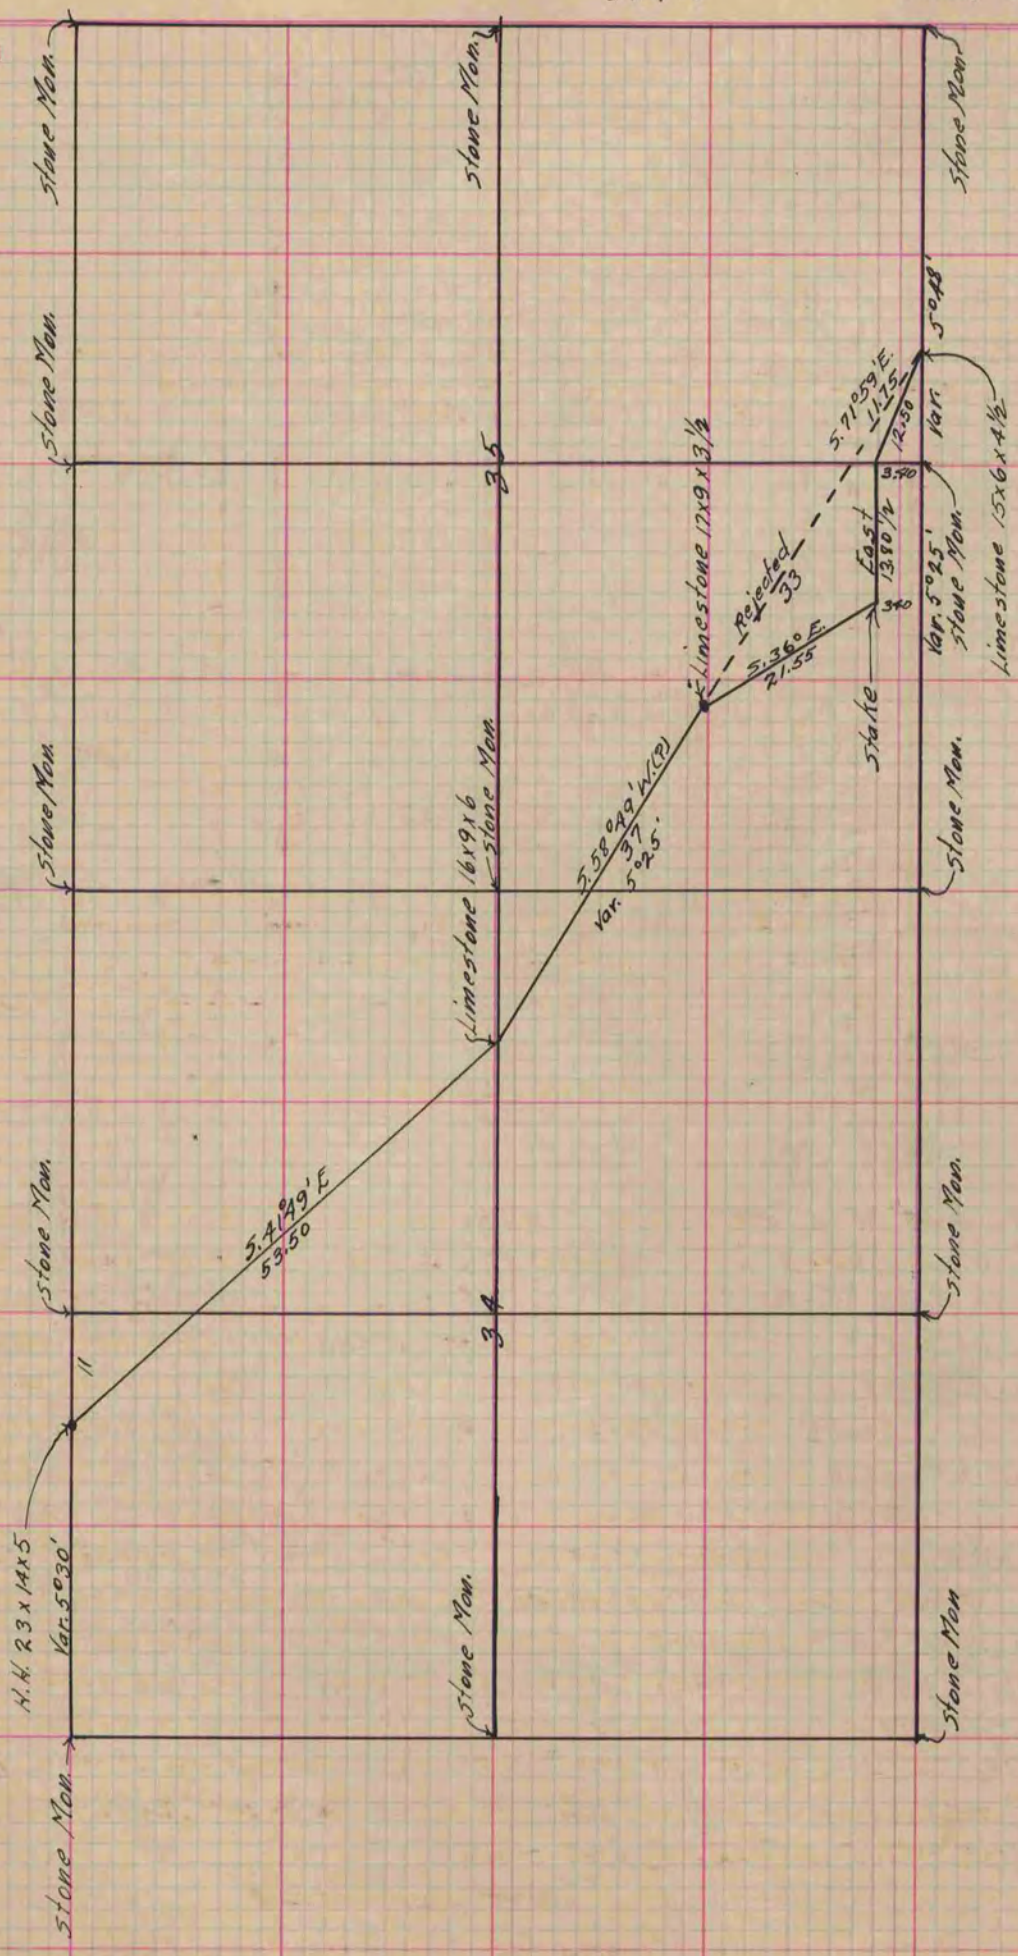

Copied from Page 80 Vol. 2 Original County Surveyor's Record.