203

PG 2/2 JANESVILLE
REC DAB 12/15/75

PLAT AND RECORD

Of a Survey on Section S.E¼ 27 T 4N. R 13 E. of the 4 P. M. in Milton Township

Rock County, Wisconsin, made August the 9 1932

I hereby certify that the following is a correct record of said survey as made by me.

COUNTY BUILDING
IN CITY OF BELOIT
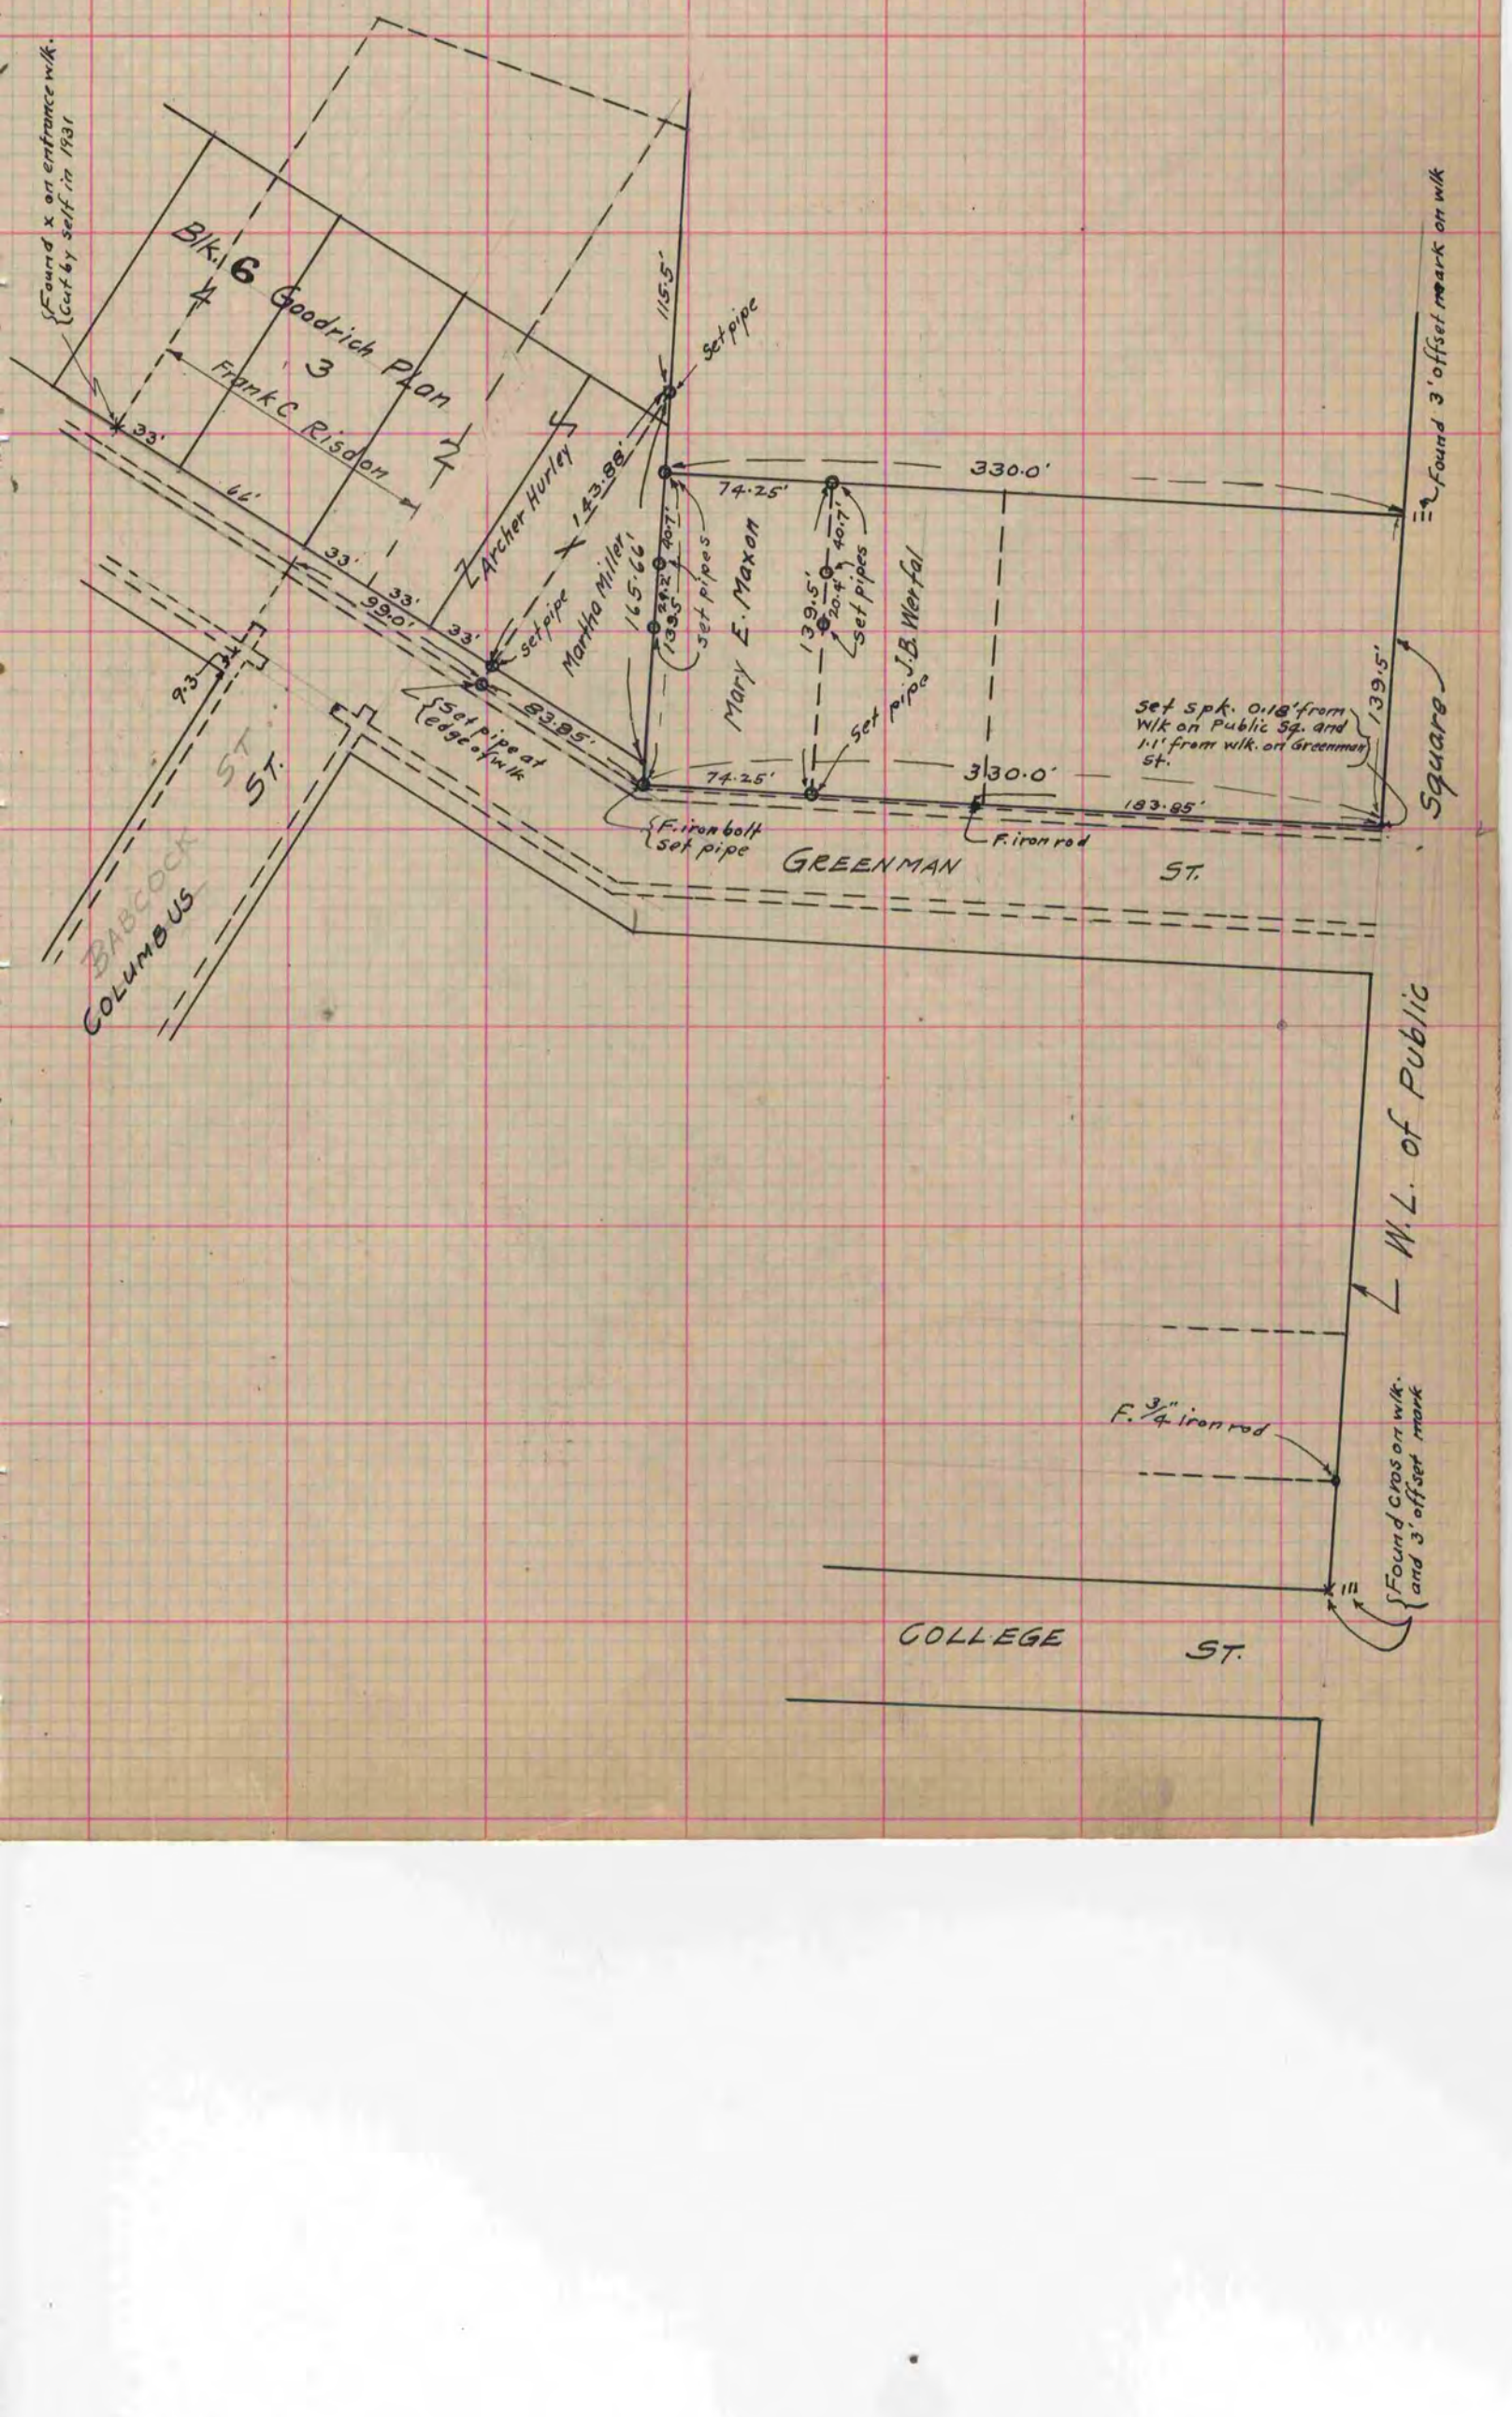
B. J. Bunny
County Surveyor