PLAT AND RECORD

Of a Survey on Section 32 T 2 R 14 E. of the 4 P. M. in Bradford Township

Rock County, Wisconsin, made May the 1st 1877

I hereby certify that the following is a correct record of said survey as made by me.

COUNTY BUILDING
IN CITY OF BELOIT

(Signed) Edward Ruger
County Surveyor.

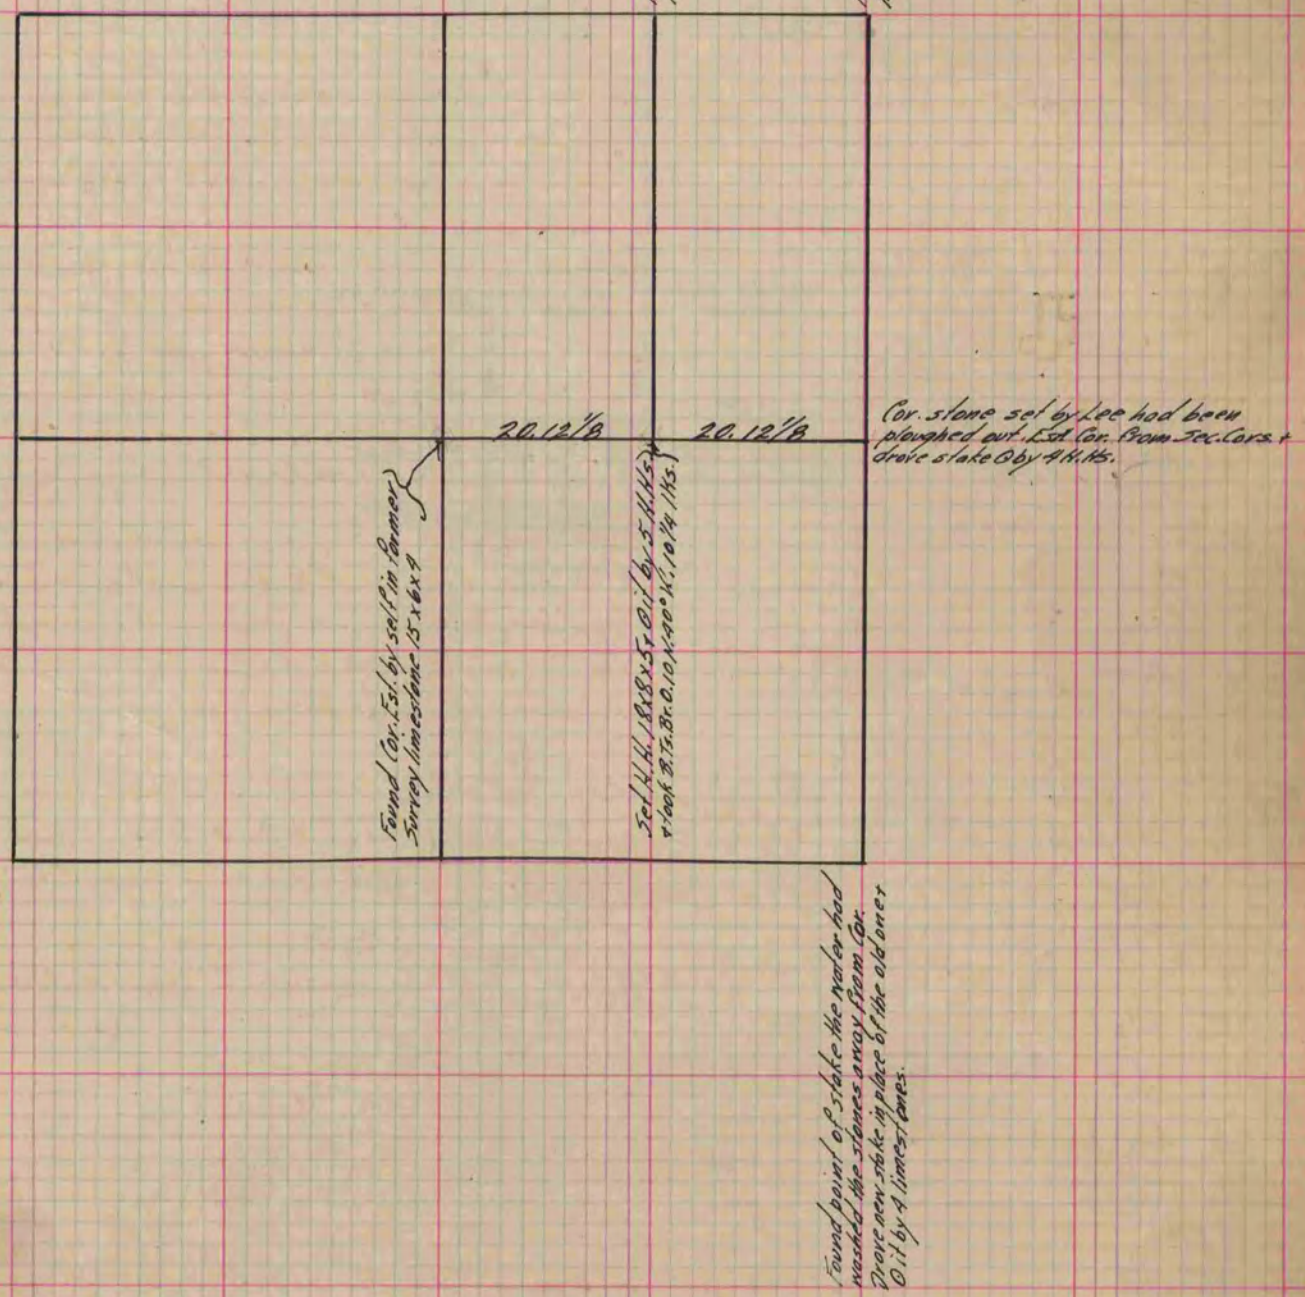

Copied From P. 177 Vol. 2 Original County Surveyor's Record.