222

P6228 JANESVILLE SET

PLAT AND RECORD

Of a Survey on Section 23 & 24 T 3 N. R 12 E. of the 4 P. M. in Janesville Township

Rock County, Wisconsin, made April / May the 22 / 3 1930 / 1933

I hereby certify that the following is a correct record of said survey as made by me.

COUNTY BUILDING
IN CITY OF BELOIT
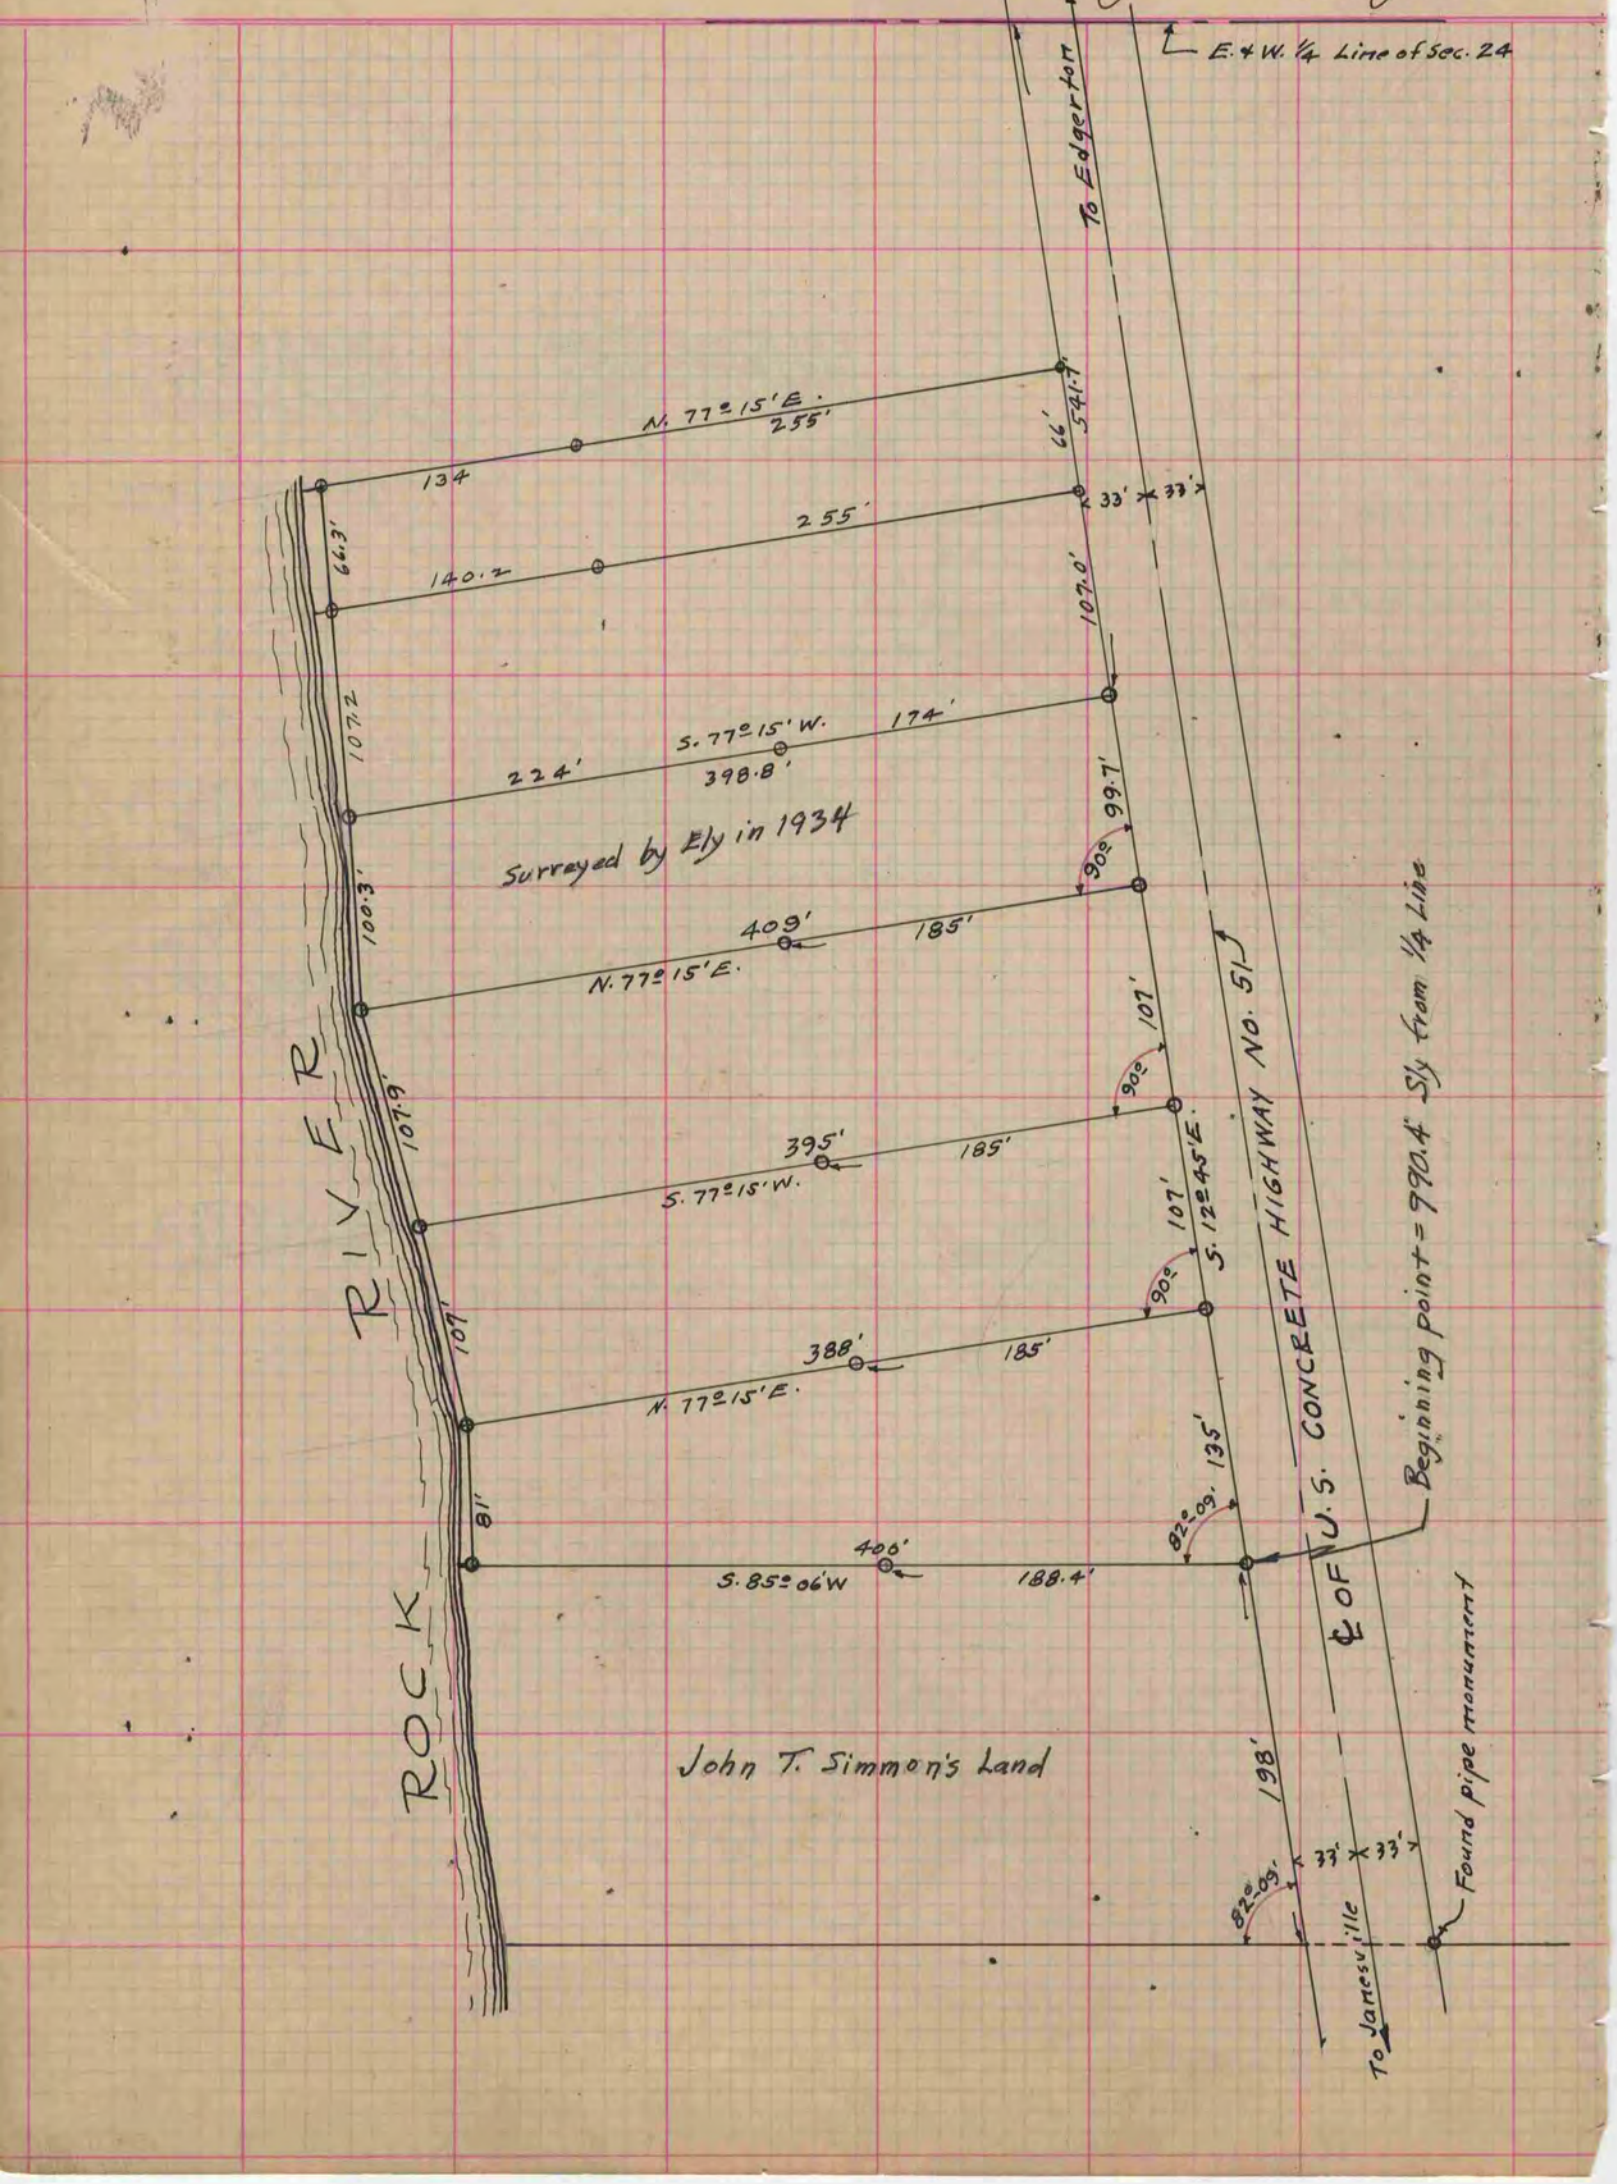
B. J. Bunny
County Surveyor.