PLAT AND RECORD

Of a Survey on Section 25 T 4 R 12 E. of the 4 P. M. in Fulton Township

Rock County, Wisconsin, made October the 25, 26 & 27 1864

I hereby certify that the following is a correct record of said survey as made by me.


(Signed) S. D. Locke
County Surveyor.

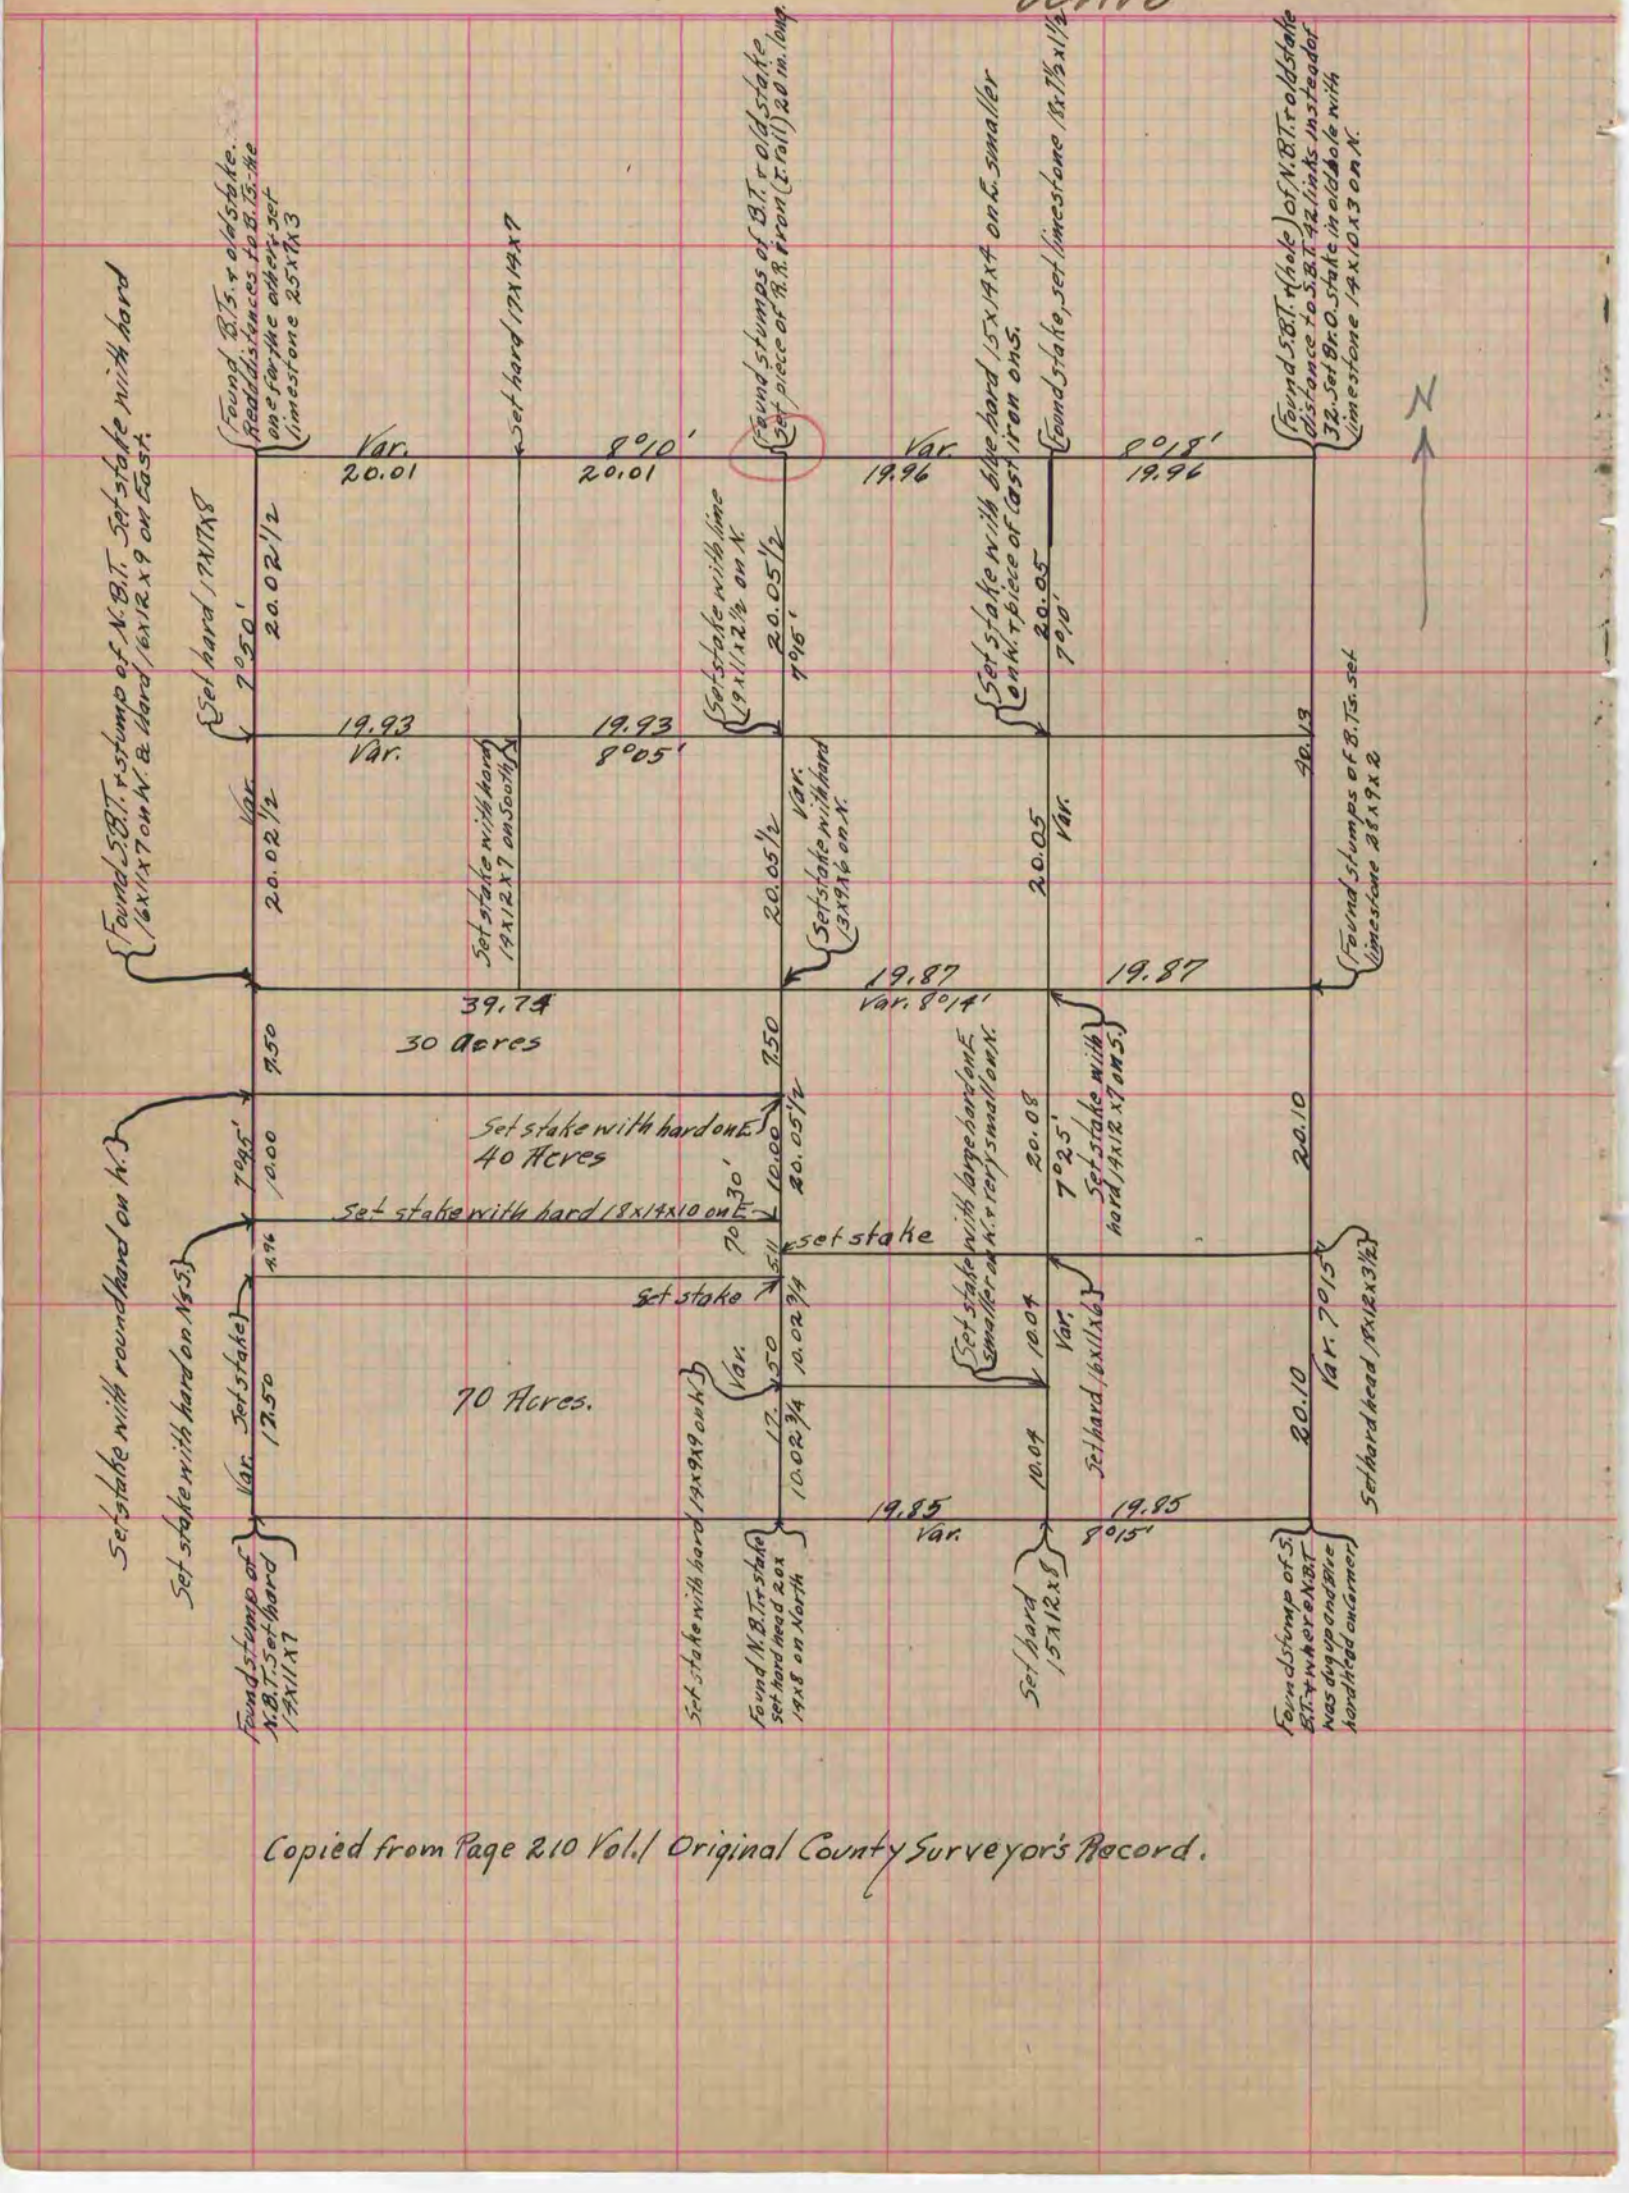

Copied from Page 210 Vol.1 Original County Surveyor's Record.