PLAT AND RECORD

Of a Survey on Section 16 T 4 R 14 E. of the 4 P. M. in Lima Township

Rock County, Wisconsin, made March the 8th & 9th 1864

I hereby certify that the following is a correct record of said survey as made by me.

COUNTY BUILDING
IN CITY OF BELOIT

(Signed) S. D. Locke.
RAB
County Surveyor.

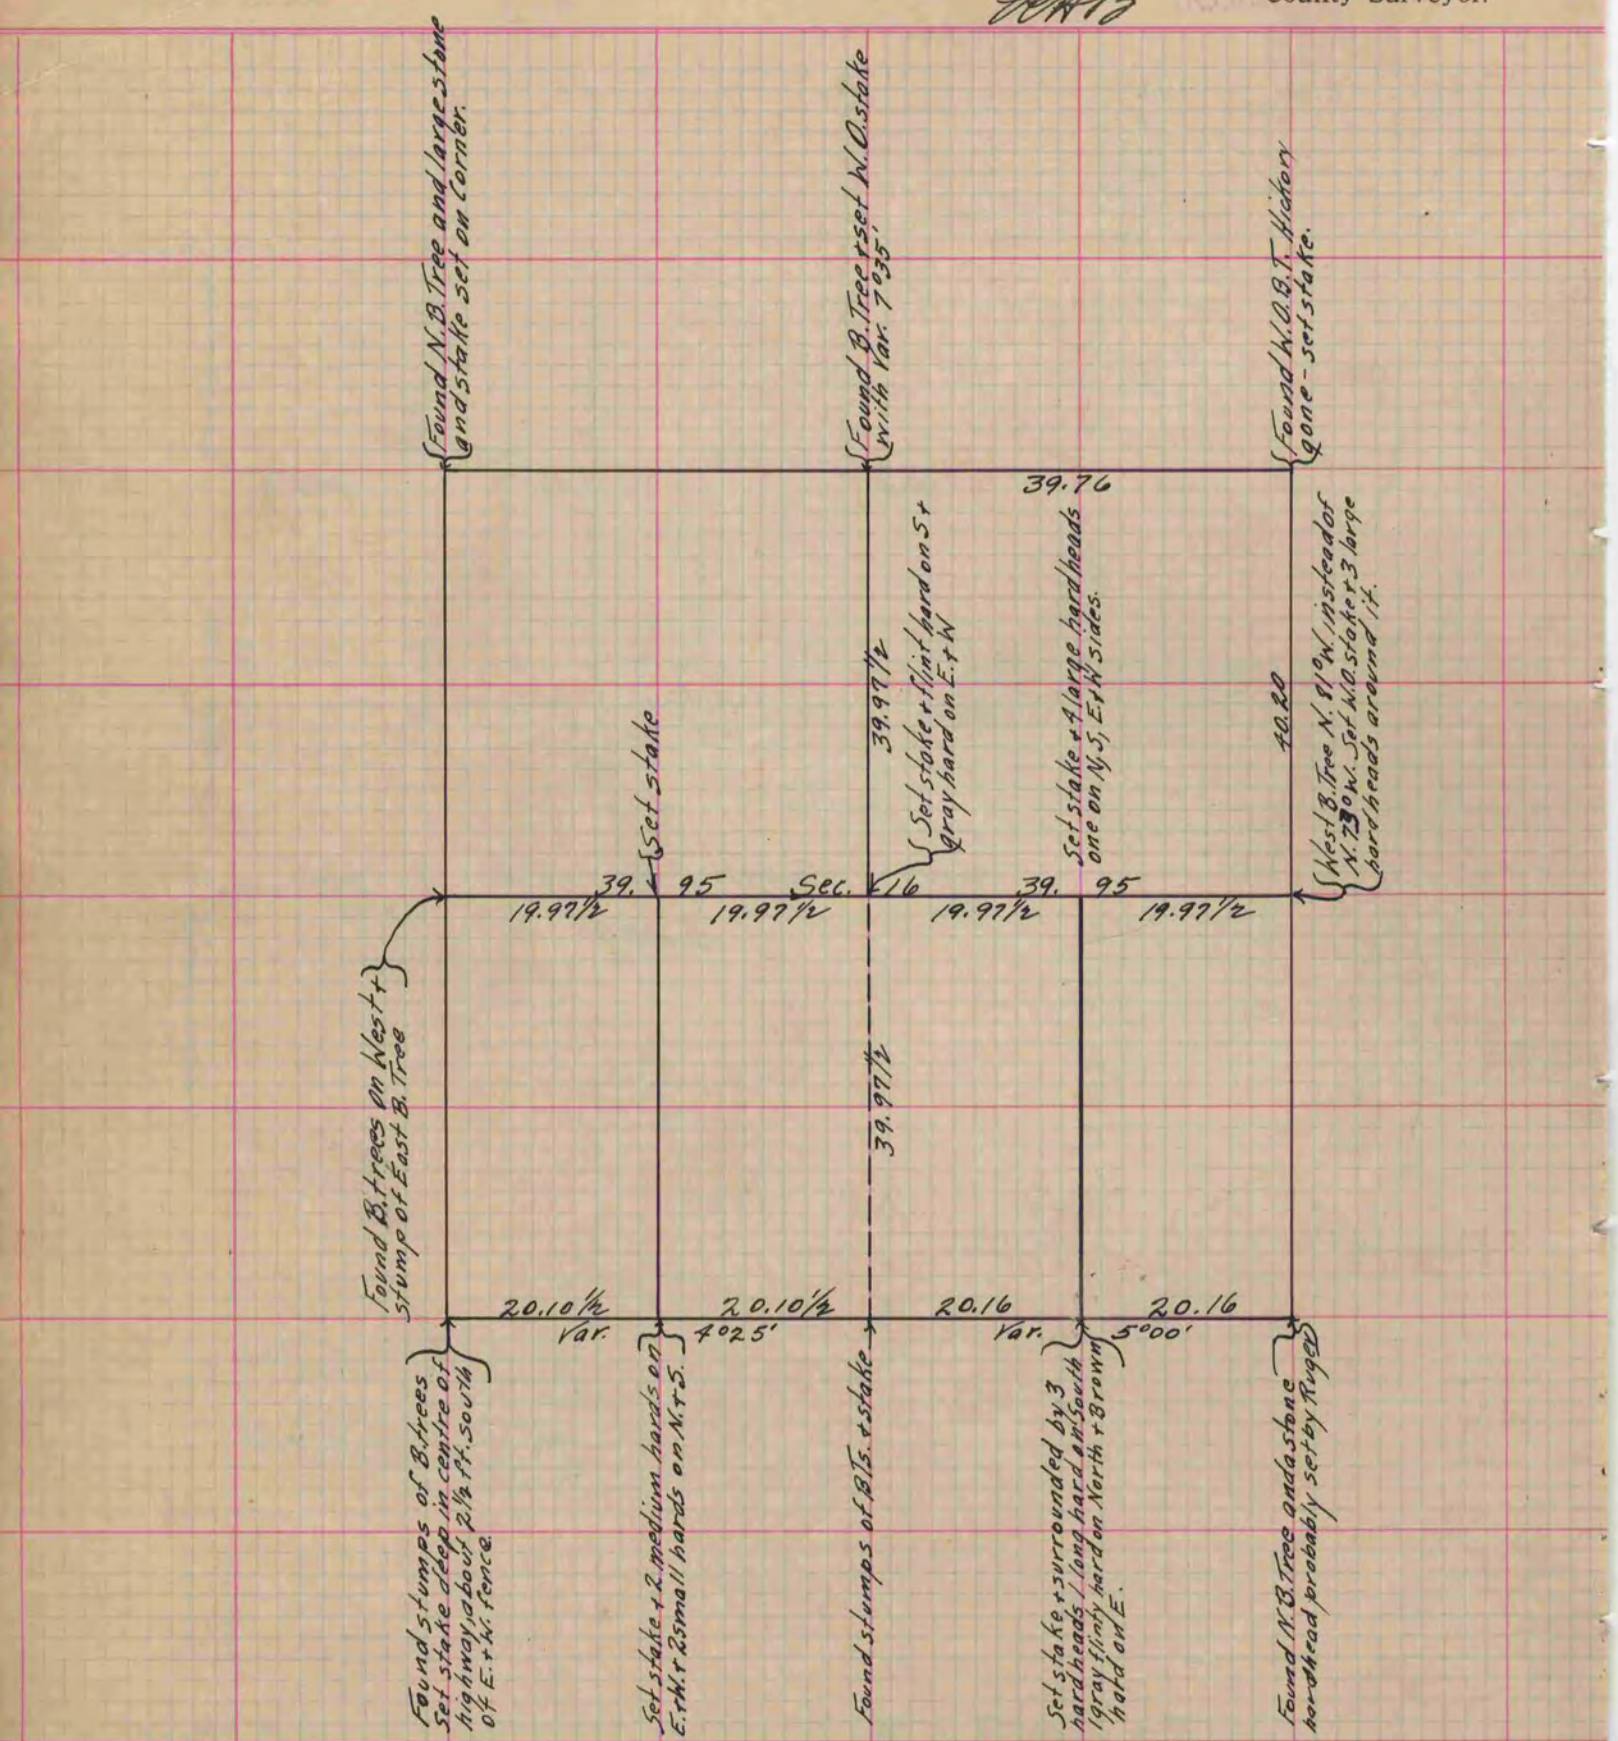

Copied from lower ½ of Page 201 Vol. 1. Original County Surveyor's Record.