PLAT AND RECORD

COUNTY BUILDING
IN CITY OF BELOIT

Of a Survey on Section 3 T 2 R 13 E. of the 4 P. M. in La Prairie Township

Rock County, Wisconsin, made May the 24th 1923

I hereby certify that the following is a correct record of said survey as made by me.
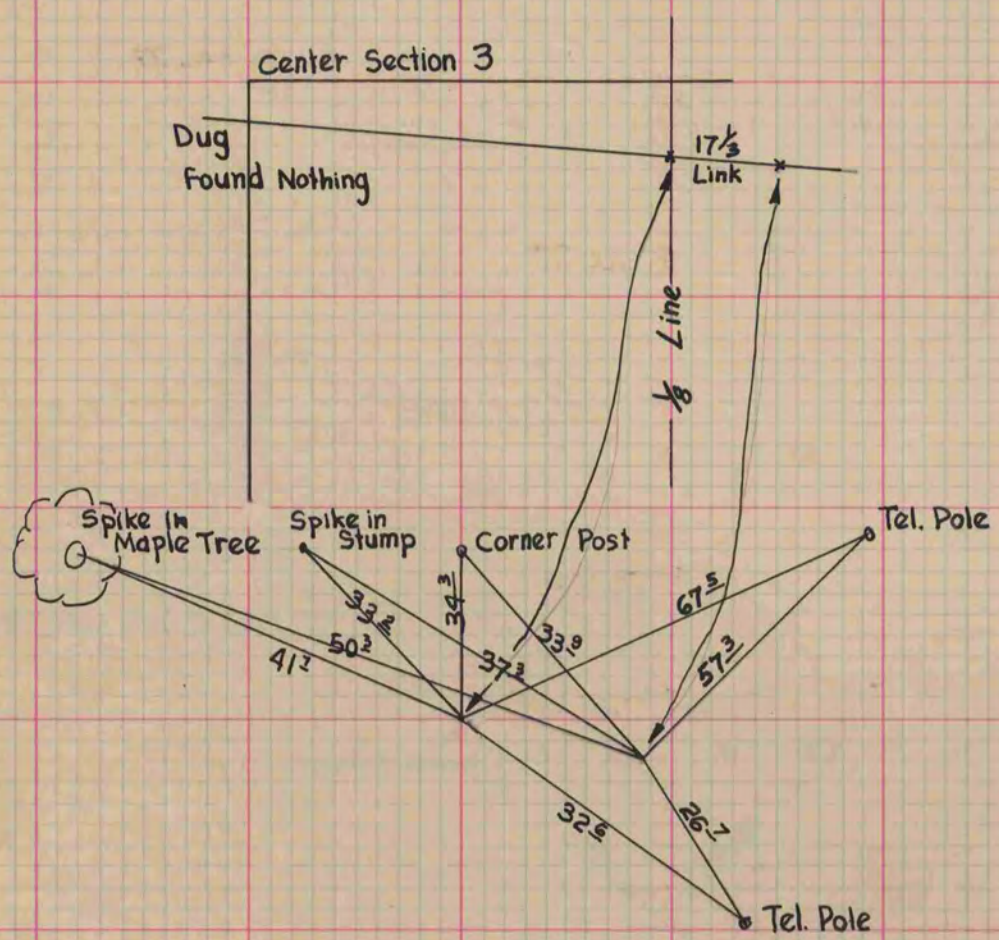
(Signed) ALex W. Ely
County Surveyor.