PLAT AND RECORD

Of a Survey on Section 12 T 2 R 11 E. of the 4 P. M. in Plymouth Township

Rock County, Wisconsin, made February the 25+26 1876

I hereby certify that the following is a correct record of said survey as made by me.

COUNTY BUILDING
IN CITY OF BELOIT

(Signed) Edward Roger
Roots
County Surveyor.

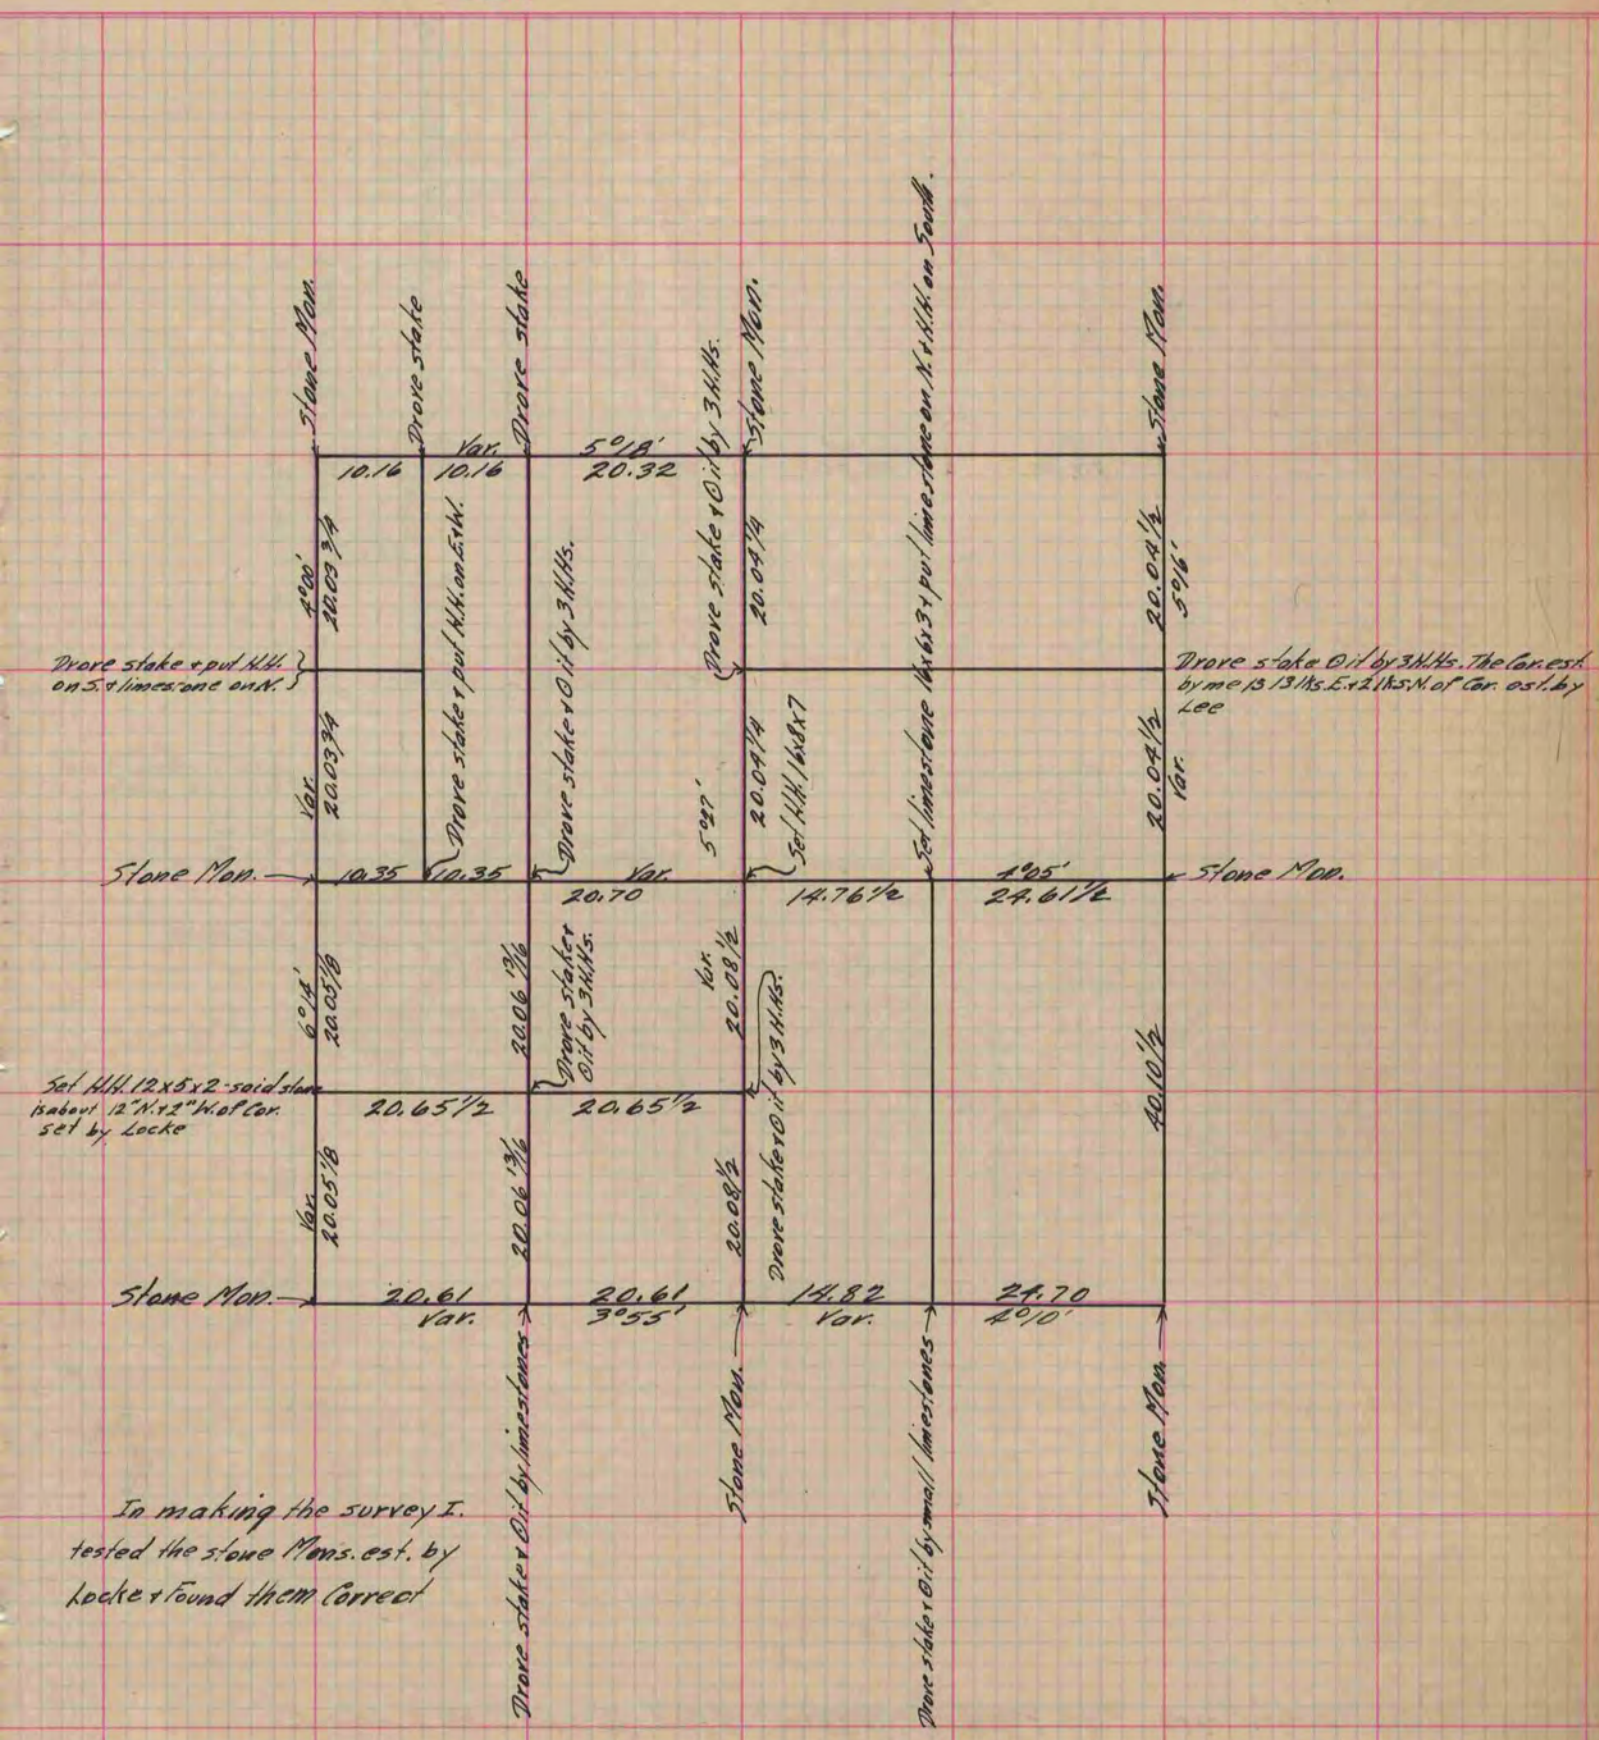

In making the survey I. tested the stone Mons. est. by Locke & found them Correct

Copied from P. 159 Vol. 2 Original County Surveyor's Record.