520

PLAT AND RECORD

Of a Survey on Section 33+34 T 2N R 11 E. of the 4 P. M. in PLYMOUTH Township

Rock County, Wisconsin, made AUGUST 7,8,9,22 Etc. the 26 1957

I hereby certify that the following is a correct record of said survey as made by me.

COUNTY BUILDING
IN CITY OF BELOIT

County Surveyor.

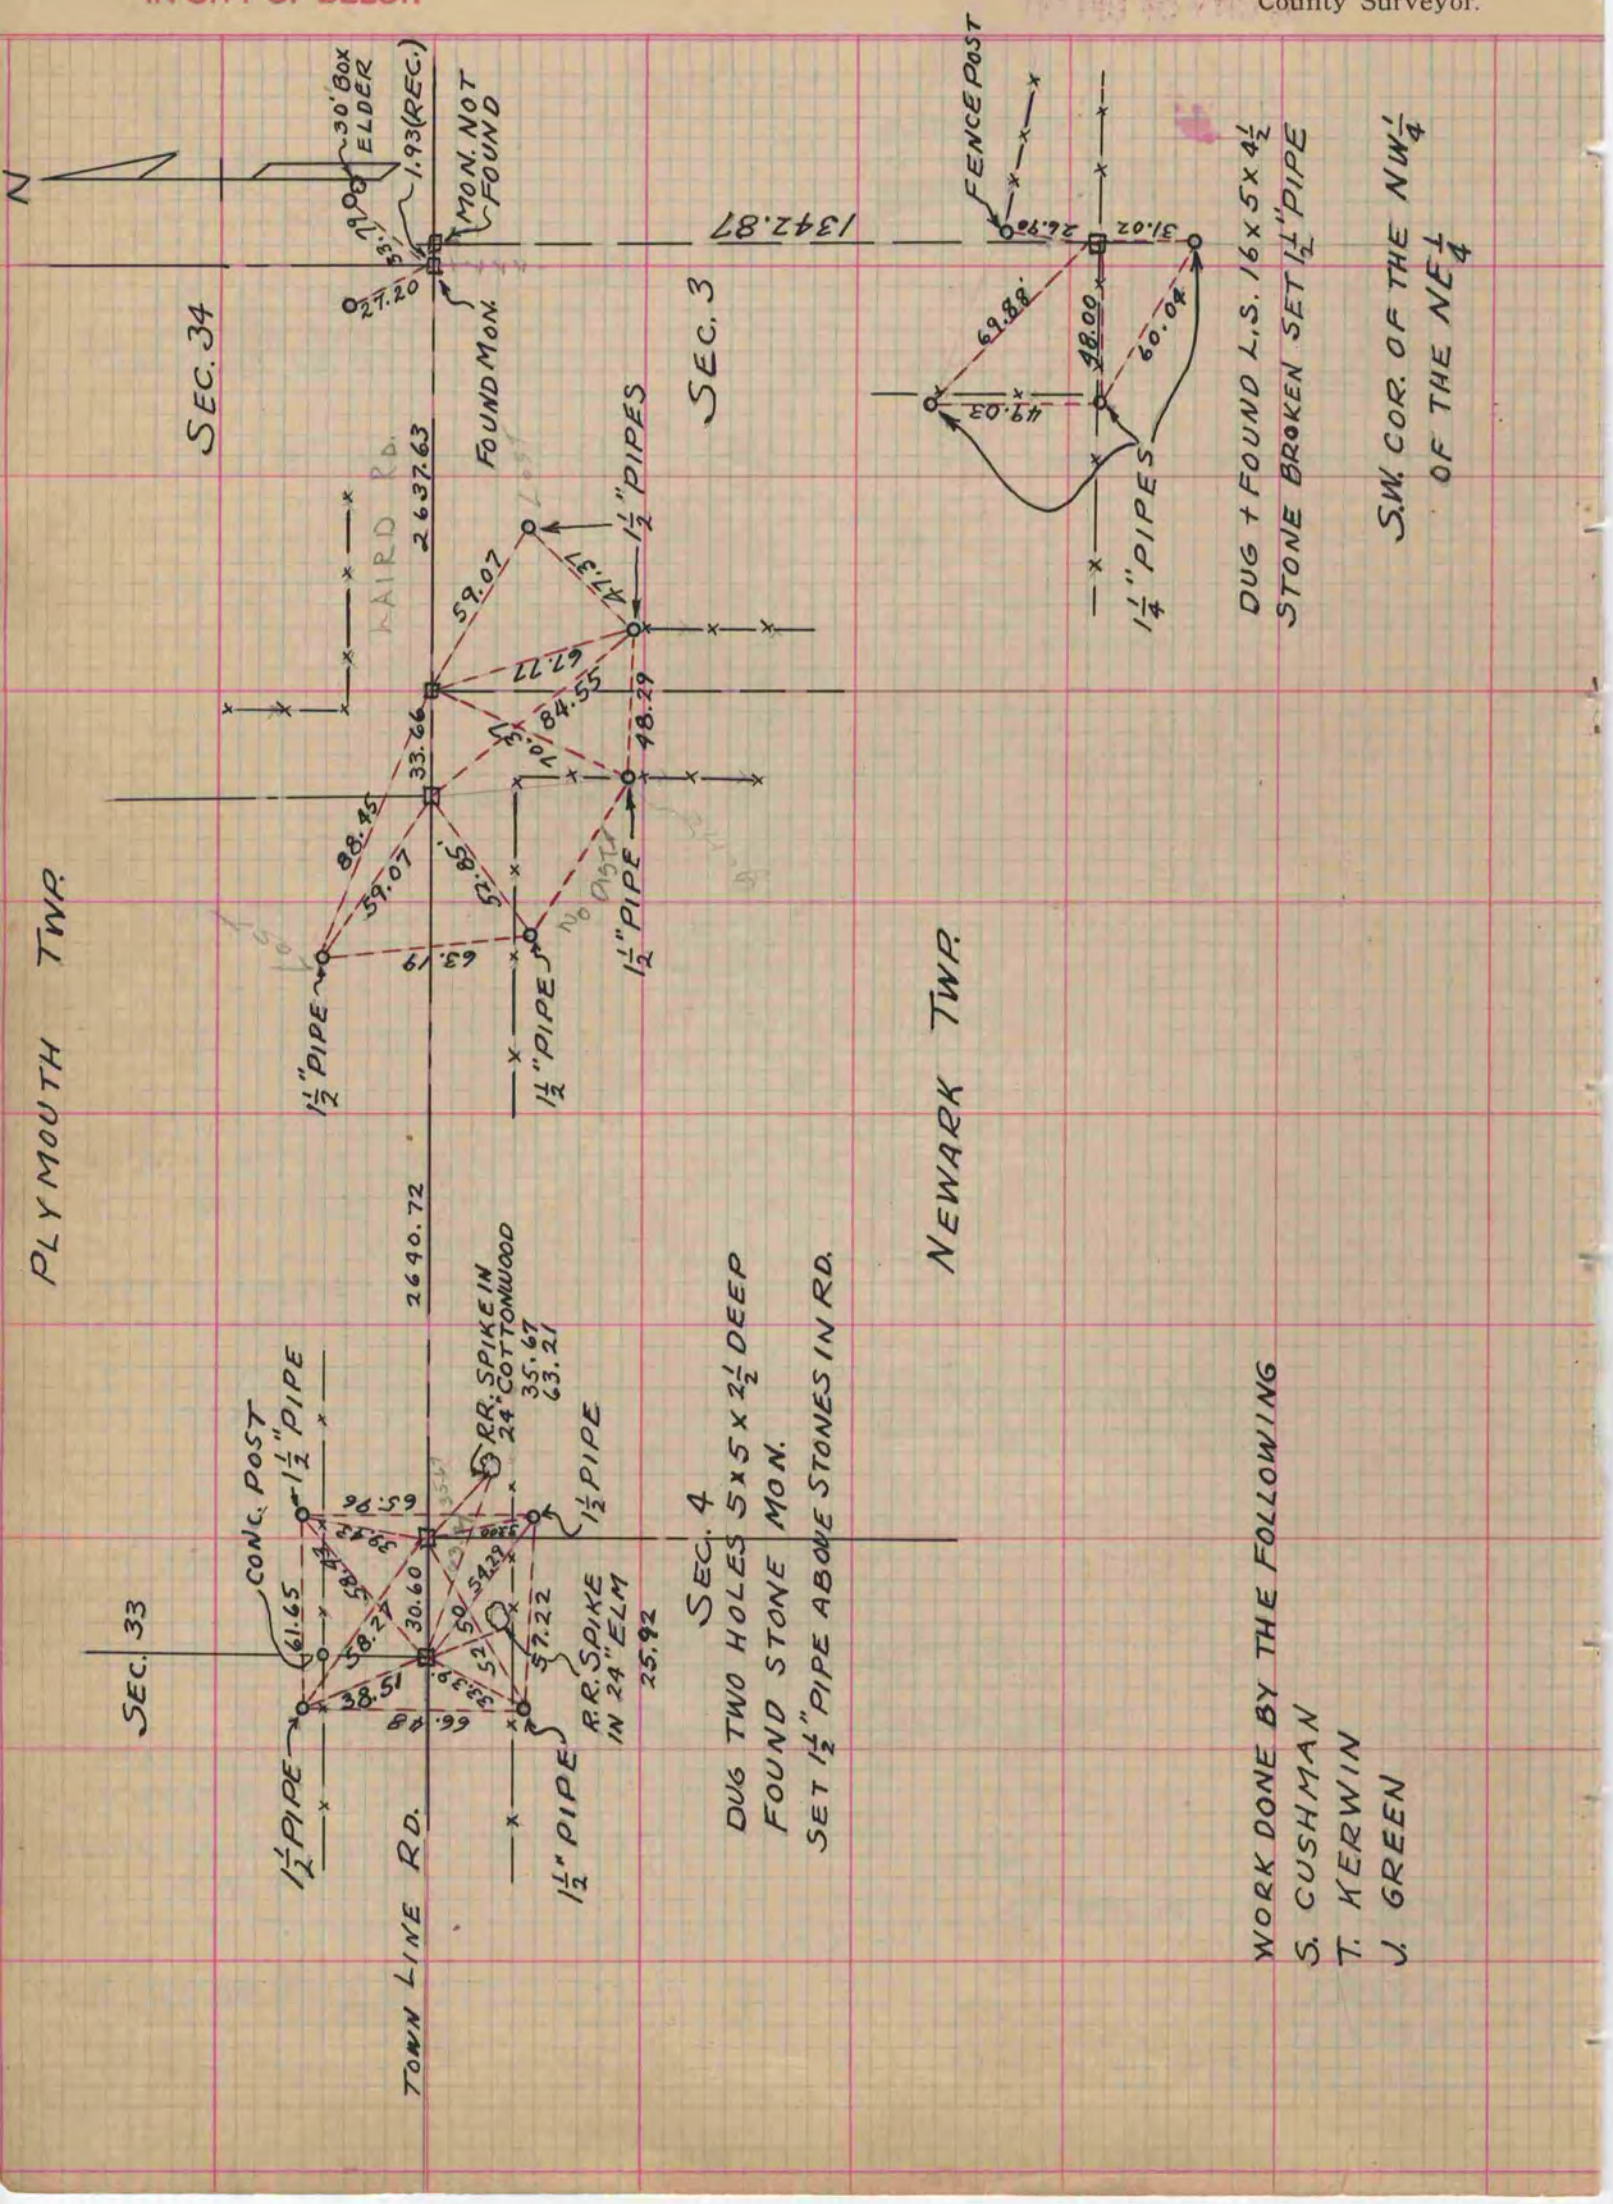

WORK DONE BY THE FOLLOWING
S. CUSHMAN
T. KERWIN
J. GREEN