MICROFILMED
COUNTY BUILDING
CITY OF JANESVILLE

147
V-2

PLAT AND RECORD

Of a Survey on Section 36 T 4 R 14 E. of the 4 P. M. in Lima Township

Rock County, Wisconsin, made June the 29 & 30 1874

I hereby certify that the following is a correct record of said survey as made by me.

(Signed) Edward Ruger
R.H.B. County Surveyor.

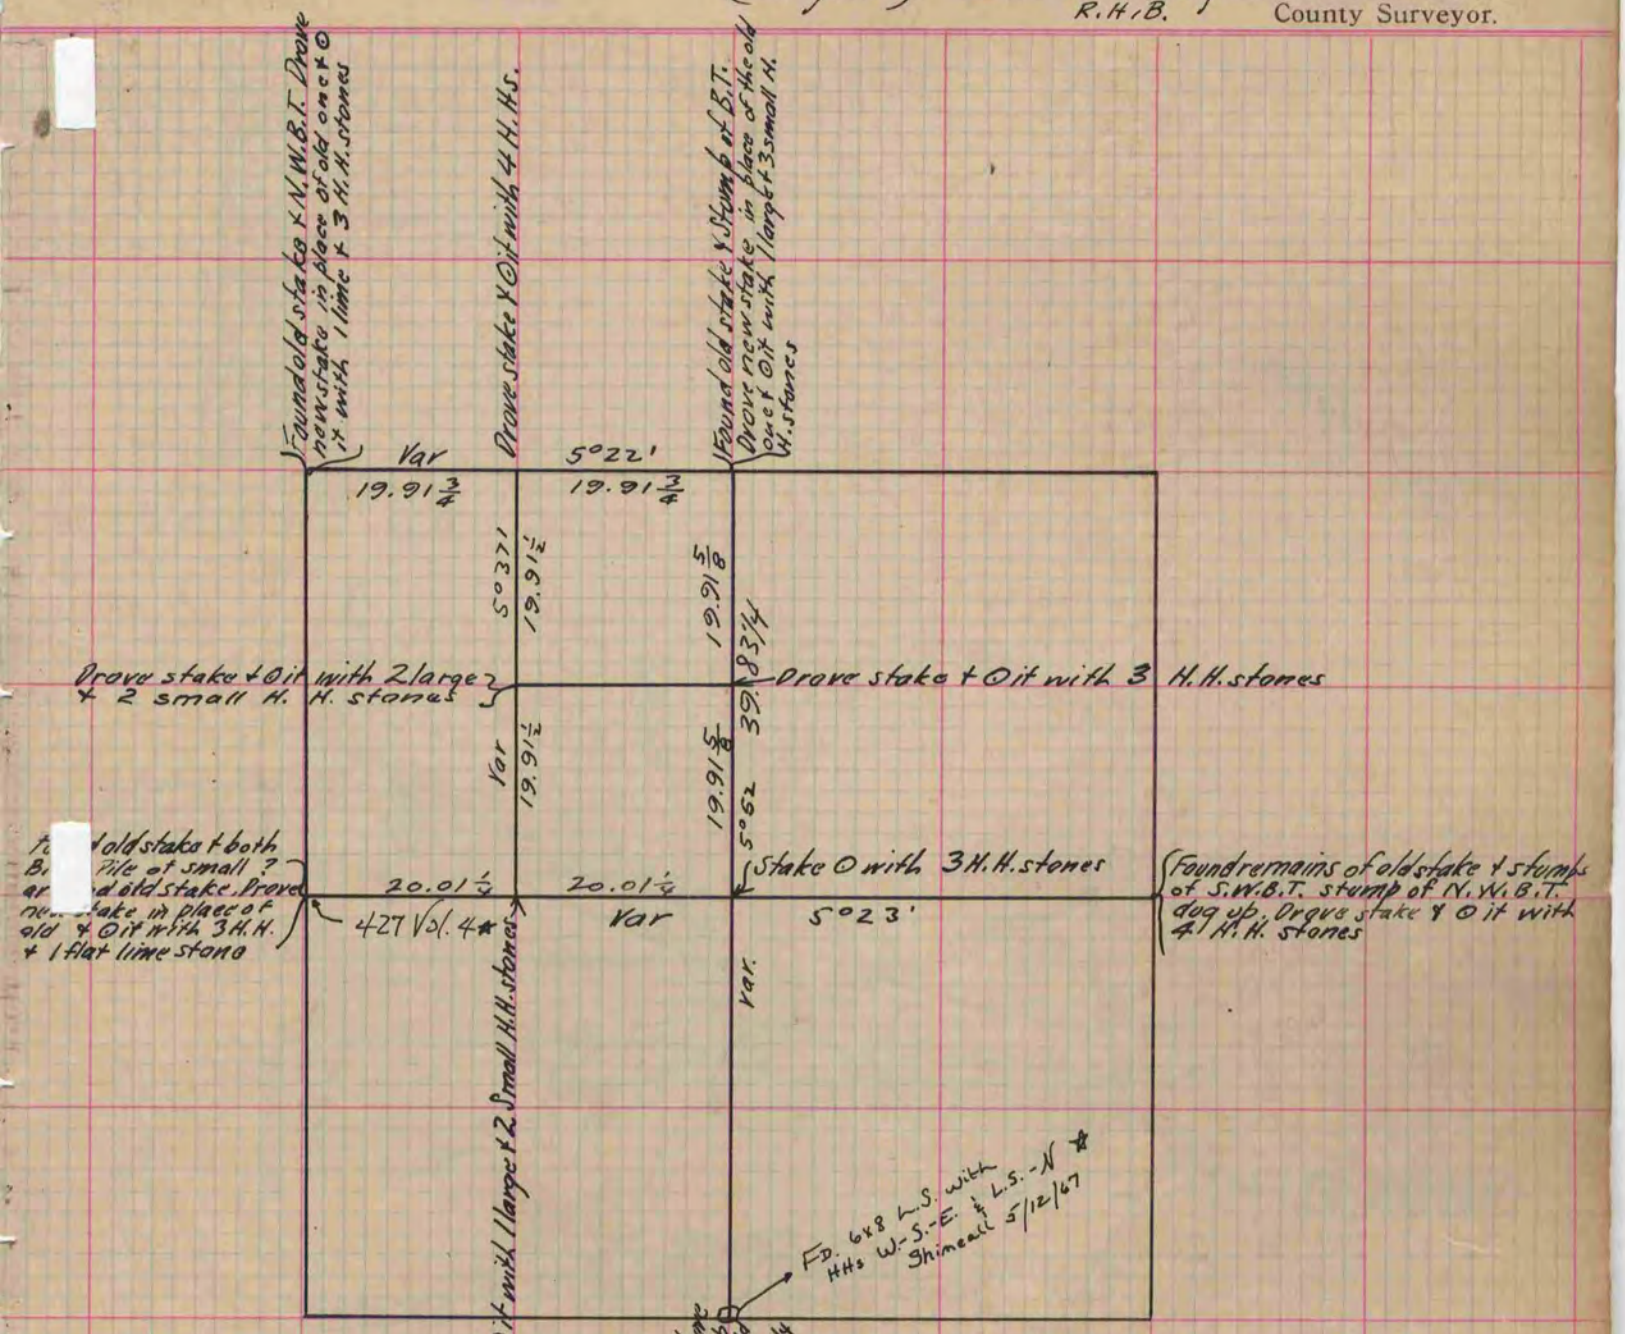

★ Copied from Beloit Records
12/11/75
E.G.

Copied from P. 104 Volume 2 Original County Surveyors Record.