331 V-3 p 319
PG 318 BELOIT REC
12/15/75 DAB
S.W.¼

Lots 546 Hillcrest Add. to Eddgerton

PLAT AND RECORD

Part of Lot 9 of Crofts 2nd Add. to Edgerton

Of a Survey on Section 3 T 4N., R 12 E. of the 4 P. M. in Fulton Township

Rock County, Wisconsin, made January April 2 the 2 & 3 1937 1937

I hereby certify that the following is a correct record of said survey as made by me.

MICROFILMED
COUNTY BUILDING
CITY OF JANESVILLE
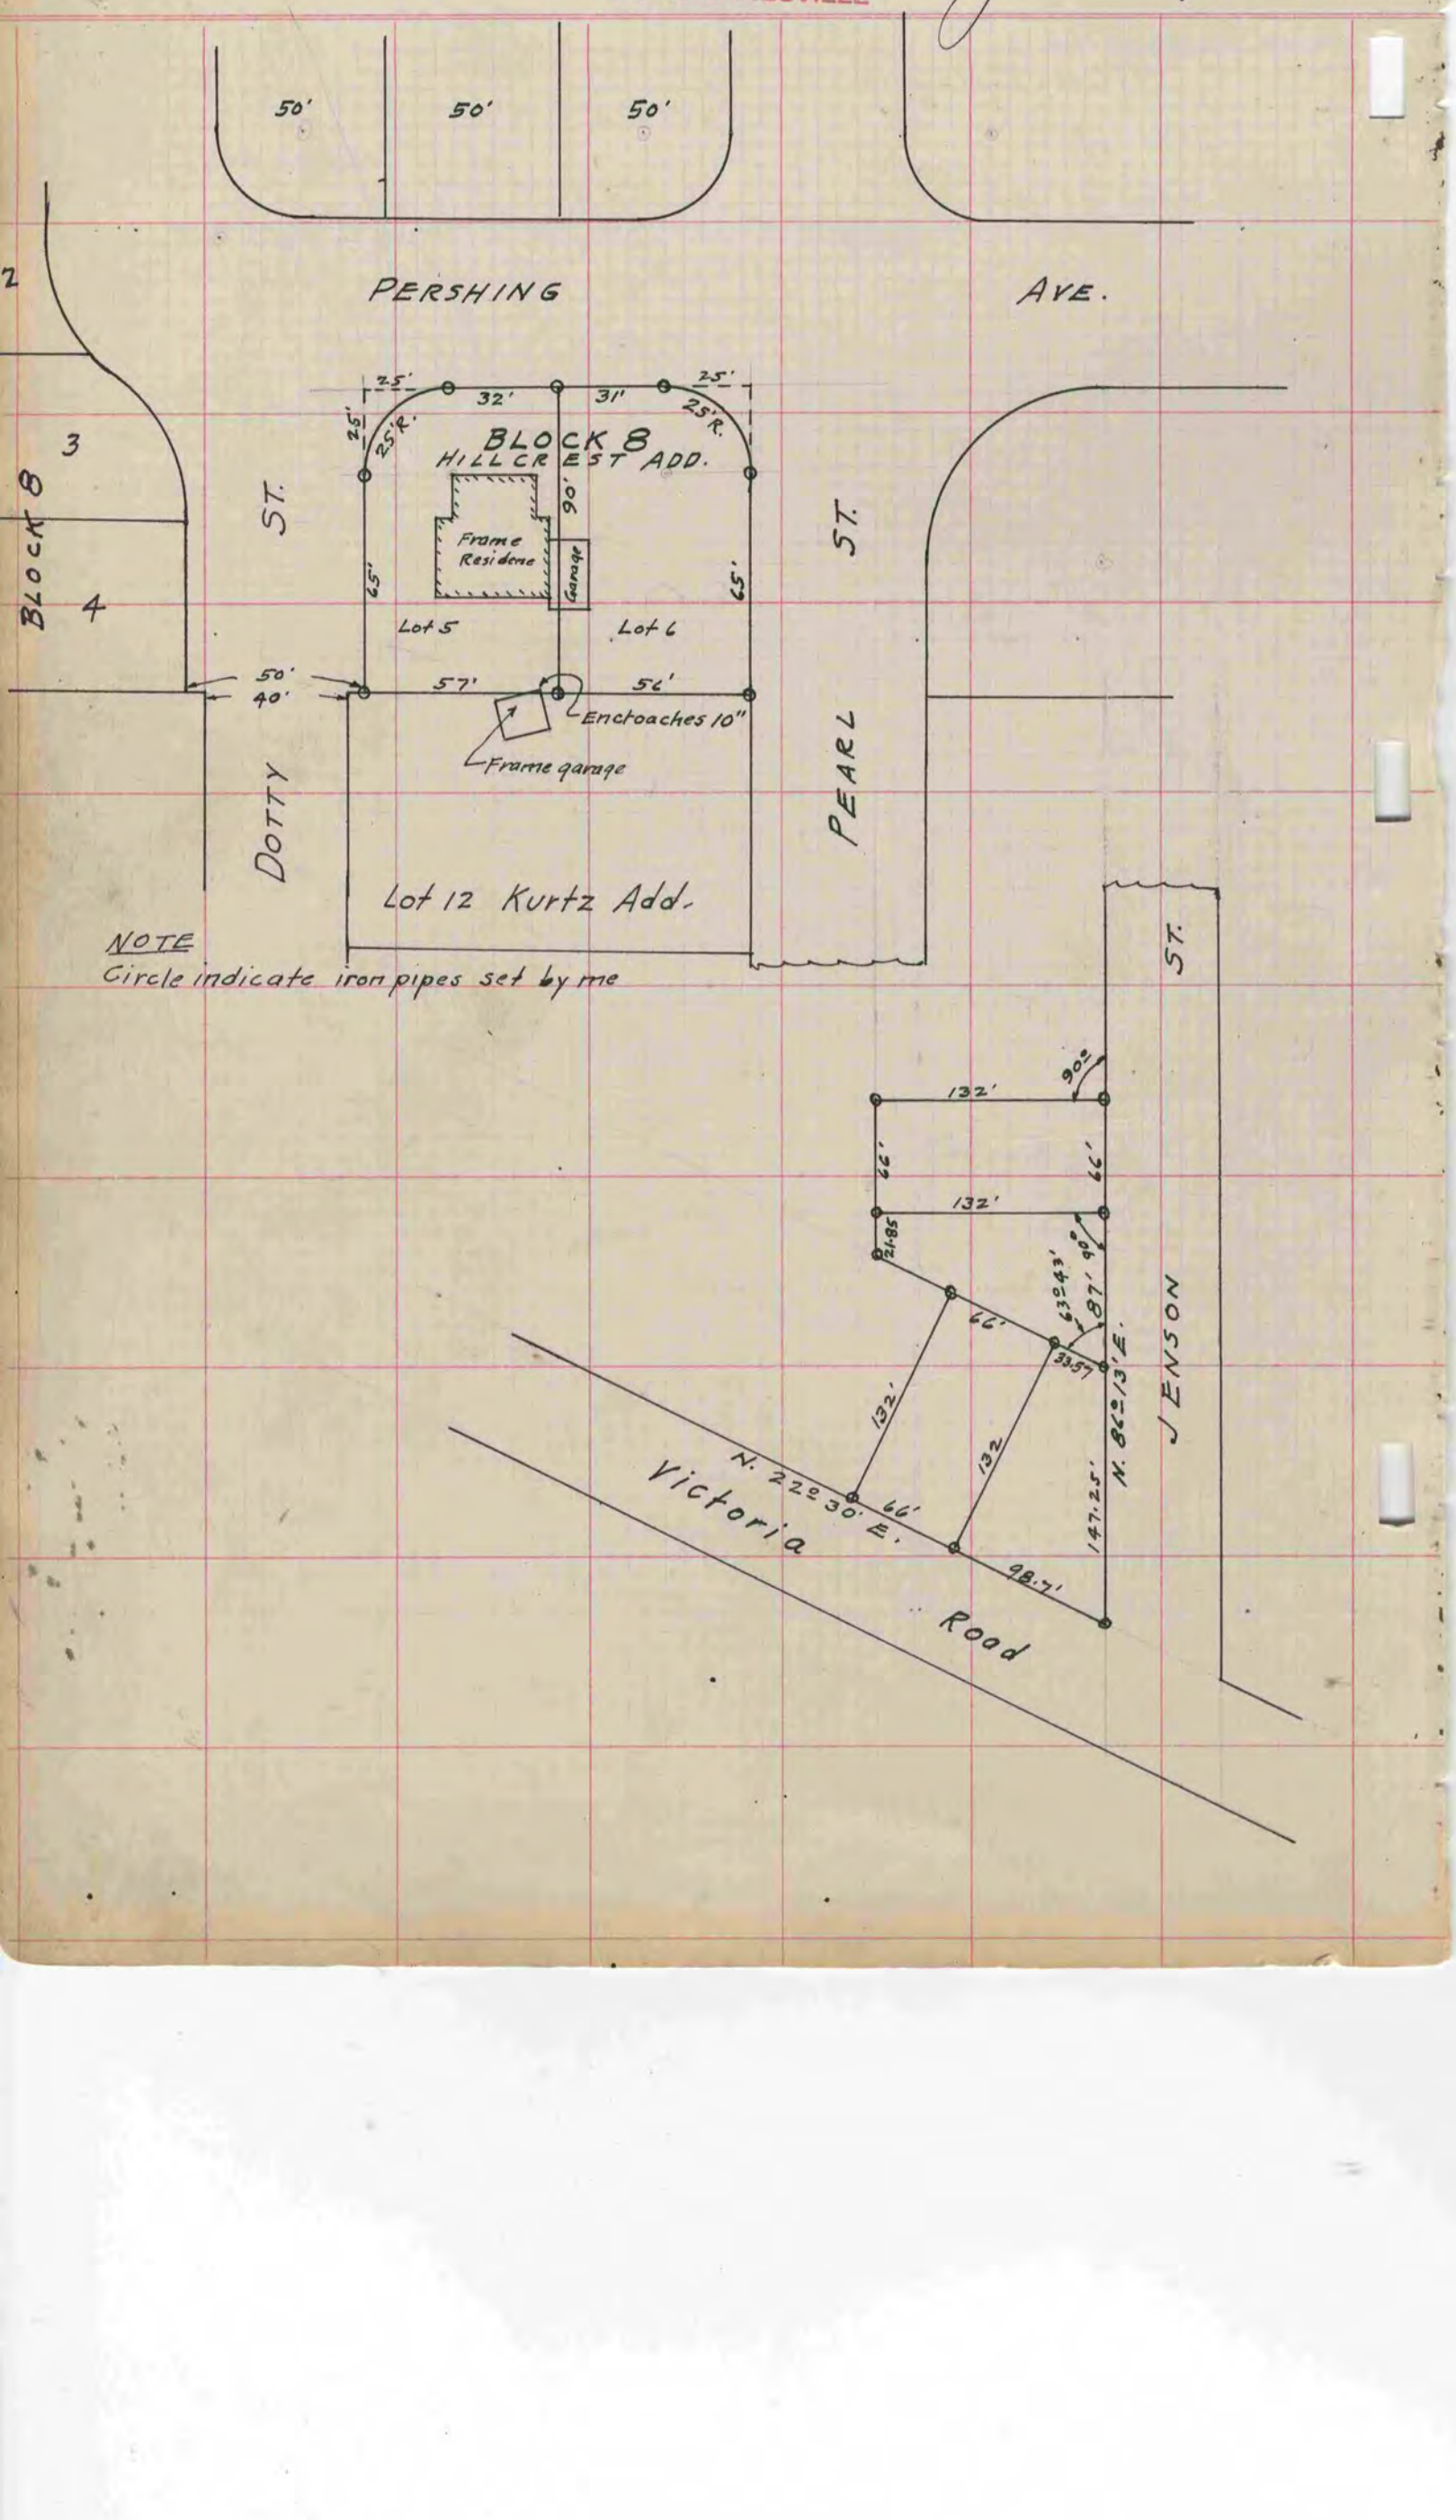
B J Sunny
County Surveyor.