335
V-2

PLAT AND RECORD

MICROFILMED
COUNTY BUILDING
CITY OF JANESVILLE

Of a Survey on Section 35 T 3 R 10 E. of the 4 P. M. in Magnolia Township

Rock County, Wisconsin, made September the 27th 28th 29th 1881

I hereby certify that the following is a correct record of said survey as made by me.

(Signed) R. K. Lee
R.H.B. County Surveyor.

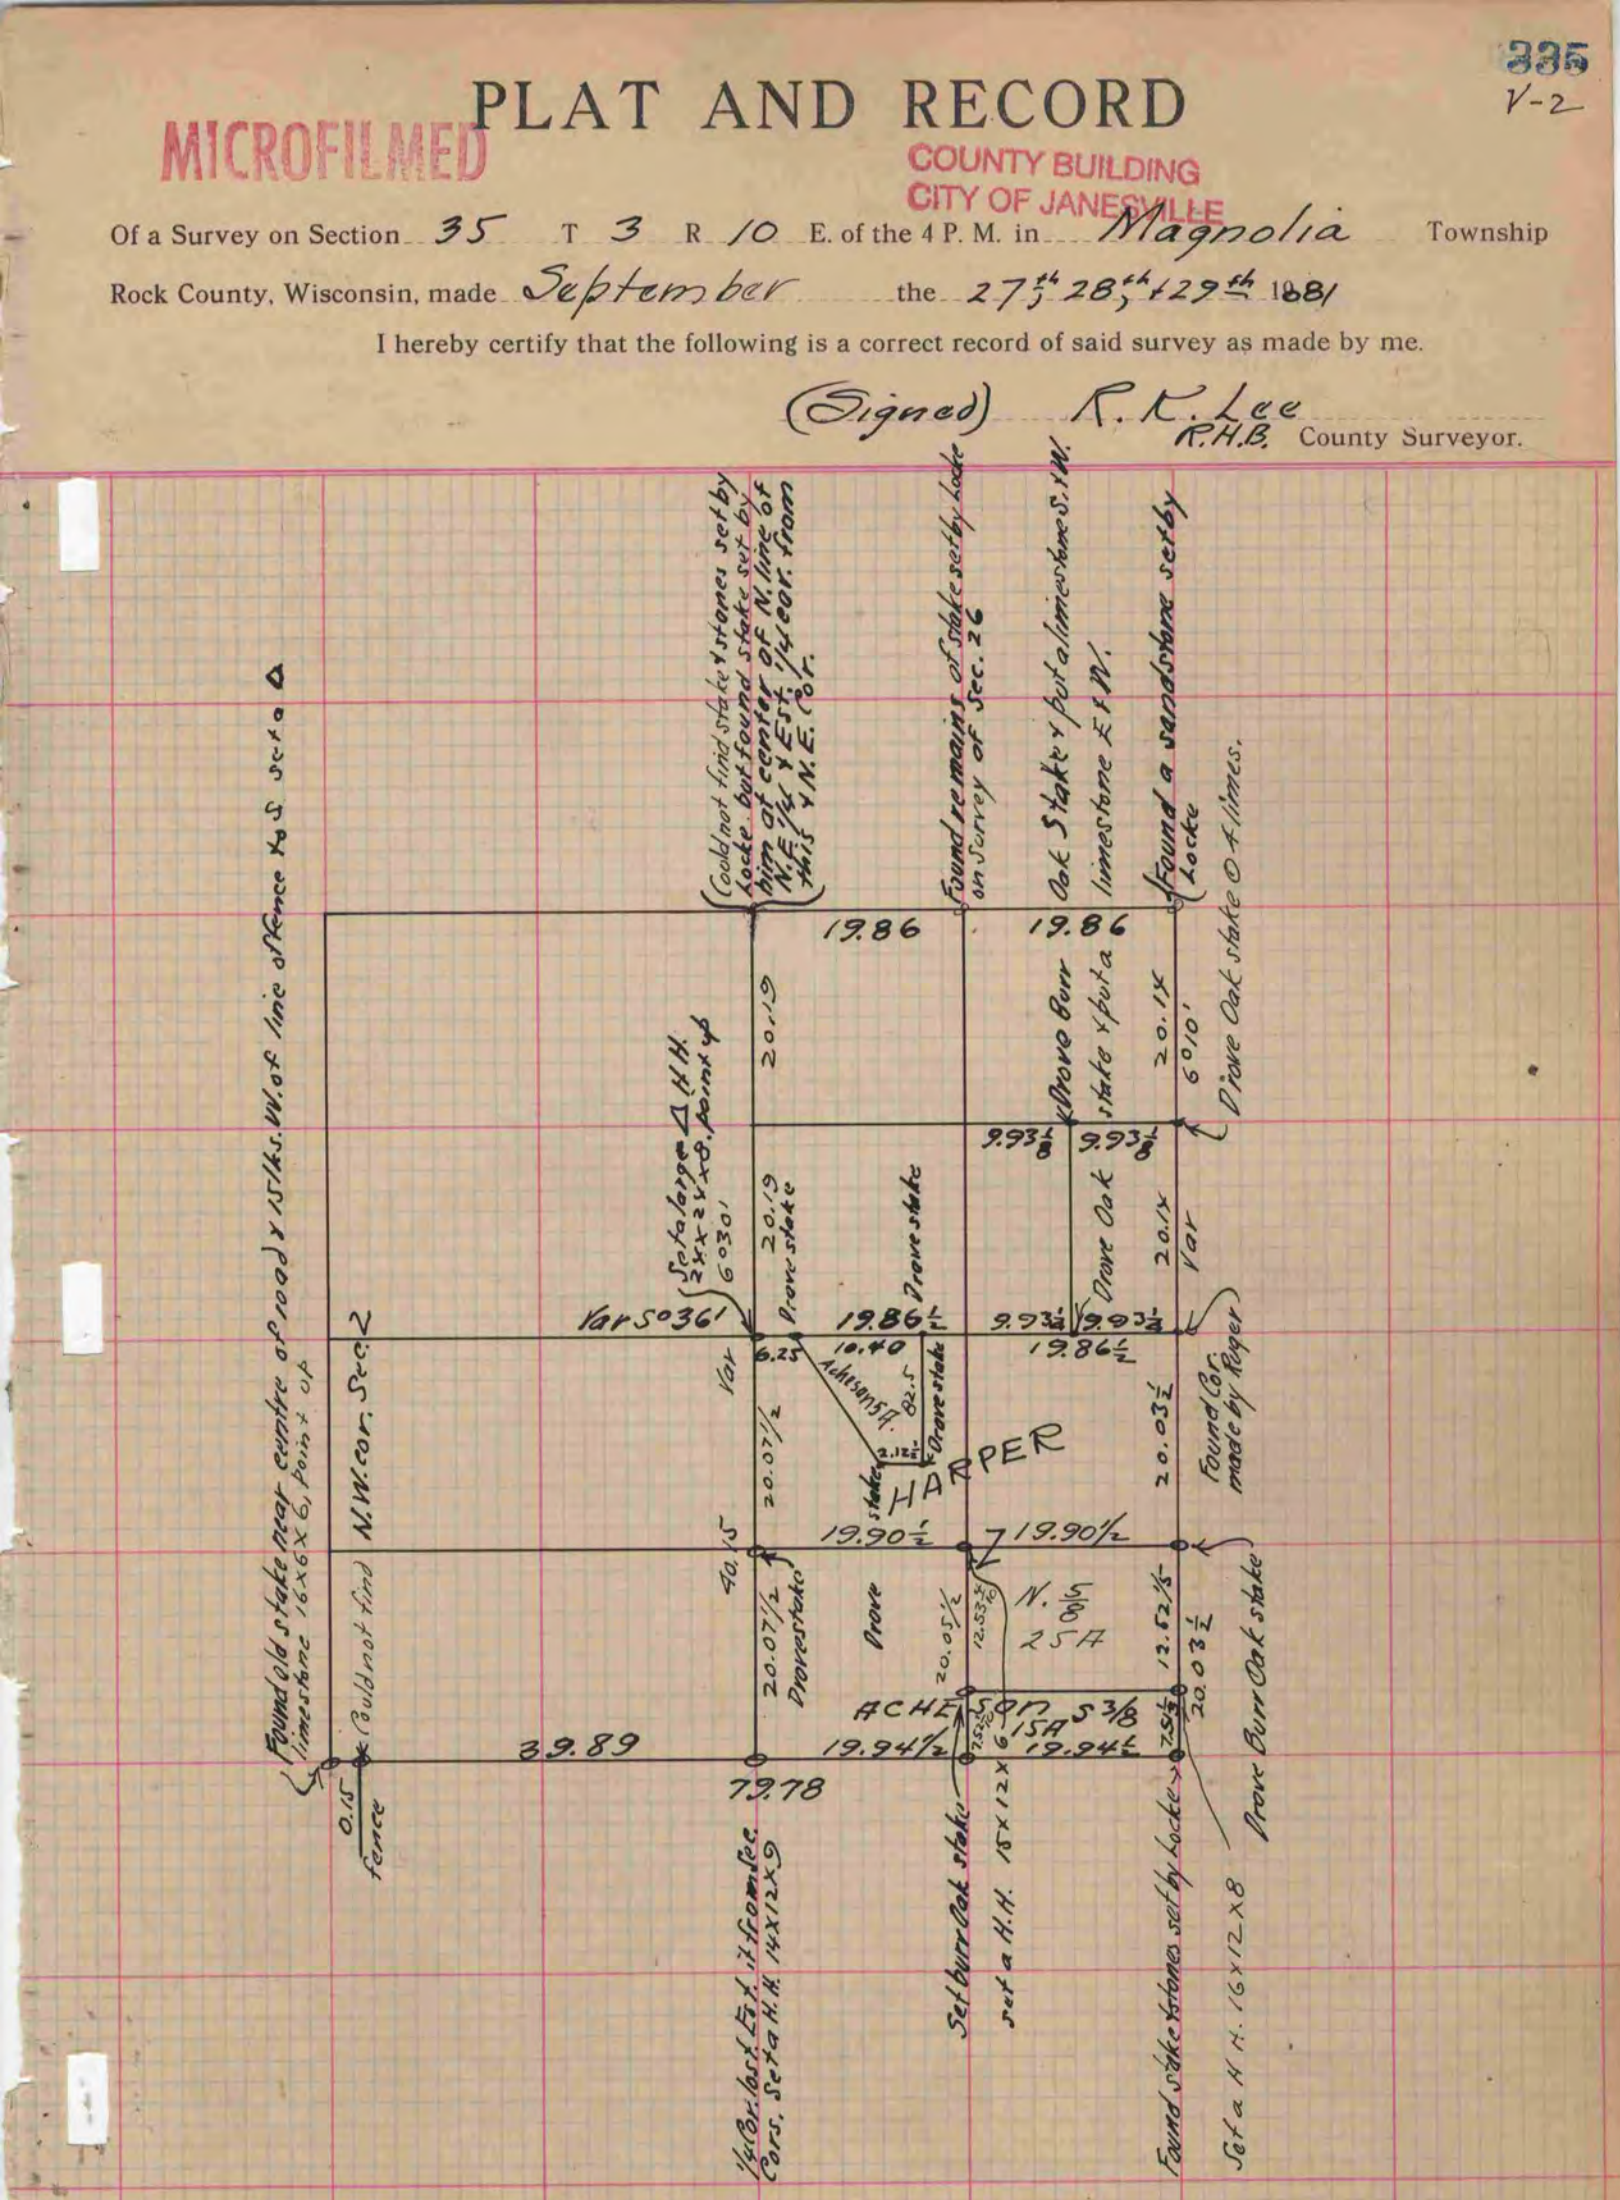

Copied from P. 273 Vol. 2. County Surveyors Record.

Note:- No record on Pages 274 and 275 Volume 2 County Surveyor's Record.