~~572~~ VOL. 6 PLAT AND RECORD

40

14,15

Of a Survey on Section 22,23 T. 2 R. 11 E. of the 4 P.M. in PLYMOUTH Township

Rock County, Wisconsin, made MAY the 21 1980

I hereby certify that the following is a correct record of said survey as made by me.

COUNTY BUILDING
CITY OF JANESVILLE

DONALD A. BARNES WISCONSIN JANESVILLE WI. LAND SURVEYOR

County Surveyor.

THE GEO. B. BARNARD COMPANY, ST. LOUIS

MICROFILMED

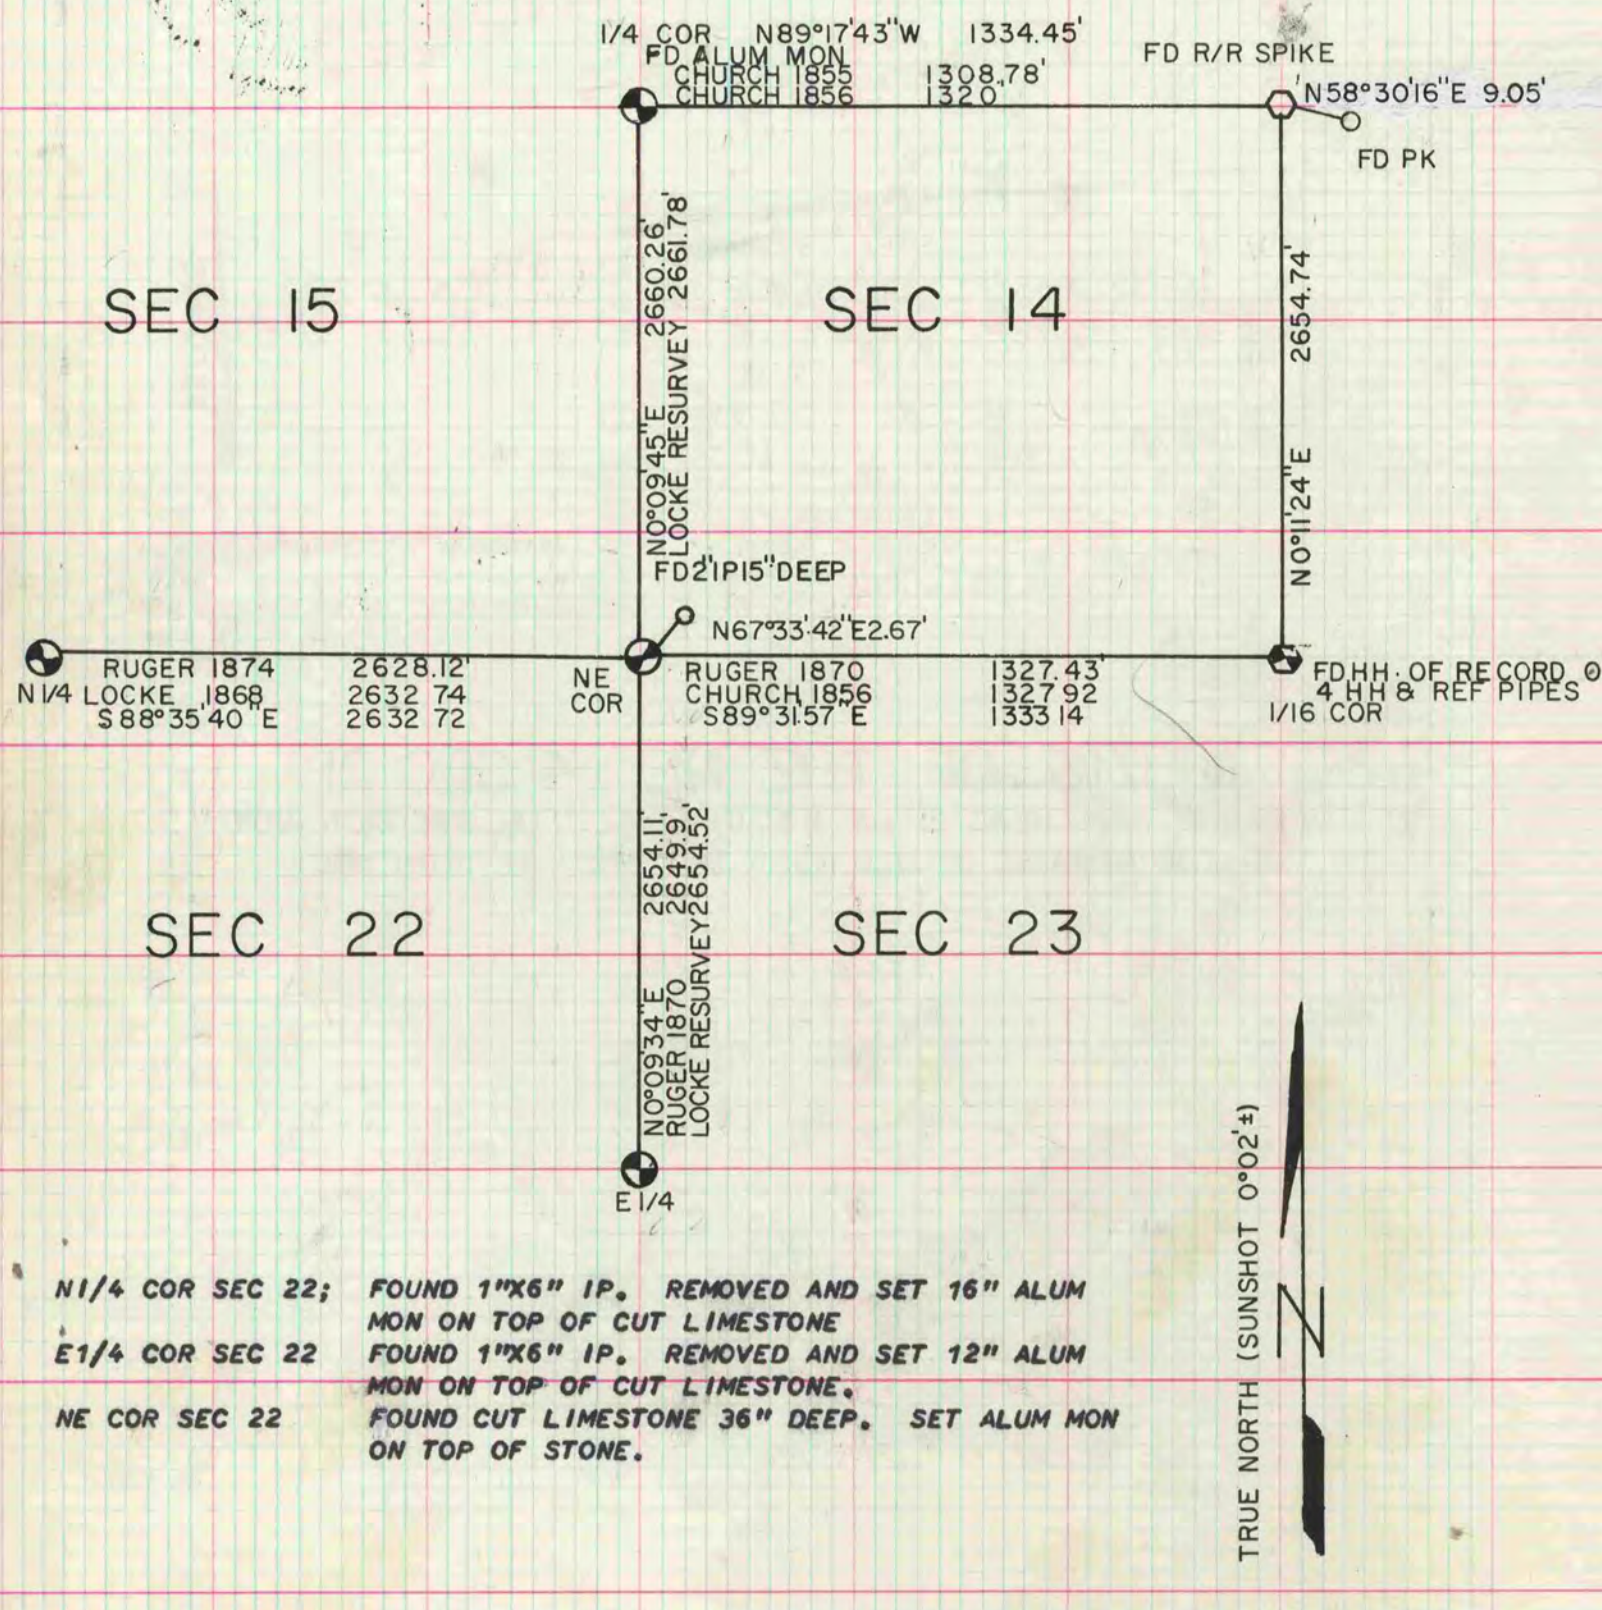

N1/4 COR SEC 22; FOUND 1"X6" IP. REMOVED AND SET 16" ALUM MON ON TOP OF CUT LIMESTONE

E1/4 COR SEC 22 FOUND 1"X6" IP. REMOVED AND SET 12" ALUM MON ON TOP OF CUT LIMESTONE.

NE COR SEC 22 FOUND CUT LIMESTONE 36" DEEP. SET ALUM MON ON TOP OF STONE.