MICROFILMED
COUNTY BUILDING
CITY OF JANESVILLE

PLAT AND RECORD

Of a Survey on Sections 31 + 32 T 4 R 11 E. of the 4 P. M. in Porter Township

Rock County, Wisconsin, made April the 22, 23 + 24 1874

I hereby certify that the following is a correct record of said survey as made by me.

(Signed) Edward Ruger
R.H.B. County Surveyor.

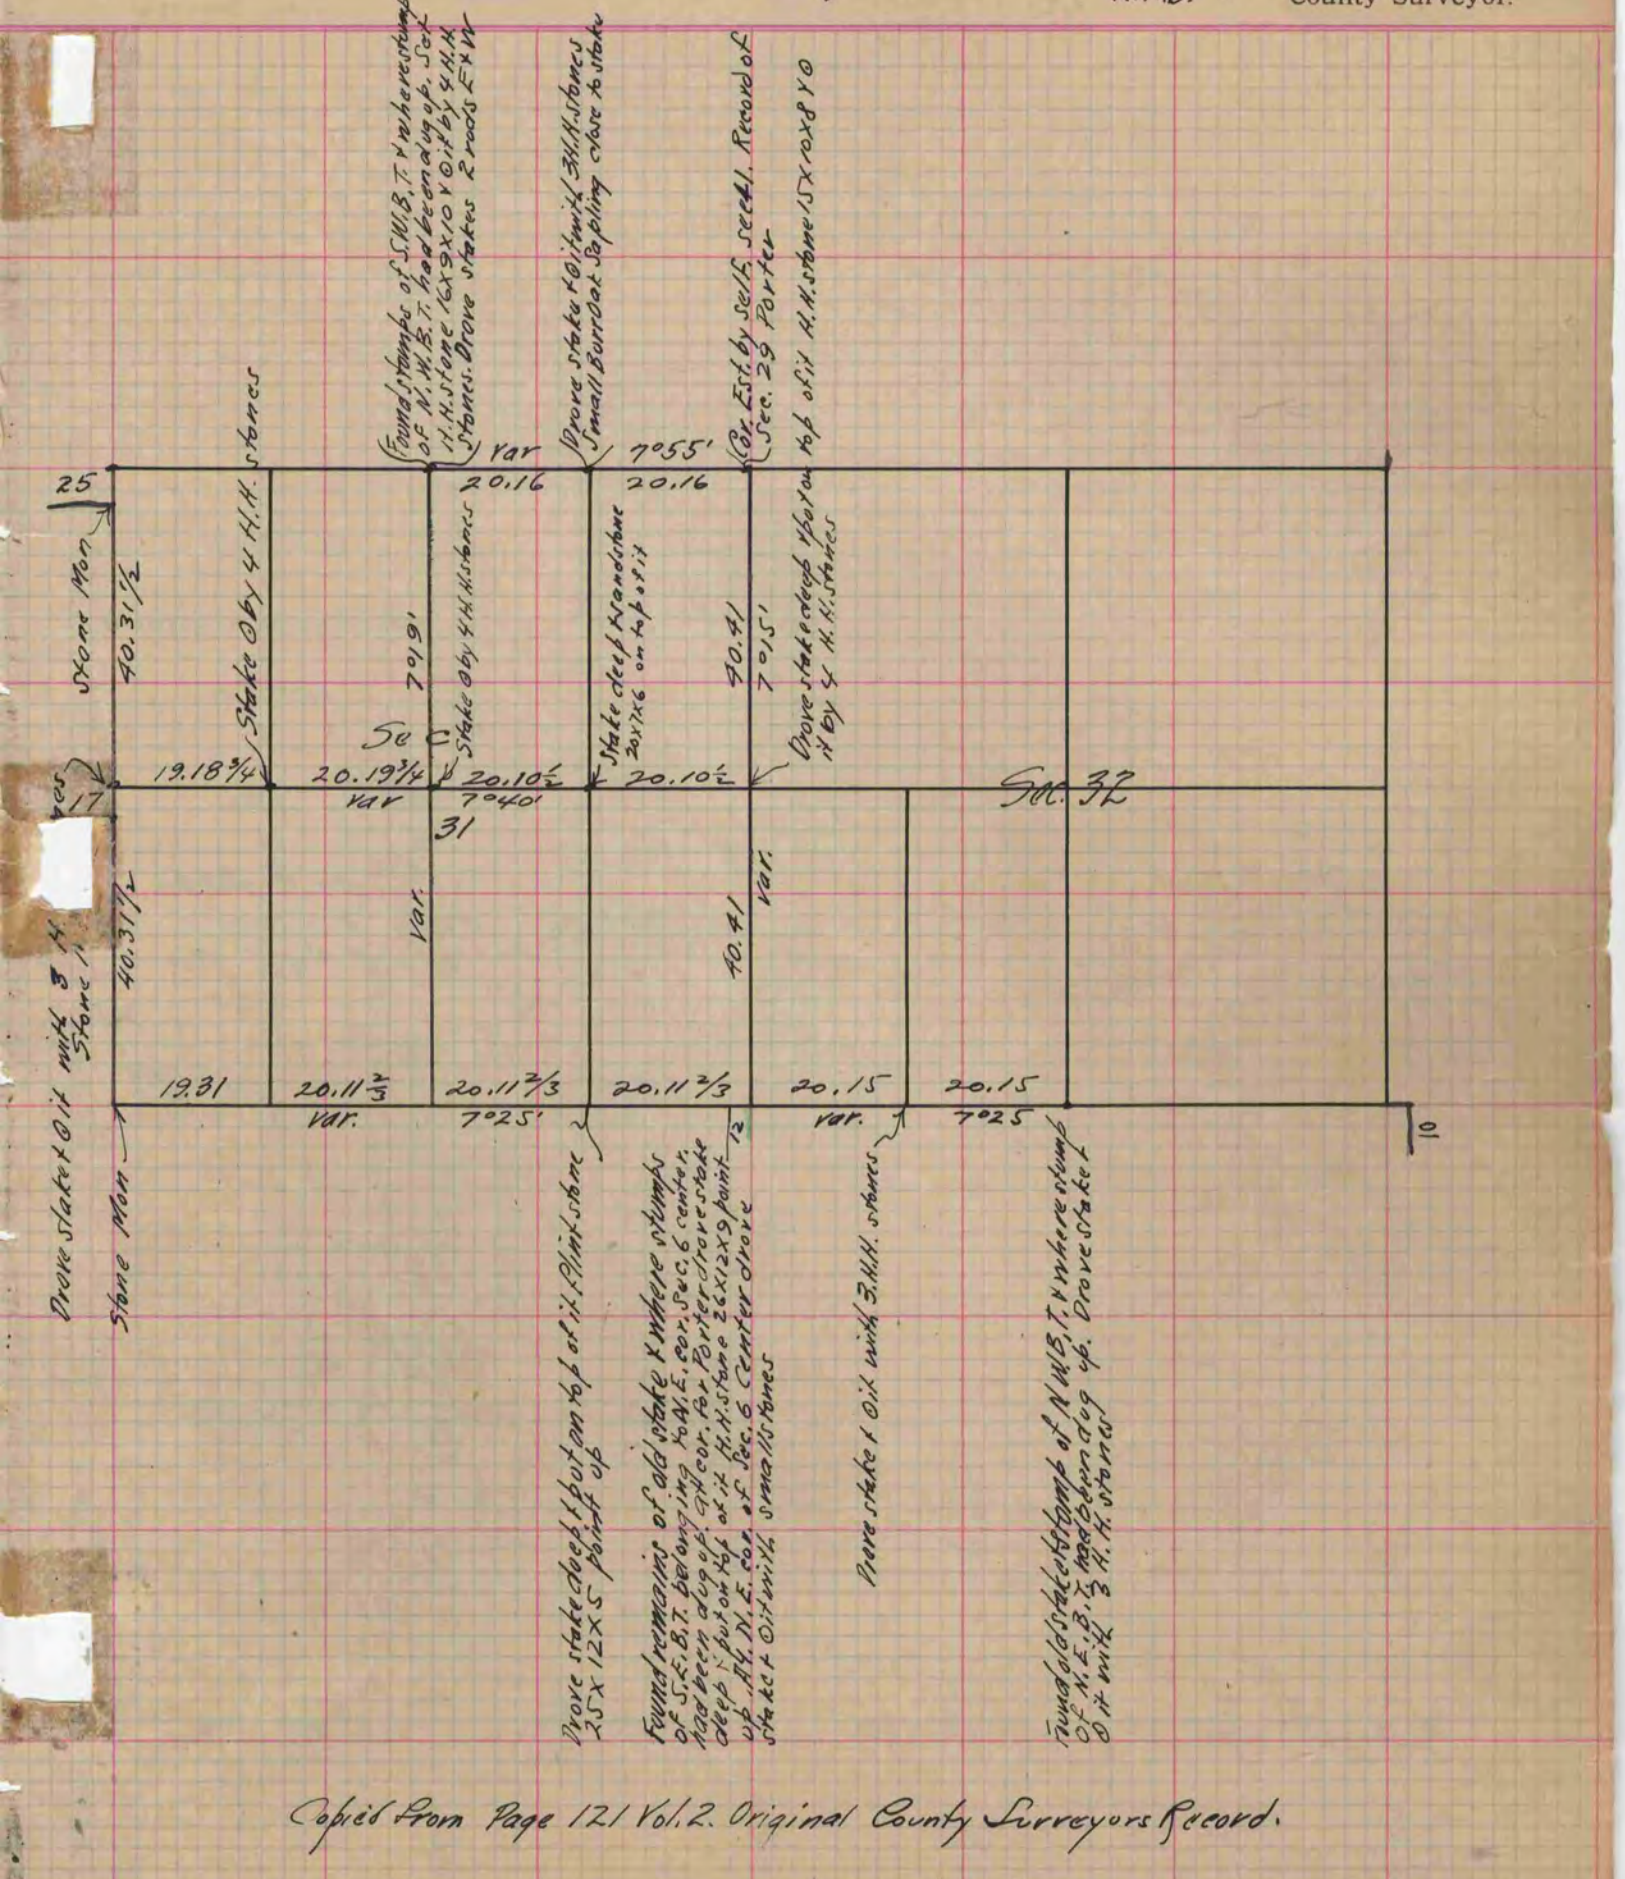

Copied from Page 121 Vol. 2. Original County Surveyors Record.