PLAT AND RECORD

295

VOL. 6

Of a Survey on Section 5,6 7, 8 T 4 R 14 E. of the 4 P.M. in LIMA Township

Rock County, Wisconsin, made JAN the 7 1983

I hereby certify that the following is a correct record of said survey as made by me.

COUNTY BUILDING
CITY OF JANESVILLE

WISCONSIN DONALD A. BARNES S-1216 JANESVILLE WI. LAND SURVEYOR

Donald Barnes
County Surveyor.
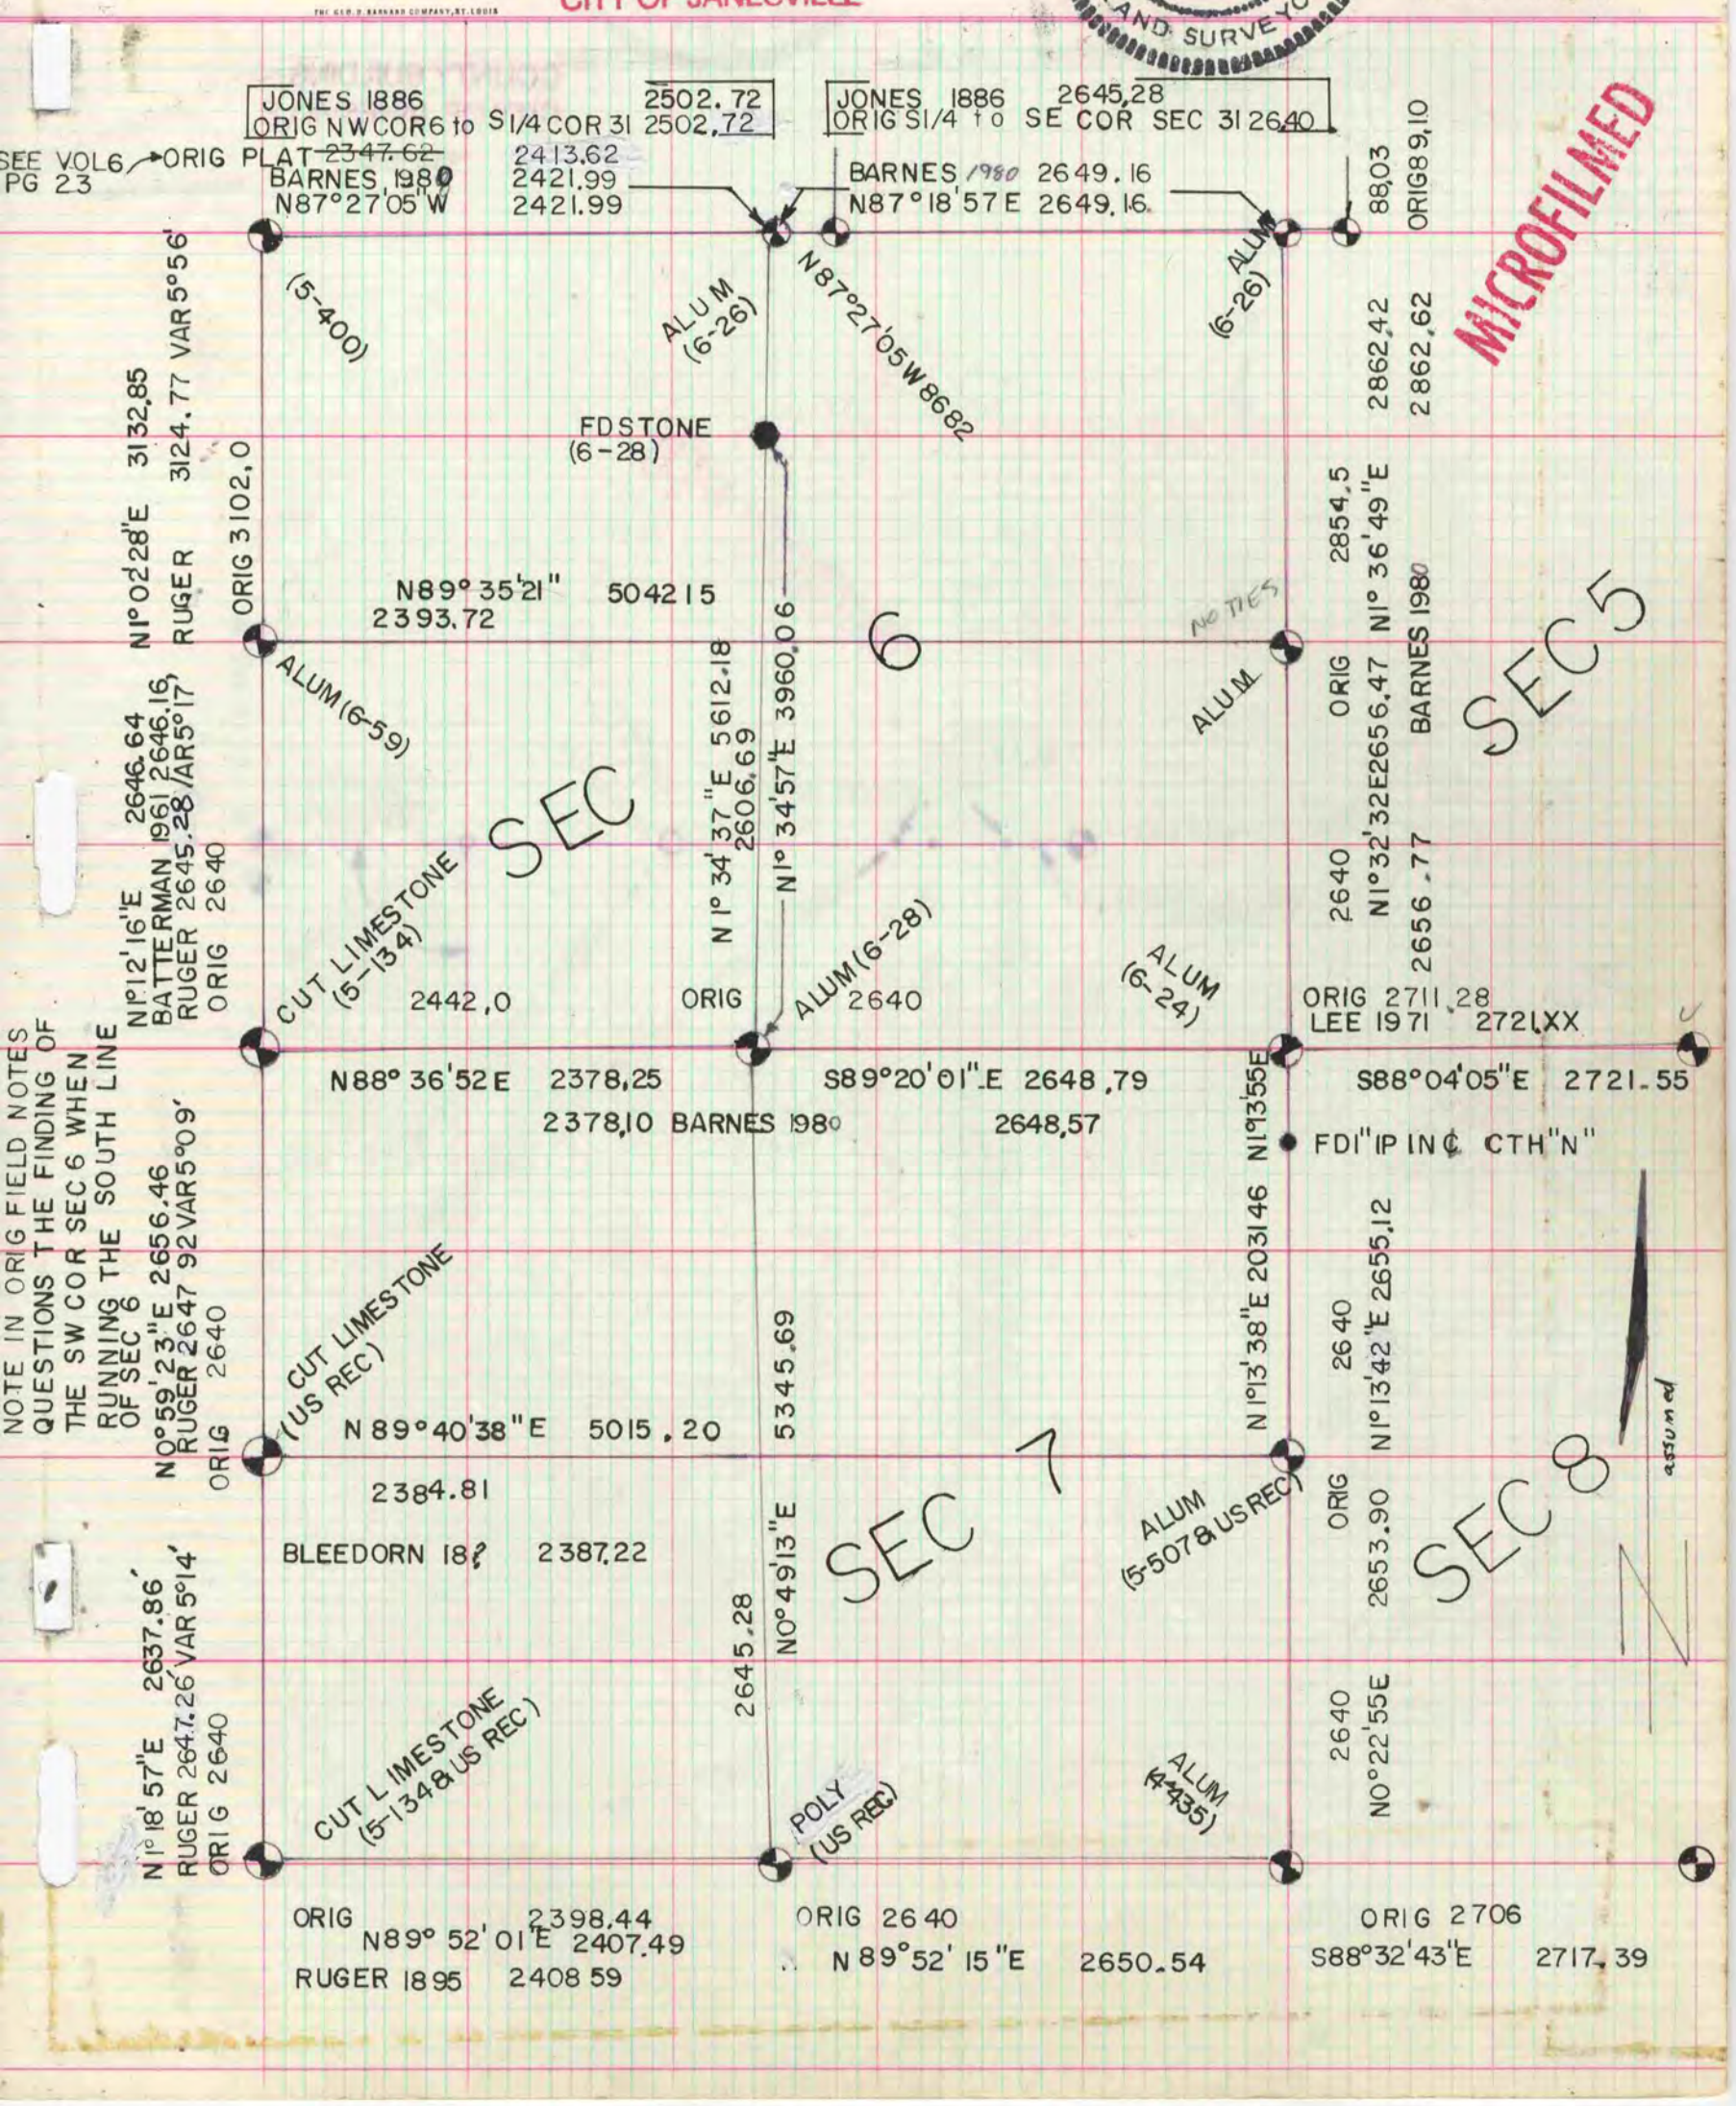
MICROFILMED