264

VOL. 6

PLAT AND RECORD

8-12 4 13 MILTON

Of a Survey on Section 5-8 T 4 R 14 E. of the 4 P. M. in LIMA Township

Rock County, Wisconsin, made APRIL the 22 82

I hereby certify that the following is a correct record of said survey as made by me.

RONALD A. BARNES S-2216 JANESVILLE WI. County Surveyor.

WISCONSIN RONALD A. BARNES S-2216 LAND SURVEYOR

COUNTY BUILDING
CITY OF JANESVILLE
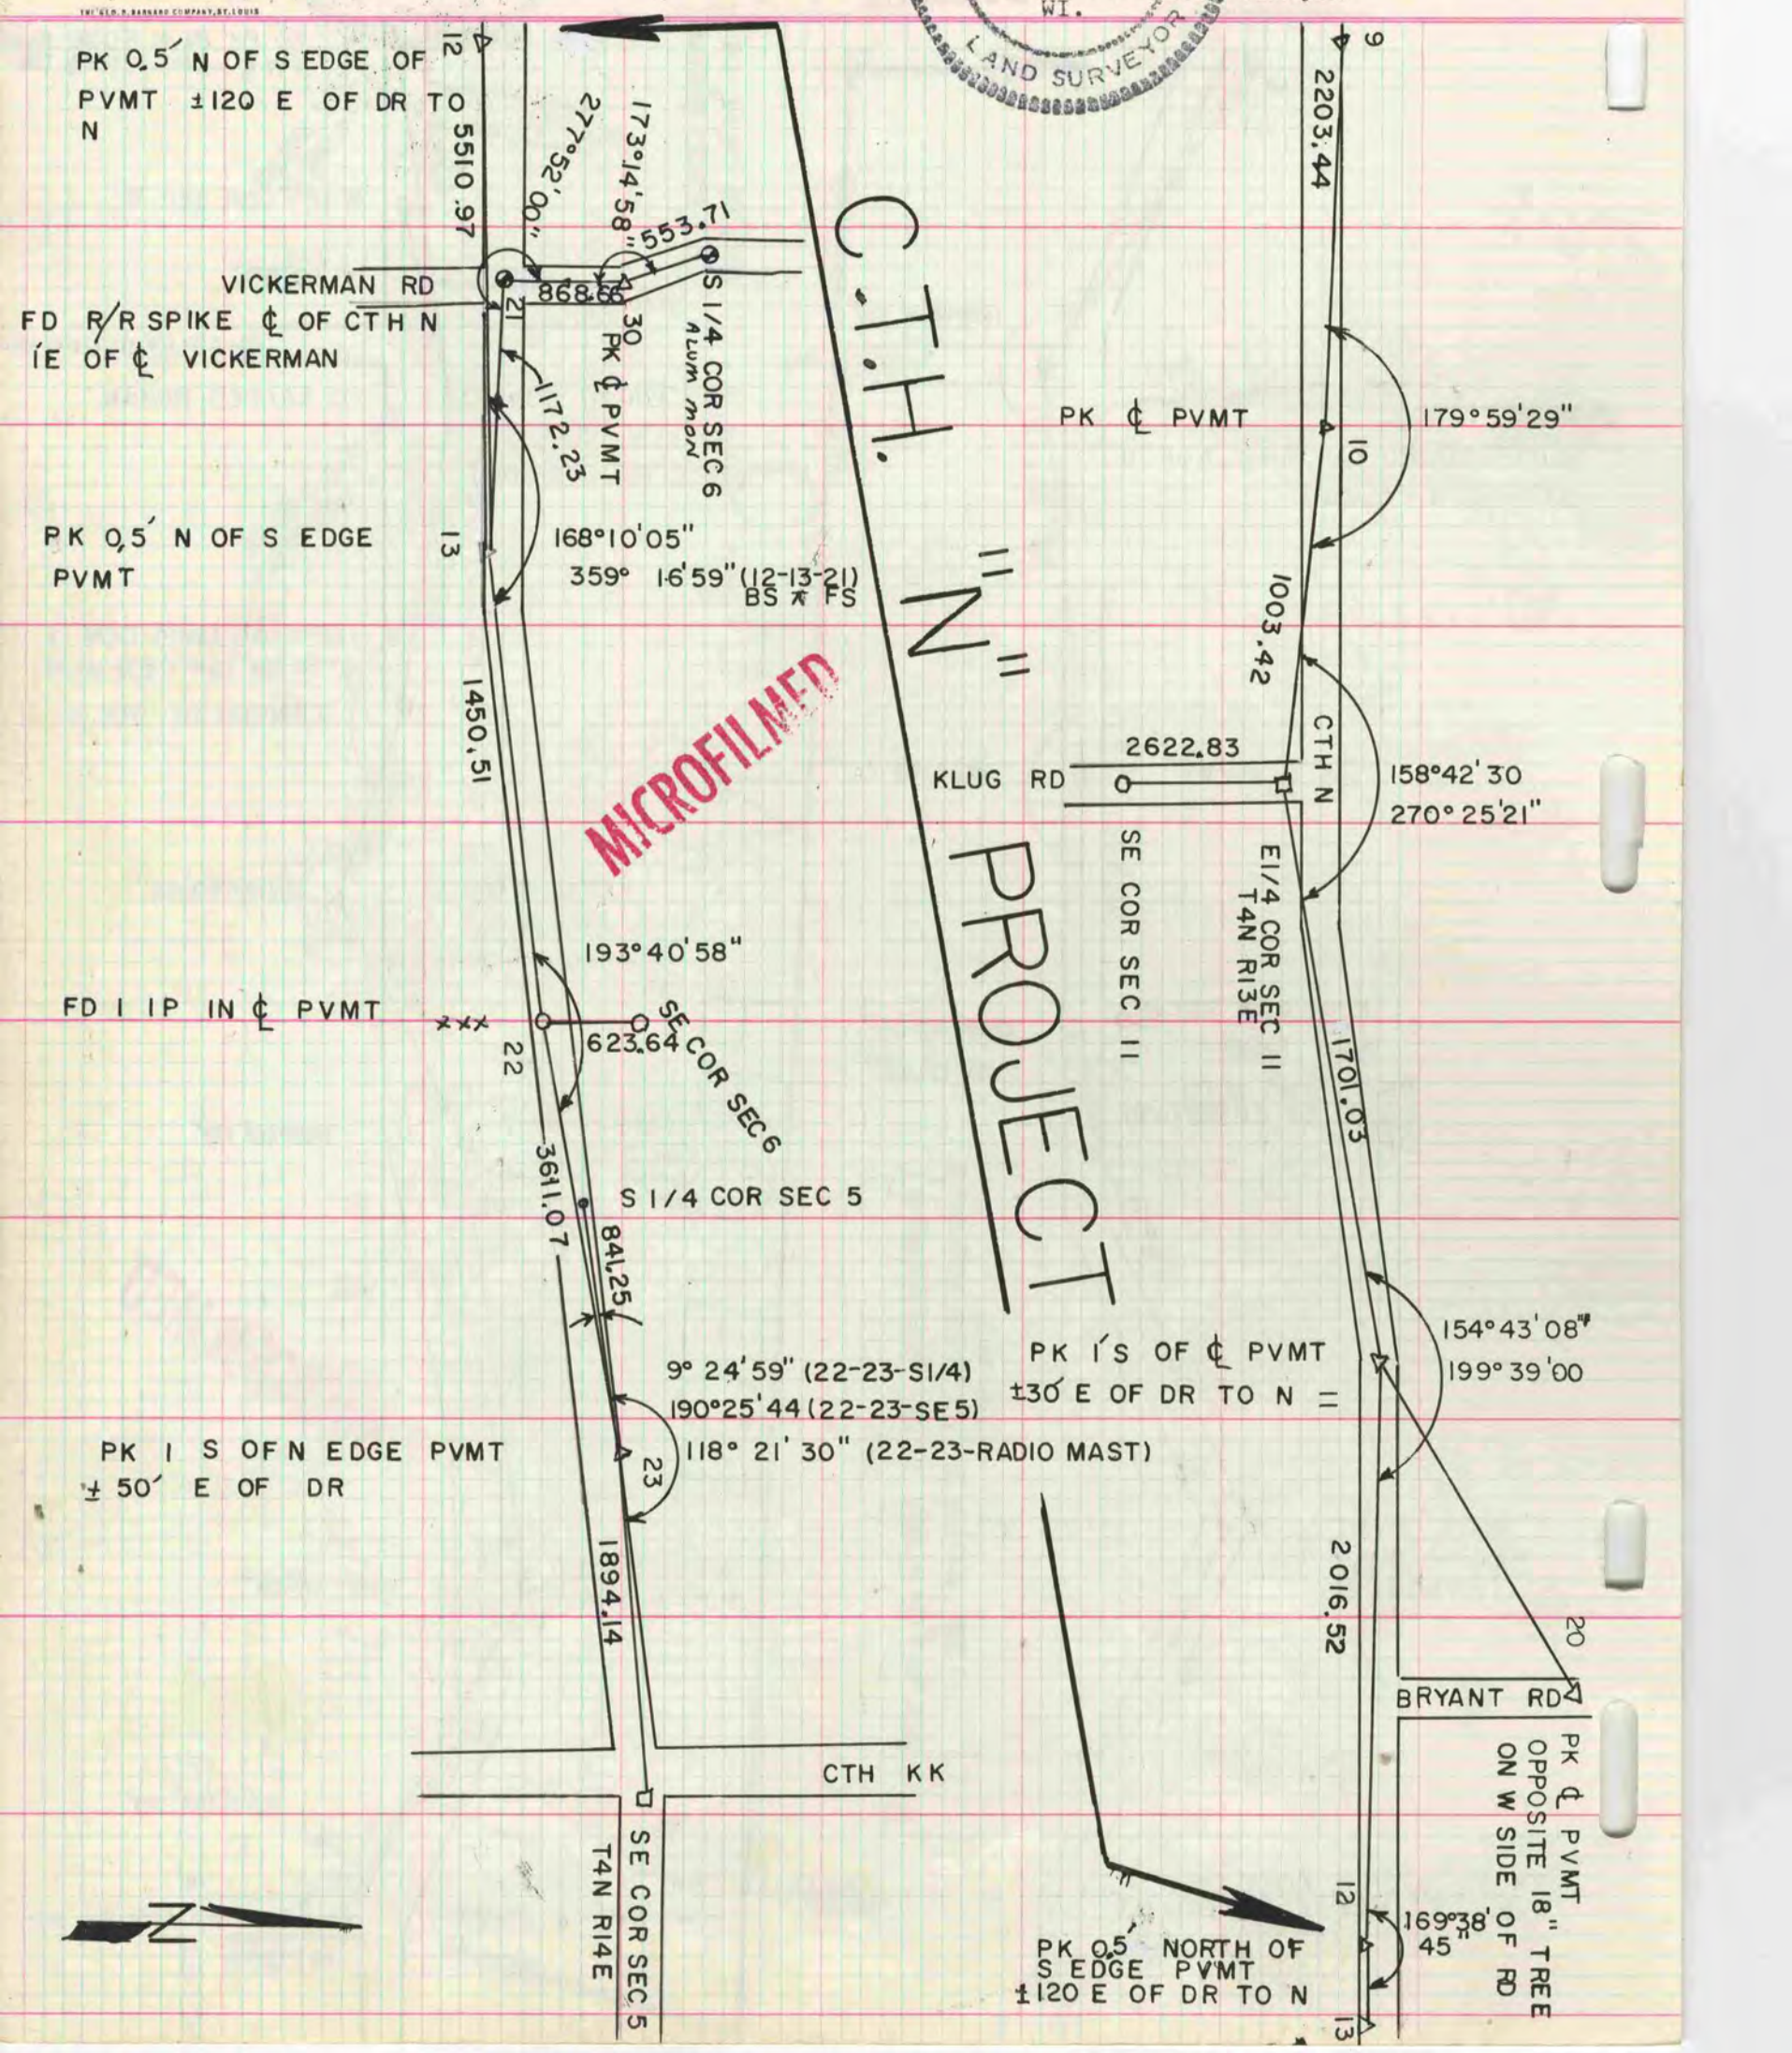
MICROFILMED