460
V-2

MICROFILMED

PLAT AND RECORD

Of a Survey on Section 23&24 T 3 R 12 E. of the 4 P. M. in Janesville Township

Rock County, Wisconsin, made Dec. 24-1891 – Oct. the 10. 1892

COUNTY BUILDING
CITY OF JANESVILLE

I hereby certify that the following is a correct record of said survey as made by me.

(Signed) O. G. Bleedorn Dep.
R. H. B. County Surveyor.

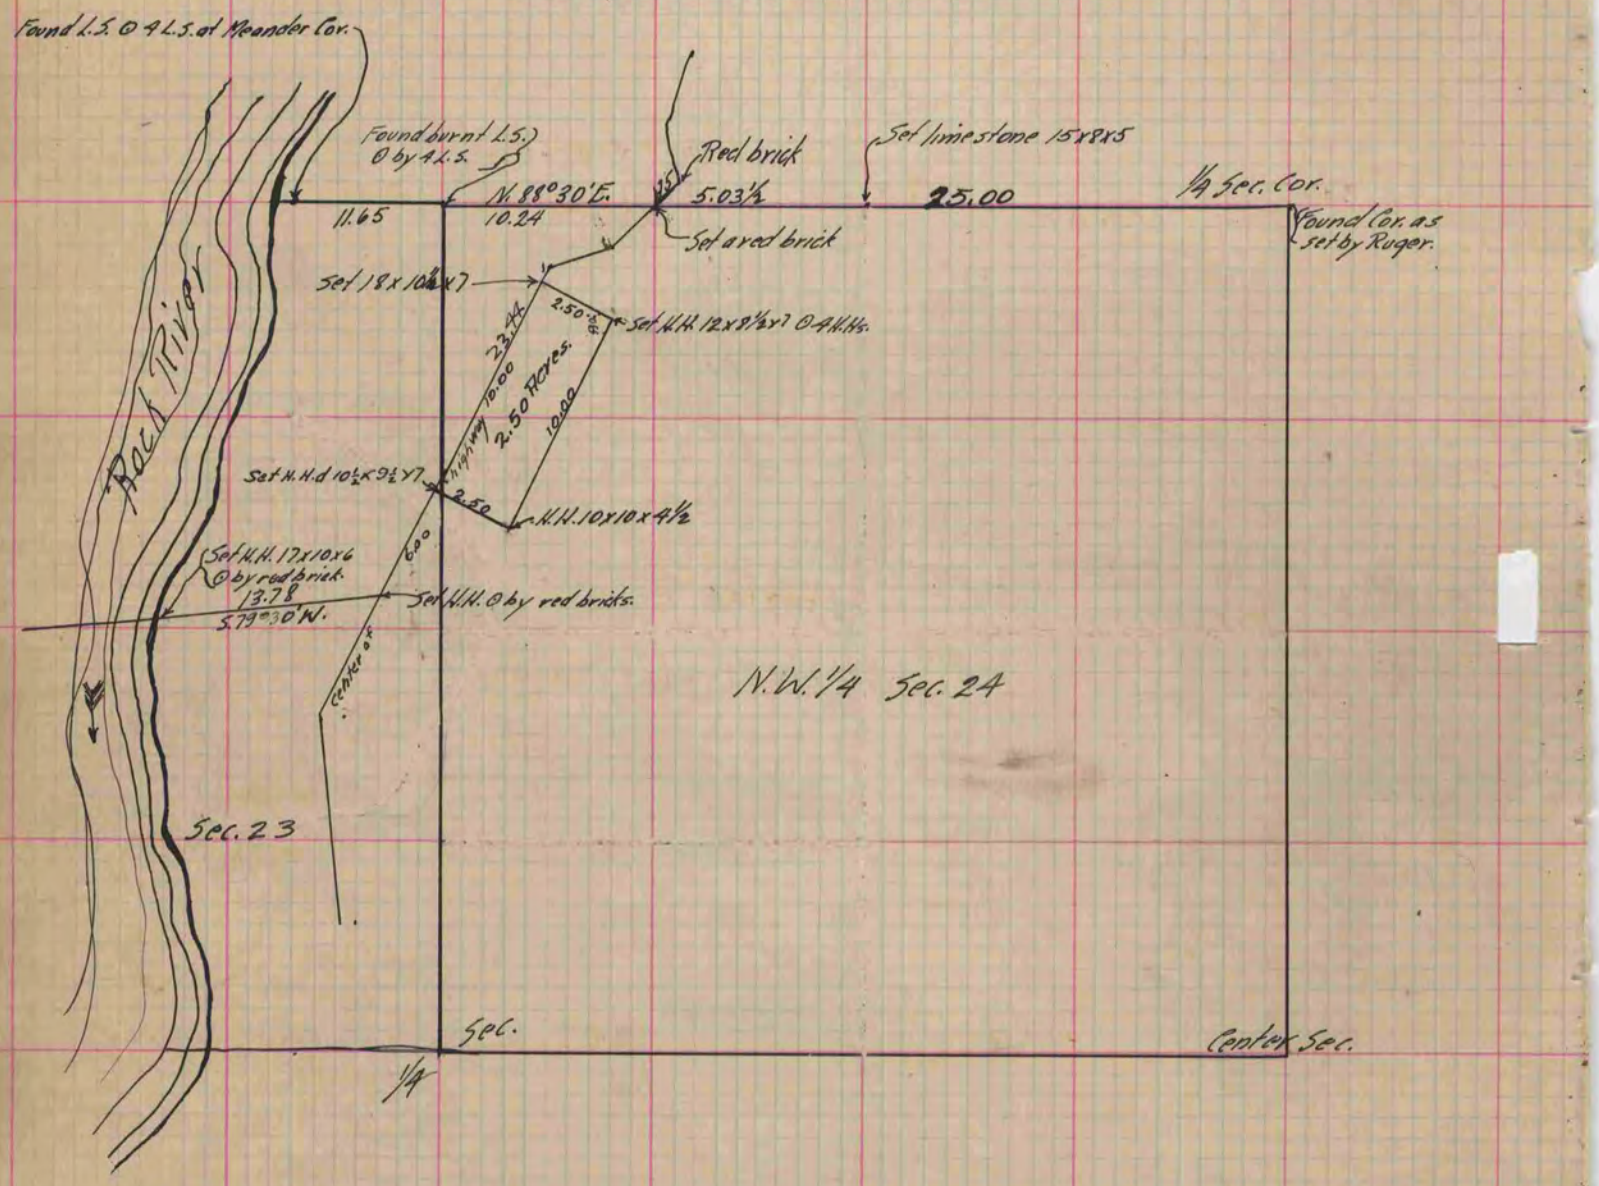

Copied from P. 364 Vol. 2. County Surveyors Record.