542
V-3 PG 543 BELOIT SET

PLAT AND RECORD

COUNTY BUILDING
CITY OF JANESVILLE

Of a Survey on Section 10 T____ R____ E. of the 4 P. M. in BELOIT Township

Rock County, Wisconsin, made_____ the_____ 19

I hereby certify that the following is a correct record of said survey as made by me.

MICROFILMED

_____
County Surveyor.
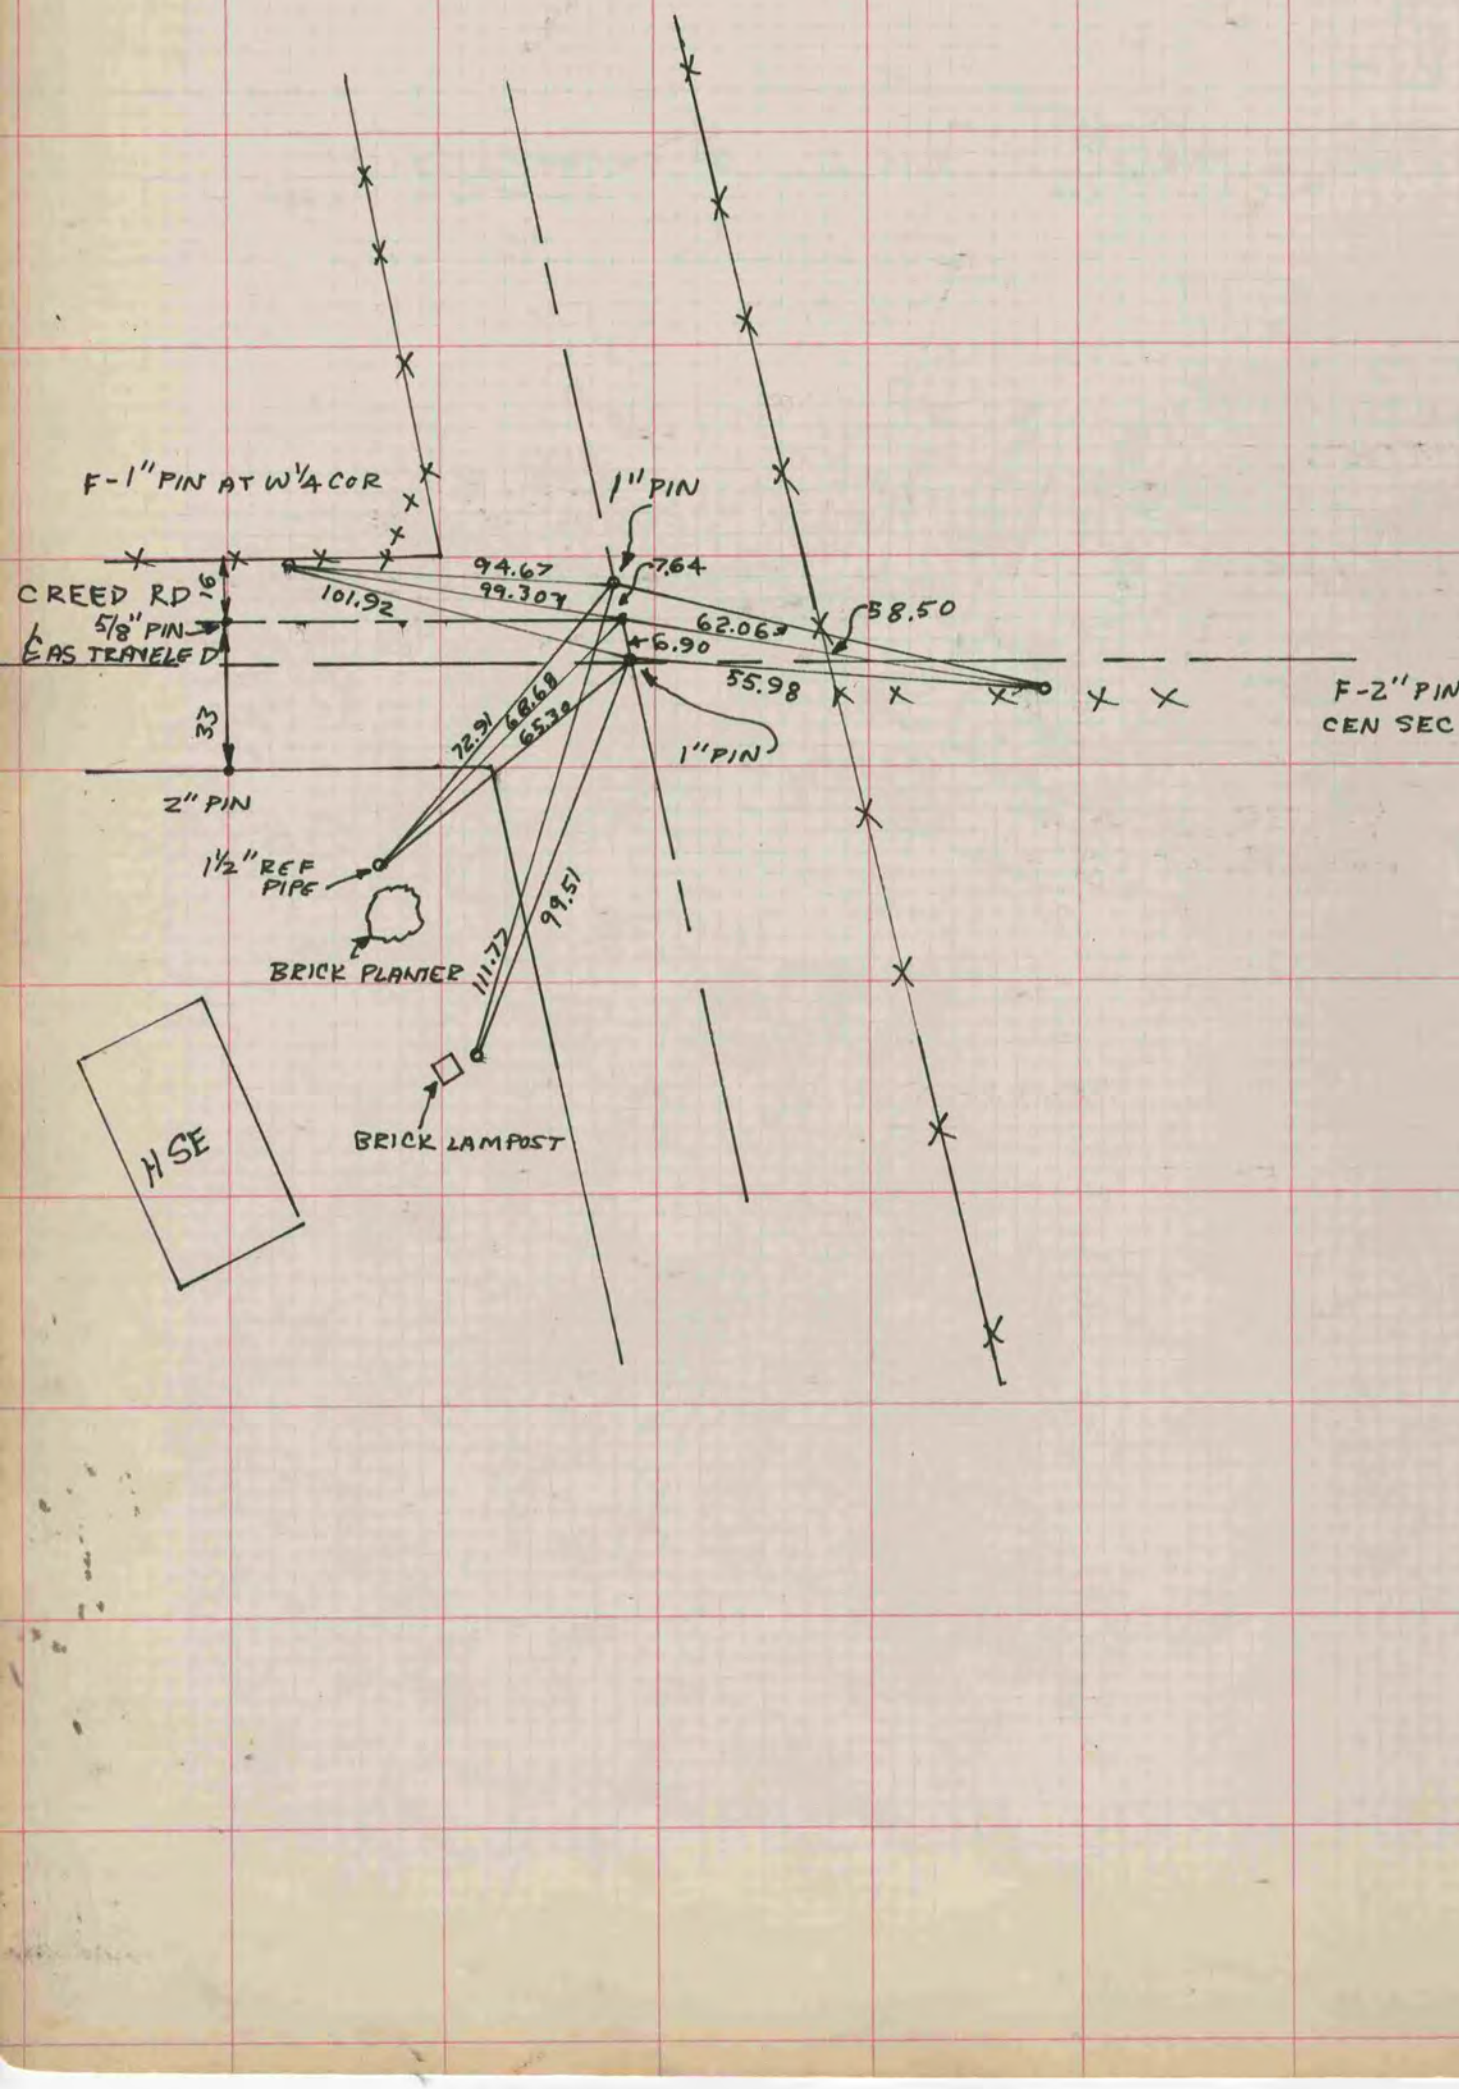
COPIED FROM BELOIT REC 12/16/75 DAB