254
V-2
MICROFILMED

PLAT AND RECORD

Of a Survey on Section 7 T 3 R 13 E. of the 4 P. M. in Harmony Township

Rock County, Wisconsin, made May 20 & the 21 1878

I hereby certify that the following is a correct record of said survey as made by me.

COUNTY BUILDING
CITY OF JANESVILLE

(Signed) Edward Ruger
R.H.B.
County Surveyor.

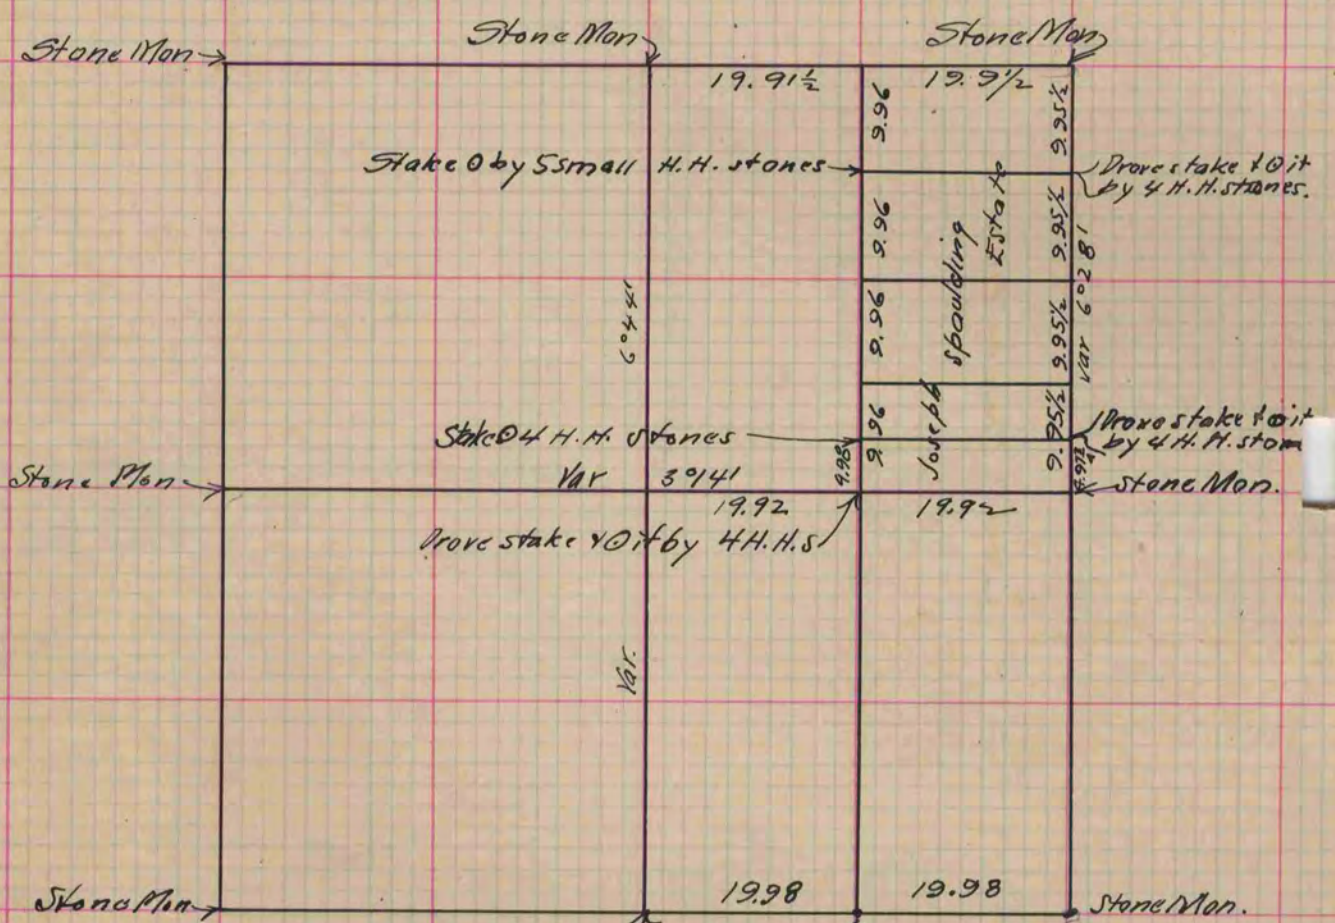

Copied from Page 208 Vol. 2. County Surveyors Record