206
V-2

MICROFILMED

PLAT AND RECORD

Of a Survey on Section 27 T 2 R 11 E. of the 4 P. M. in Plymouth Township

Rock County, Wisconsin, made March the 7, 8 & 9 1876

I hereby certify that the following is a correct record of said survey as made by me.

COUNTY BUILDING
CITY OF JANESVILLE

(Signed) Edward Ruger
R. H. B. County Surveyor.

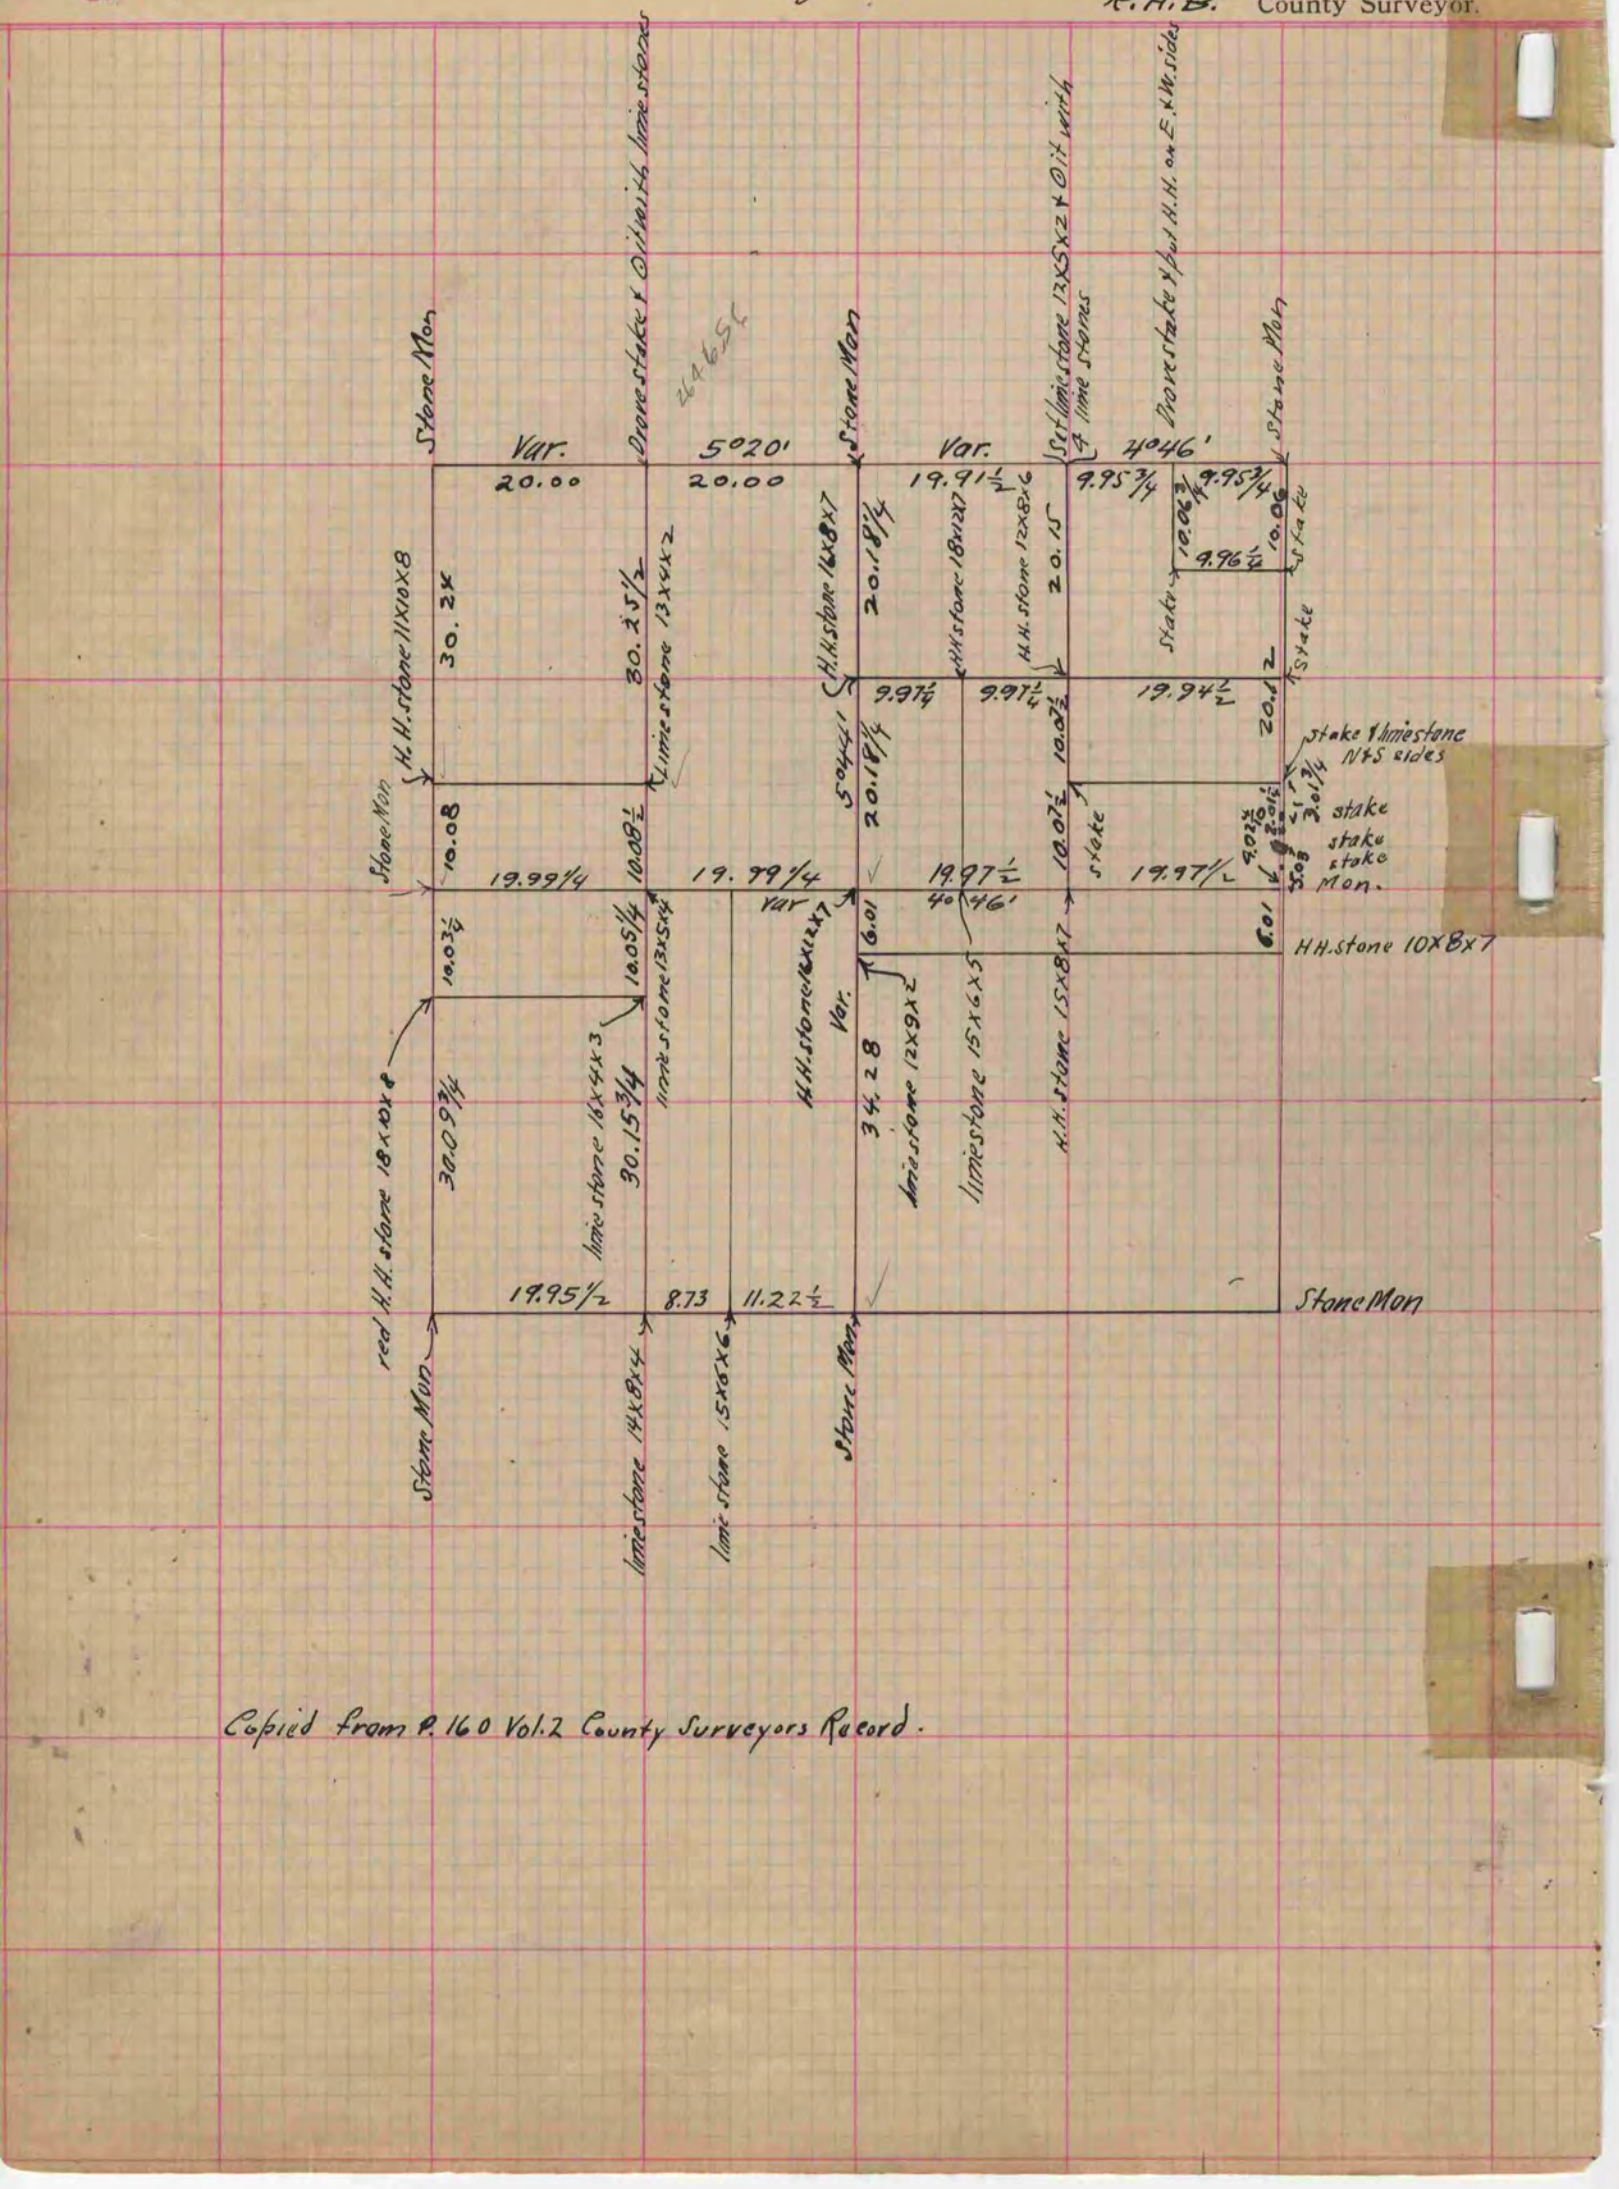

Copied from P. 160 Vol. 2 County Surveyors Record.