62
V-2

MICROFILMED

PLAT AND RECORD

Of a Survey on Section 26 T 3 R 12 E. of the 4 P. M. in Janesville Township

Rock County, Wisconsin, made April the 26 + 27 1871

I hereby certify that the following is a correct record of said survey as made by me.

COUNTY BUILDING
CITY OF JANESVILLE

(Signed) Edward Ruger
R.H.B.
County Surveyor.

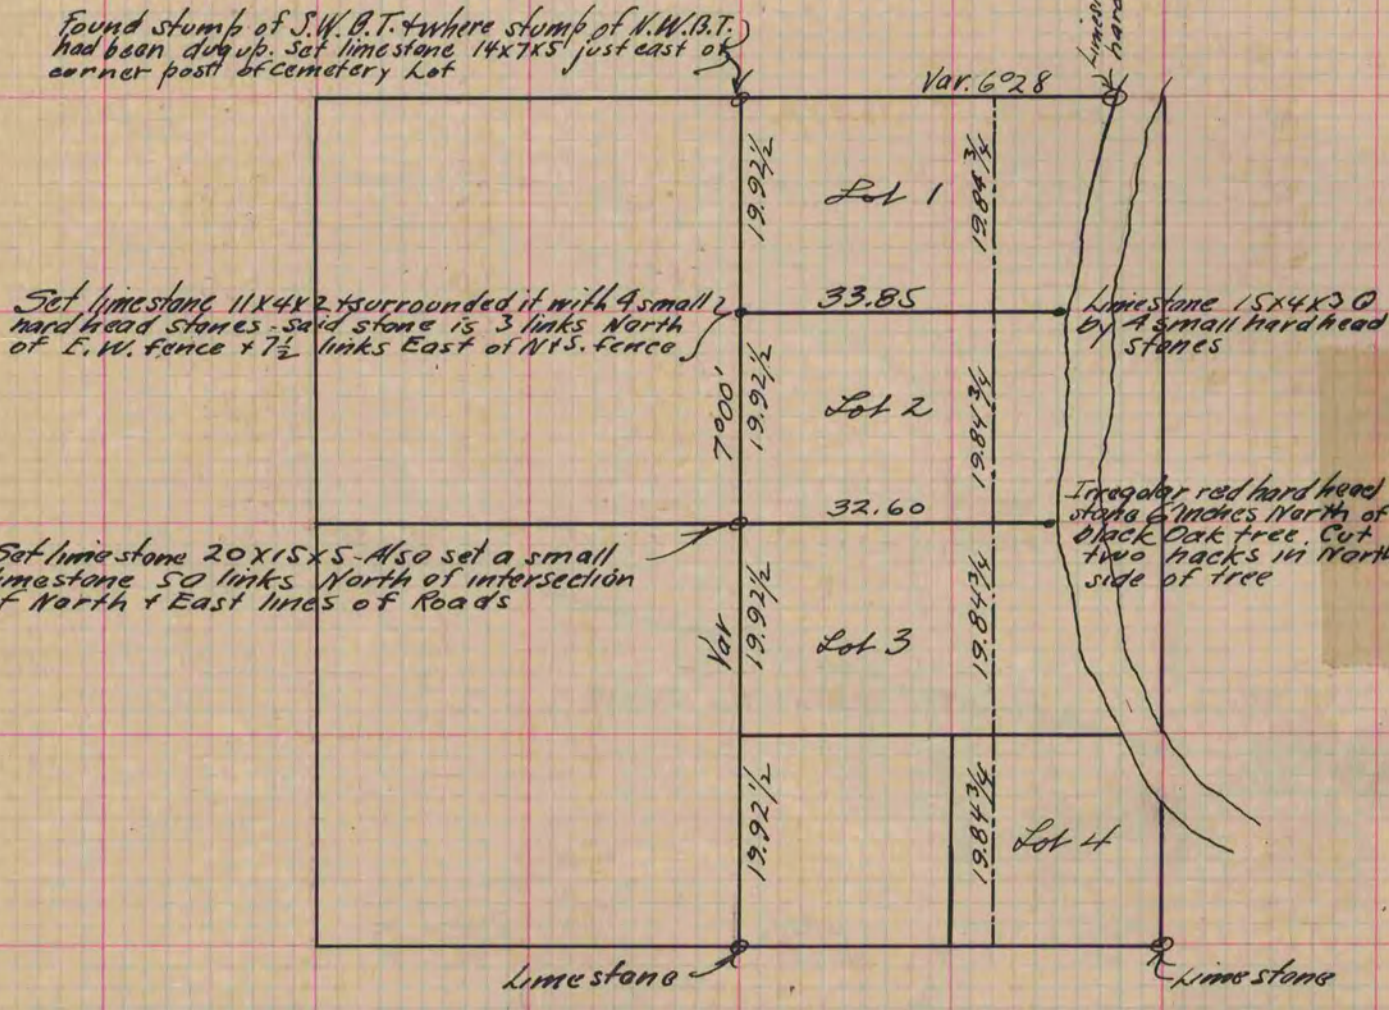

Copied from page 38 Vol. 2. Original County Surveyors Record