20
V-4

PLAT AND RECORD

COUNTY BUILDING
CITY OF JANESVILLE

Of a Survey on Section 30 T 1 N, R 14 E. of the 4 P. M. in CLINTON Township

Rock County, Wisconsin, made JUNE the 10th 1959

MICROFILMED

I hereby certify that the following is a correct record of said survey as made by me.

R. H. Baldwin Jr

County Surveyor.

THE GEO. D. BARNARD COMPANY, ST. LOUIS

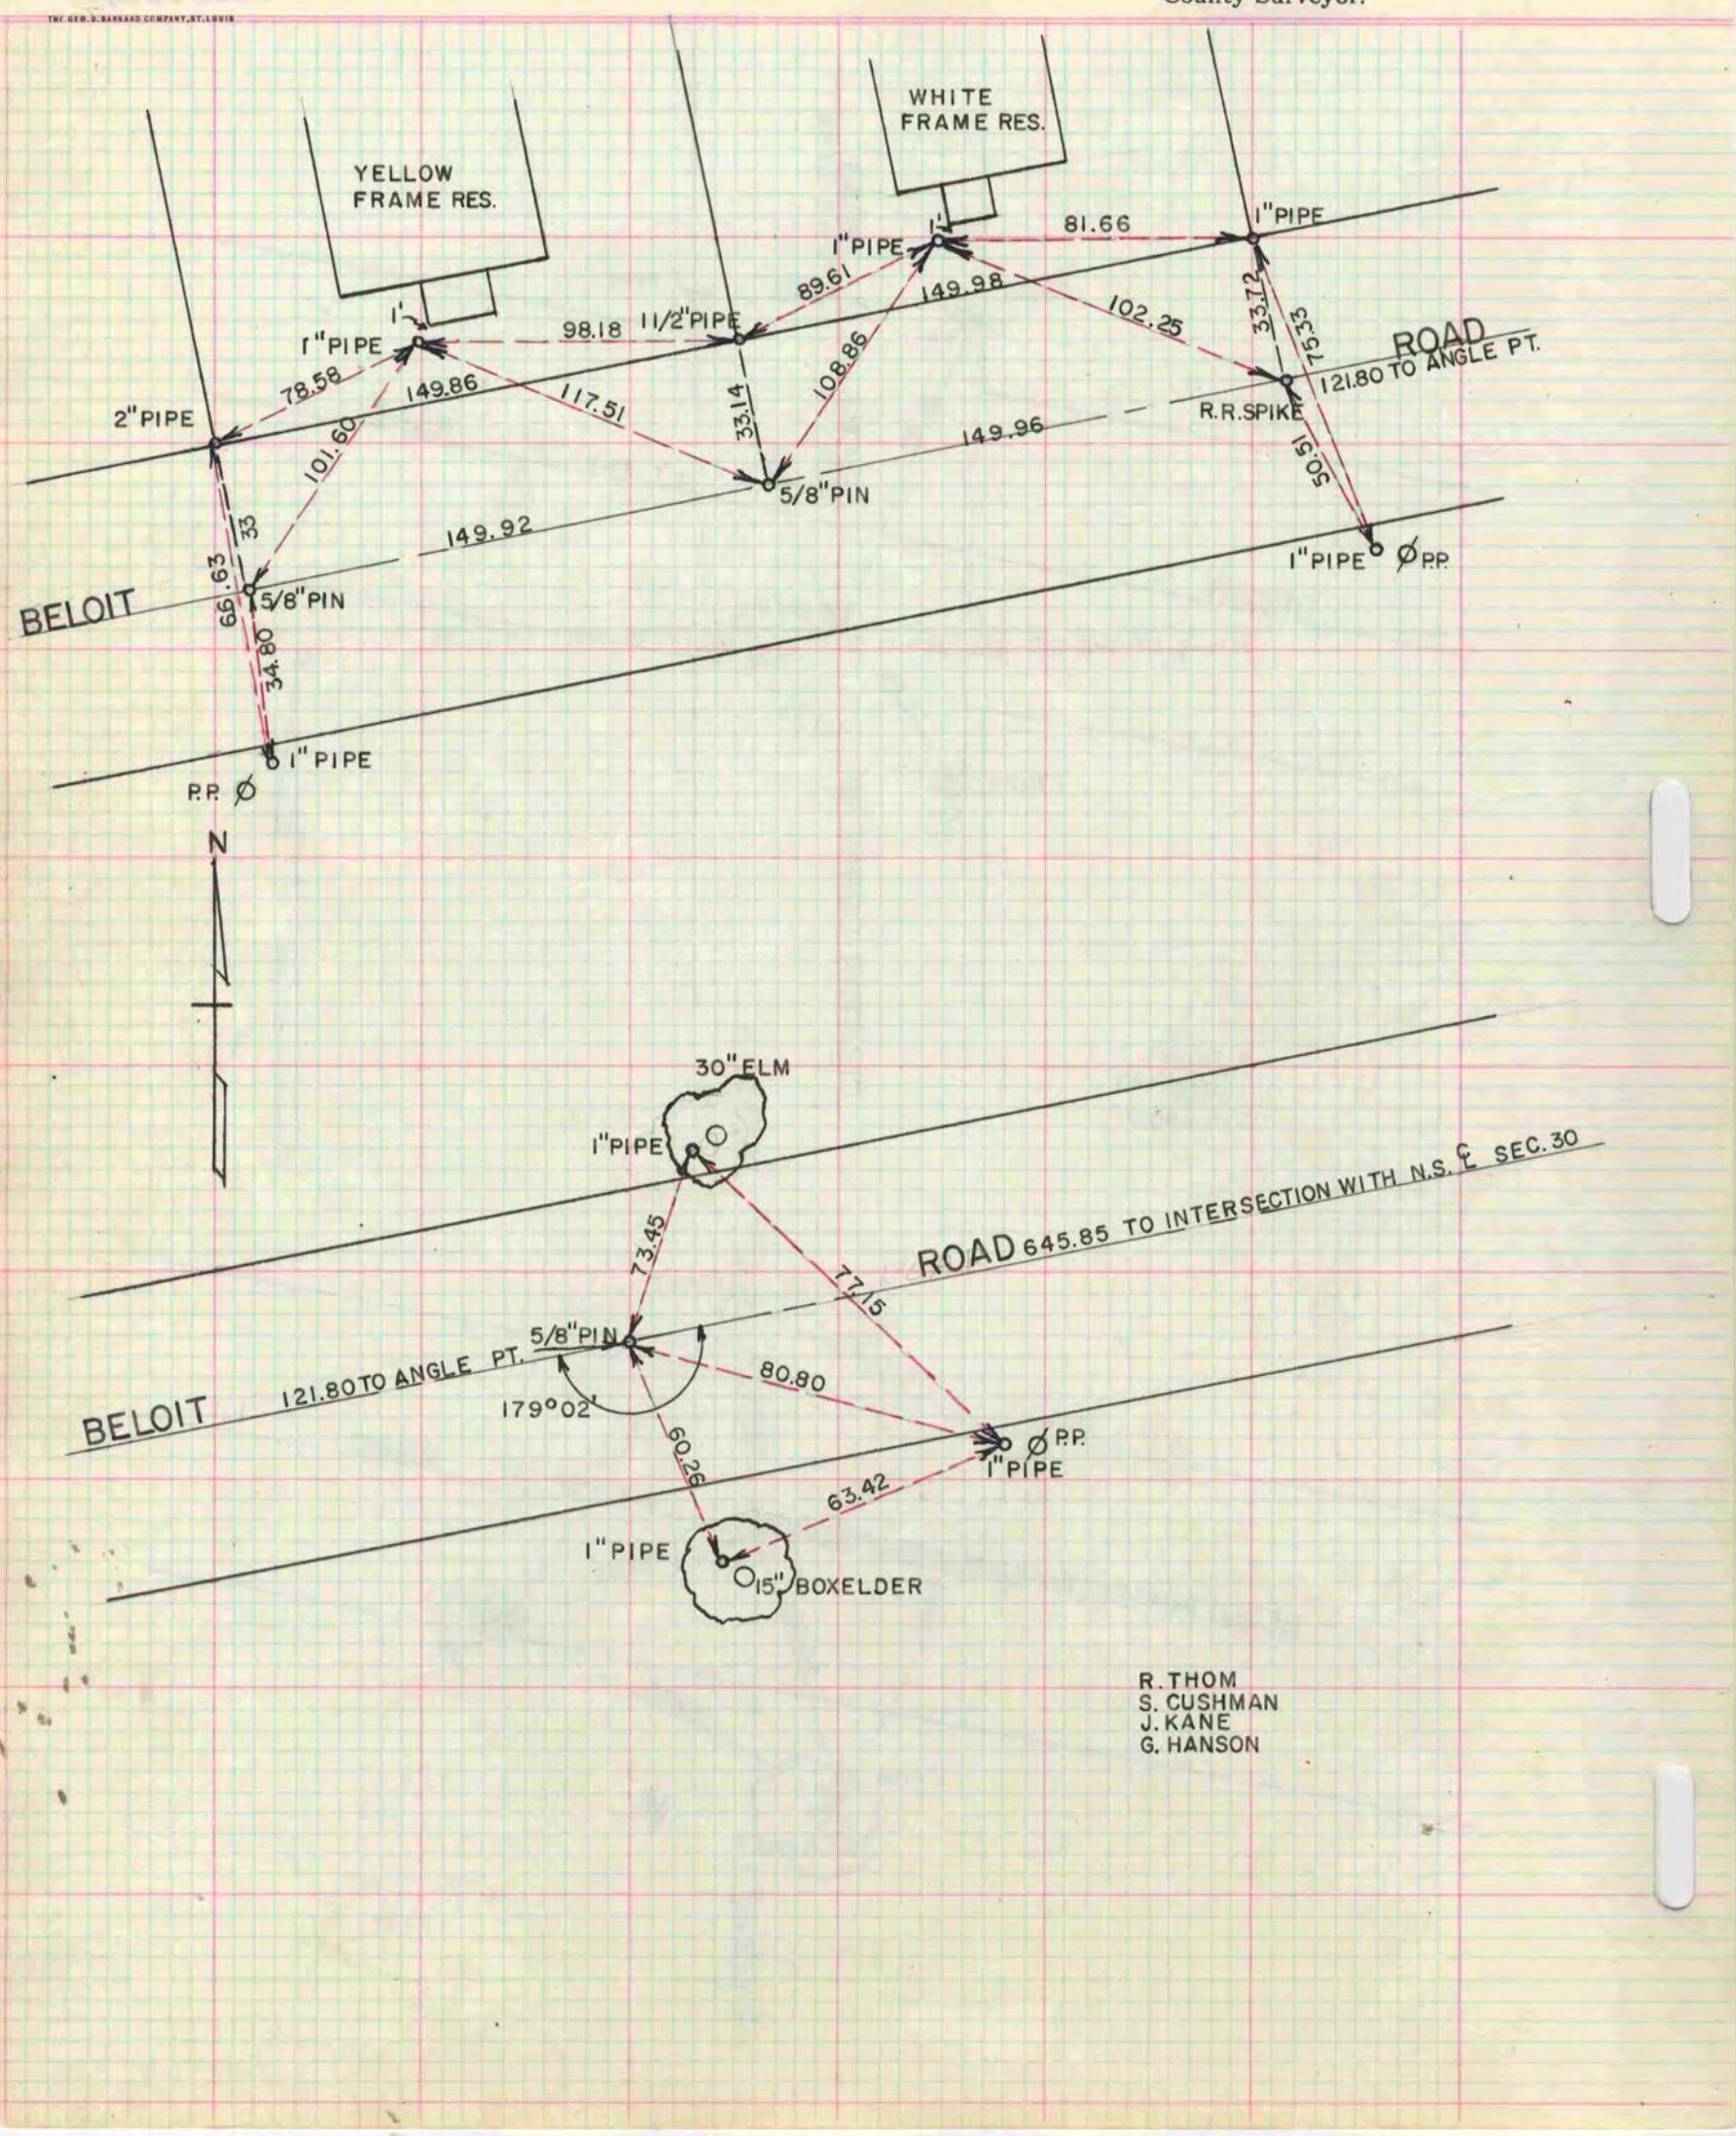

R. THOM
S. CUSHMAN
J. KANE
G. HANSON