410 of 507

V-2

MICROFILMED

PLAT AND RECORD

Of a Survey on Section 5 5 & 6 T 2 R 10 E. of the 4 P. M. in Spring Valley Township
" 4 " 31 & 32 T 3 R 10 Magnolia

Rock County, Wisconsin, made Dec. the 19 & 21 1882

I hereby certify that the following is a correct record of said survey as made by me.

COUNTY BUILDING
CITY OF JANESVILLE

(Signed) Edward Ruger
R.H.B
County Surveyor.

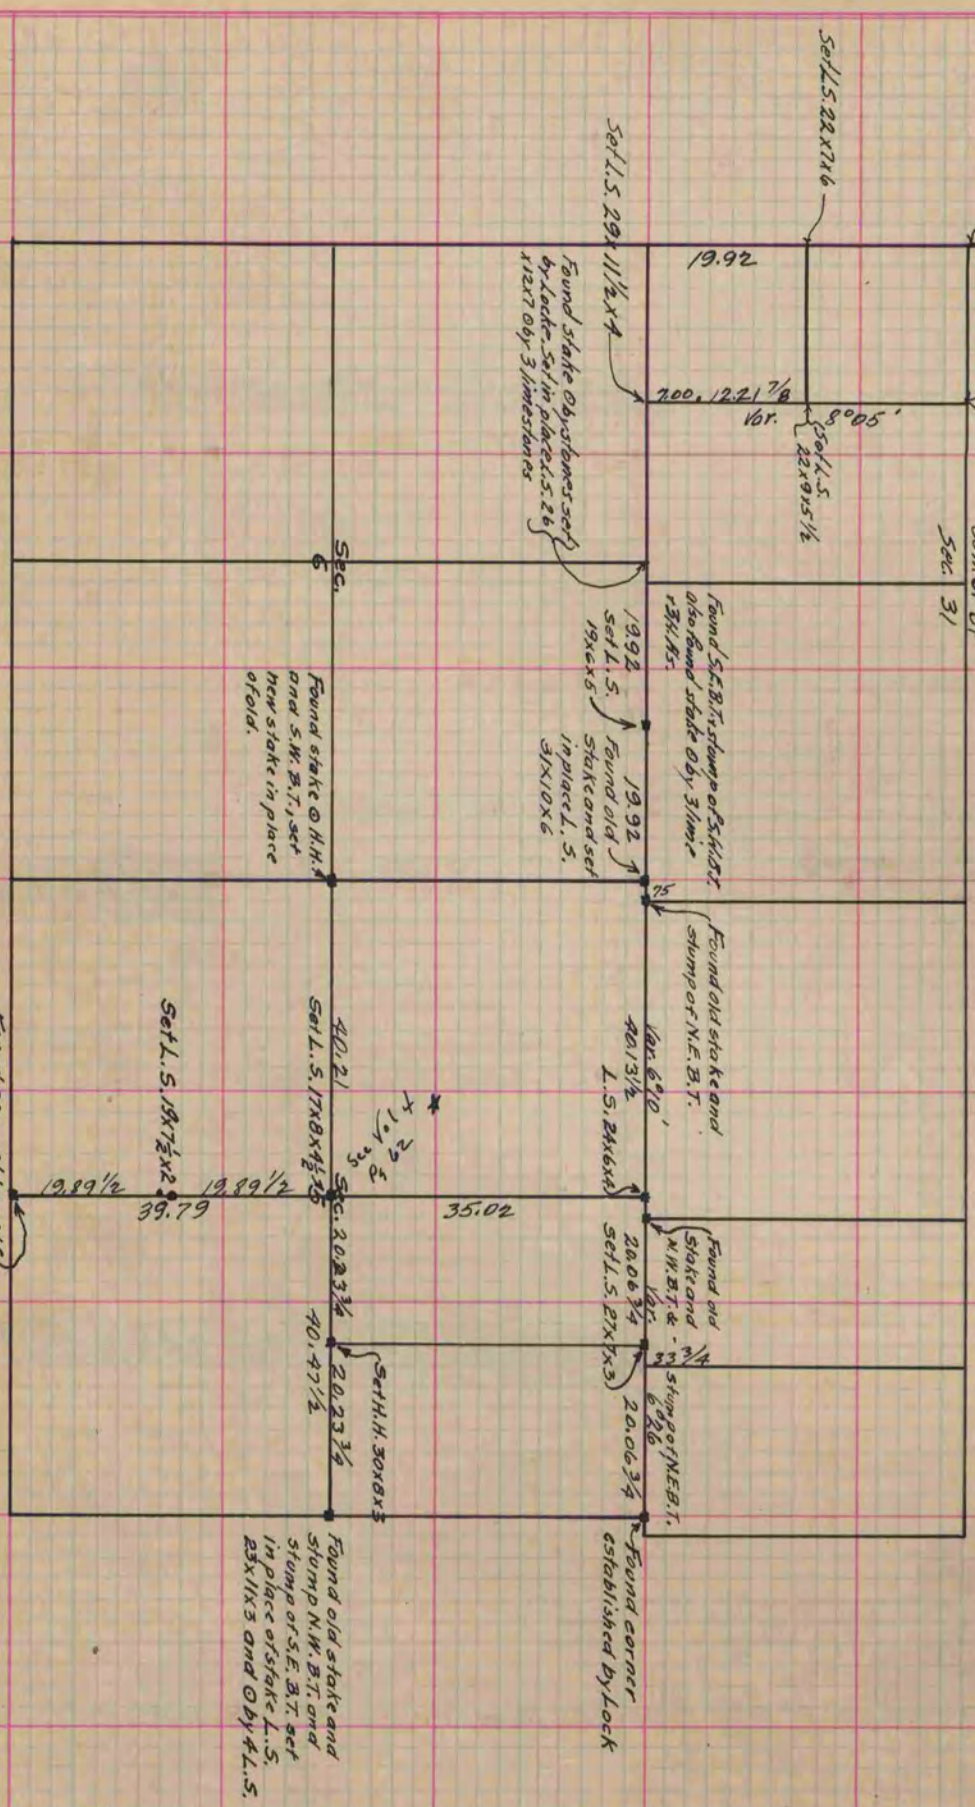

See P. 329 and 289 of this book and P. 257 of book 1

Copied from P. 332 Vol. 2 County Surveyors Record.

★ Copied from Beloit Records
12/11/75
G.O.

1