MICROFILMED

PLAT AND RECORD

COUNTY BUILDING
CITY OF JANESVILLE

Of a Survey on Section 5 T 3 R 13 E. of the 4 P. M. in Harmony Township

Rock County, Wisconsin, made June the 5th 1872

I hereby certify that the following is a correct record of said survey as made by me.

(Signed) R. K. Lee
R. H. B.
County Surveyor.

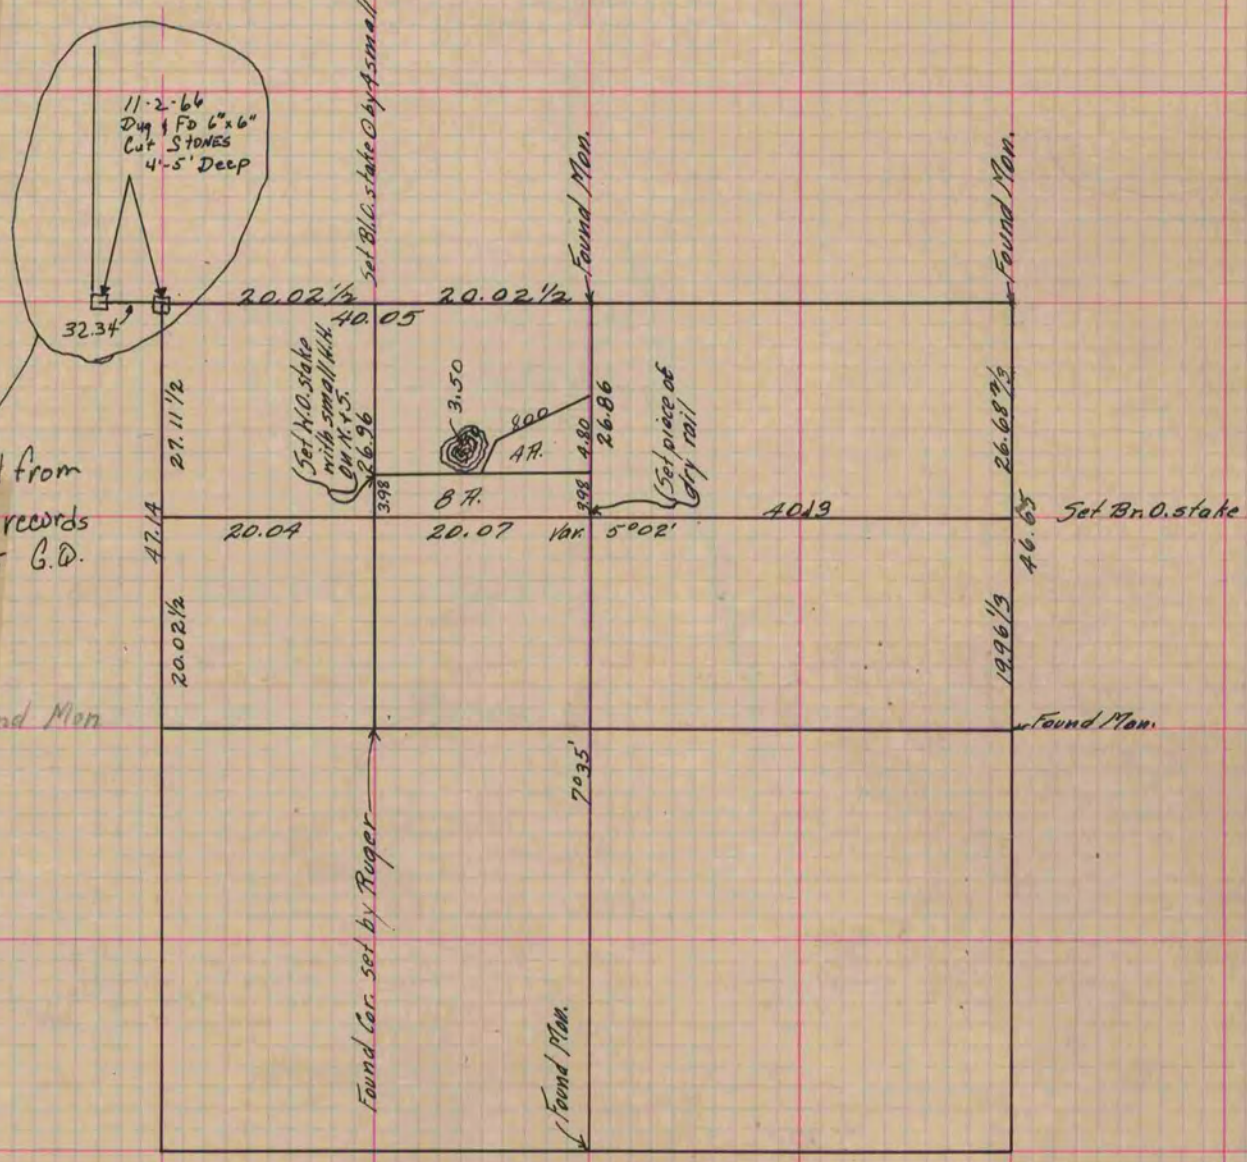

Copied from Upper ½ of Page 52 Vol. 2 Original County Surveyor's Record.