MICROFILMED
COUNTY BUILDING
CITY OF JANESVILLE

PLAT AND RECORD

Of a Survey on Section 5 T 3 R 11 E. of the 4 P. M. in Center Township

Rock County, Wisconsin, made April the 12 1875

I hereby certify that the following is a correct record of said survey as made by me.

(Signed) Edward Ruger
R. H. B.
County Surveyor.

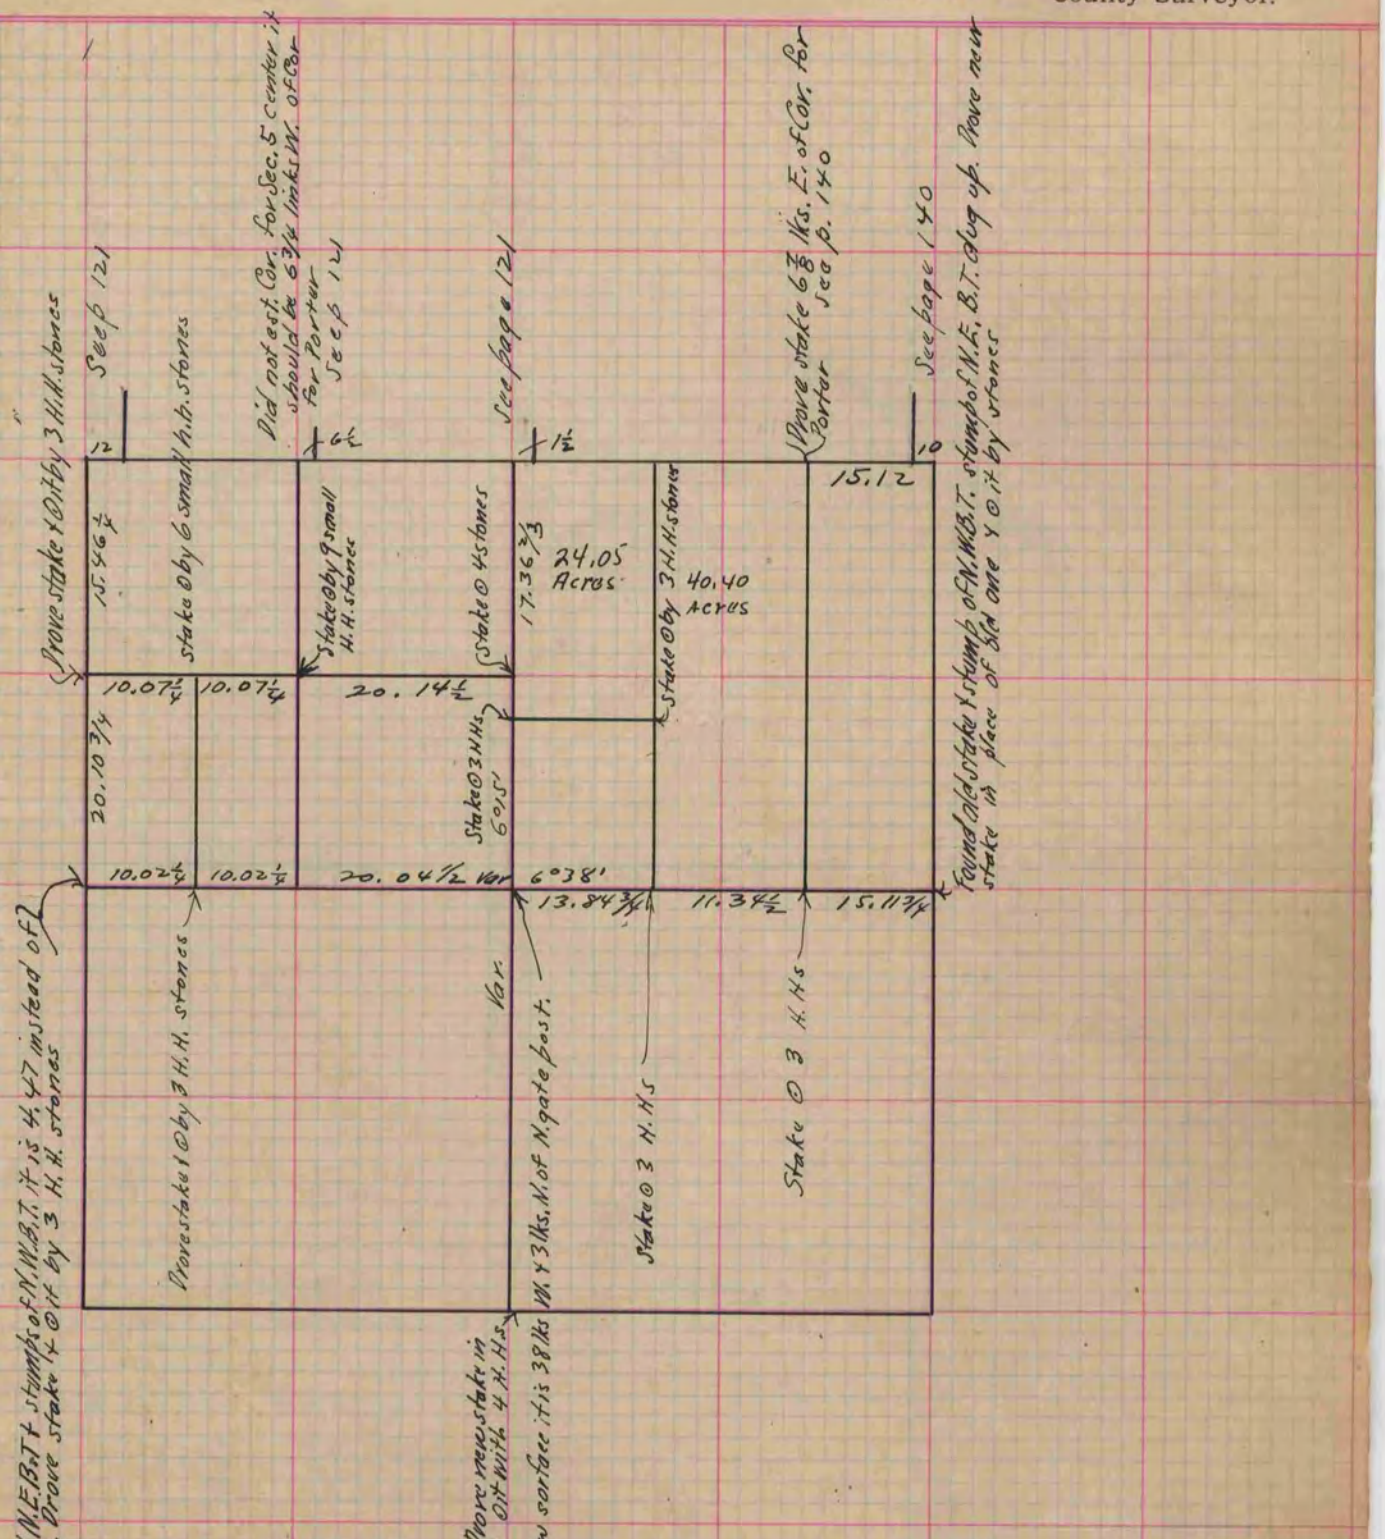

Copied from page 141 Vol. 2 Original County Surveyors Record