MICROFILMED

COUNTY BUILDING
CITY OF JANESVILLE

PLAT AND RECORD

Of a Survey on Section 20 T 4 R 12 E. of the 4 P. M. in Fulton Township

Rock County, Wisconsin, made April the 30 1886

I hereby certify that the following is a correct record of said survey as made by me.

(Signed) Edward Ruger
R. H. B.
County Surveyor.

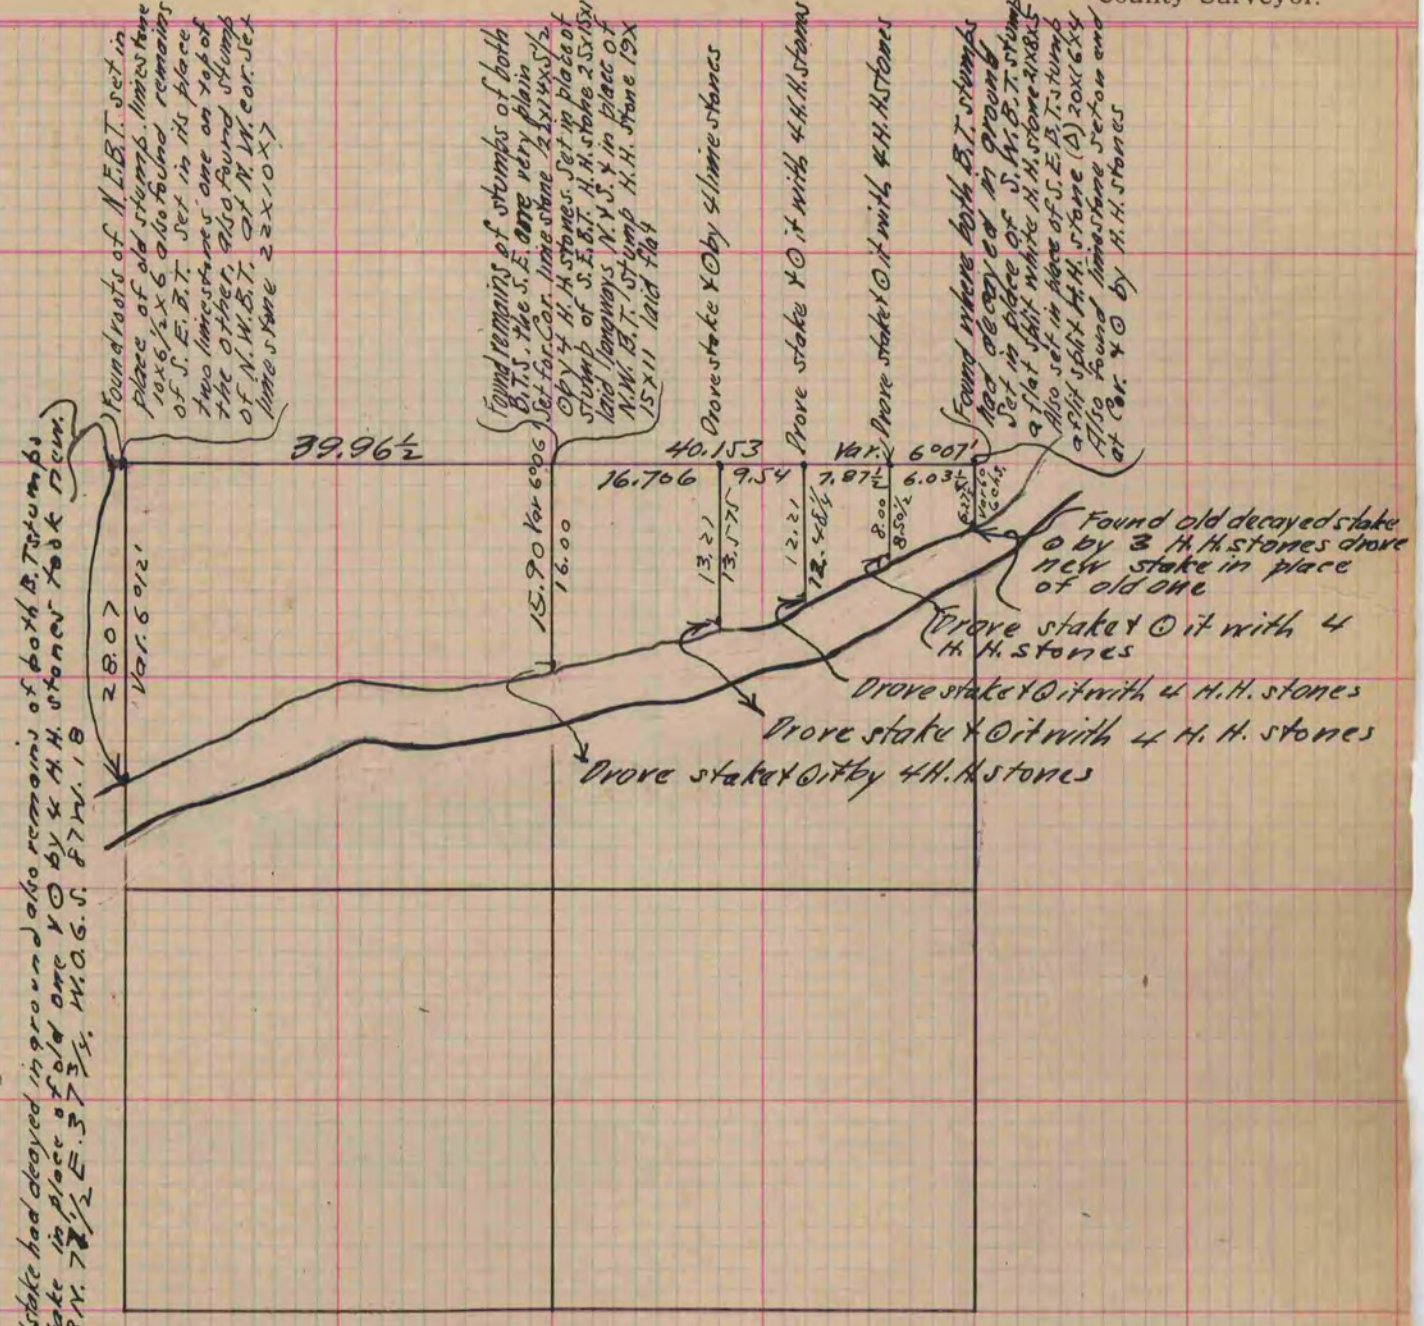

Copied from Page 228 Vol. 2. County Surveyors Record.

COUNTY BUILDING
CITY OF JANESVILLE