PLAT AND RECORD

227
V-5

COUNTY BUILDING
CITY OF JANESVILLE

Of a Survey on Section 8, 10 T 4 N R 12 E. of the 4 P. M. in FULTON Township

Rock County, Wisconsin, made NOV the 19, 22 1976

I hereby certify that the following is a correct record of said survey as made by me.

Donald Baines
County Surveyor.

DONALD A. BAINES
S-1016
JANESVILLE
WIS.
LAND SURVEYOR

THE GEO. D. BARNARD COMPANY, ST. LOUIS
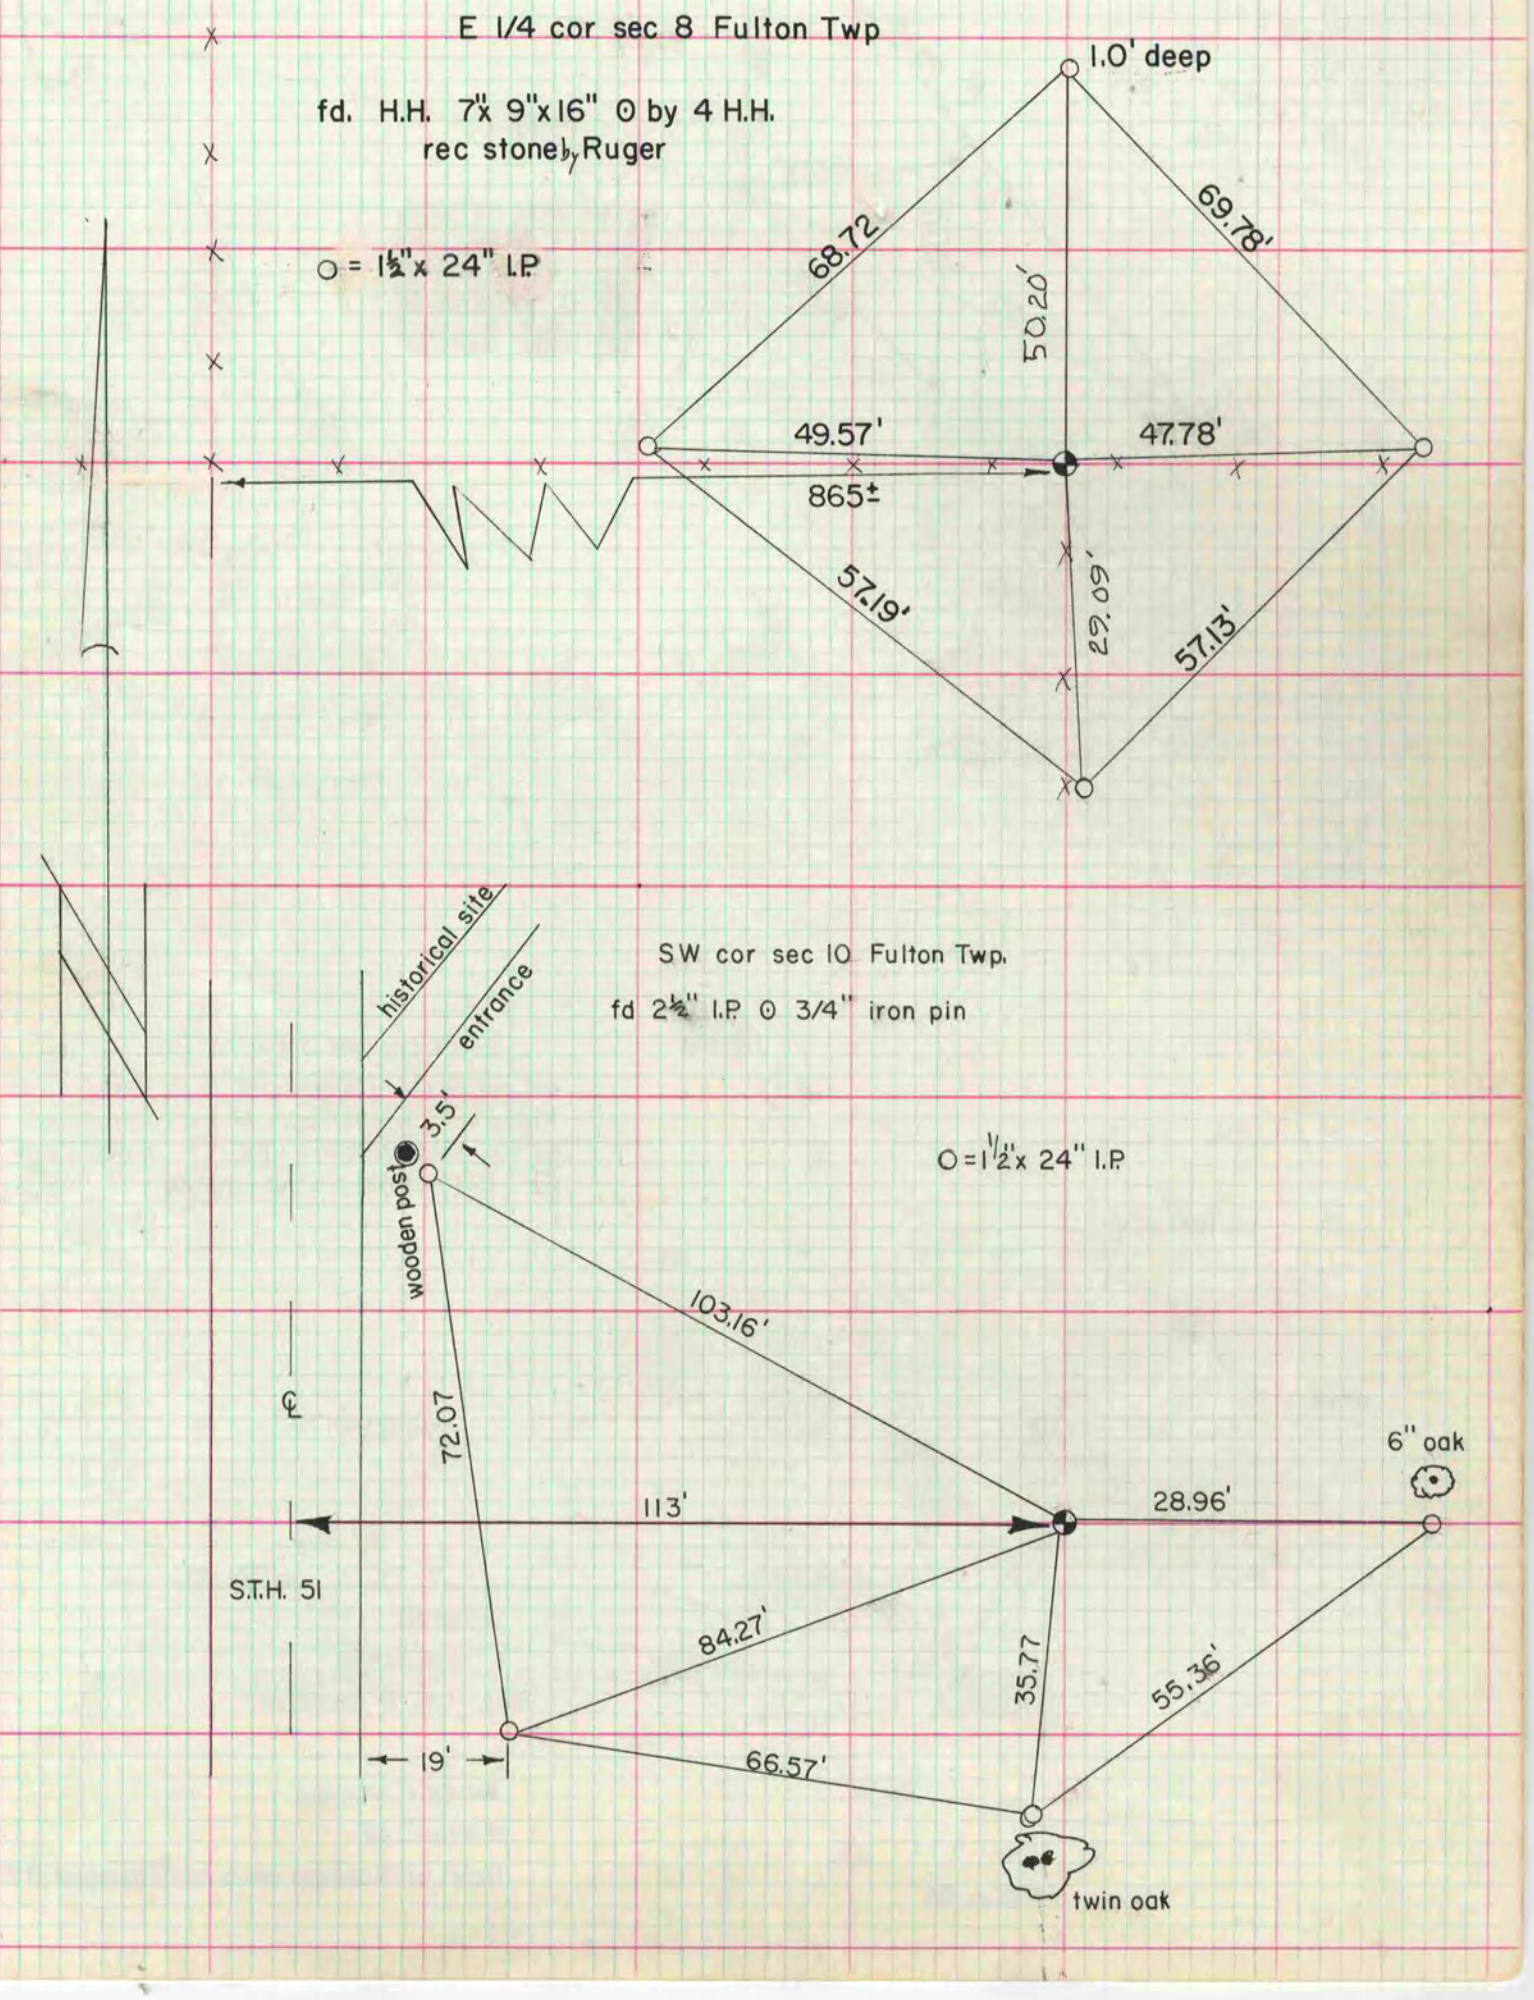
MICROFILMED