MICROFILMED

COUNTY BUILDING
CITY OF JANESVILLE

59
V-2

# PLAT AND RECORD

Of a Survey on Section 31 T 3 R 13 E. of the 4 P. M. in Harmony Township

Rock County, Wisconsin, made April the 3rd & 4th 1871

I hereby certify that the following is a correct record of said survey as made by me.

COUNTY BUILDING
CITY OF JANESVILLE

(Signed) Edward Ruger
R.H.B.
County Surveyor.

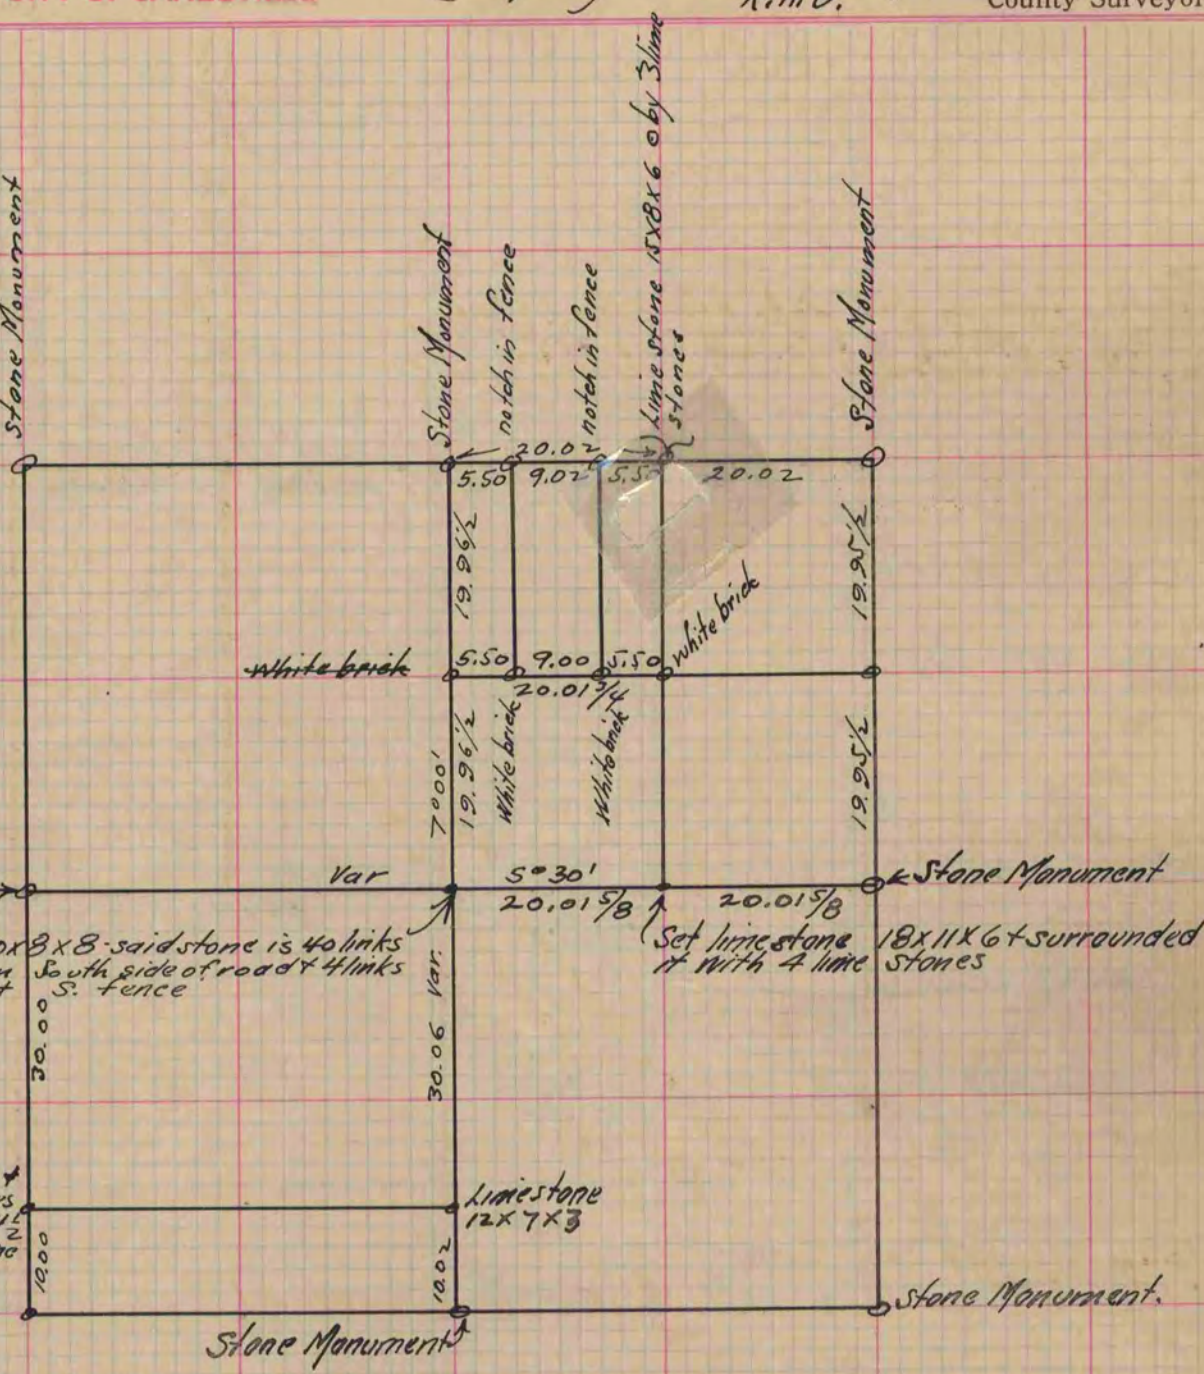


Copied from Page 37 Vol. 2. Original County Surveyors Record