MICROFILMED

PLAT AND RECORD

COUNTY BUILDING
CITY OF JANESVILLE

Of a Survey on Section 22 T 4 R 13 E. of the 4 P. M. in Milton Township

Rock County, Wisconsin, made June the 28-29+30 1875

I hereby certify that the following is a correct record of said survey as made by me.

(Signed) Edward Ruger
R.H.B. County Surveyor.

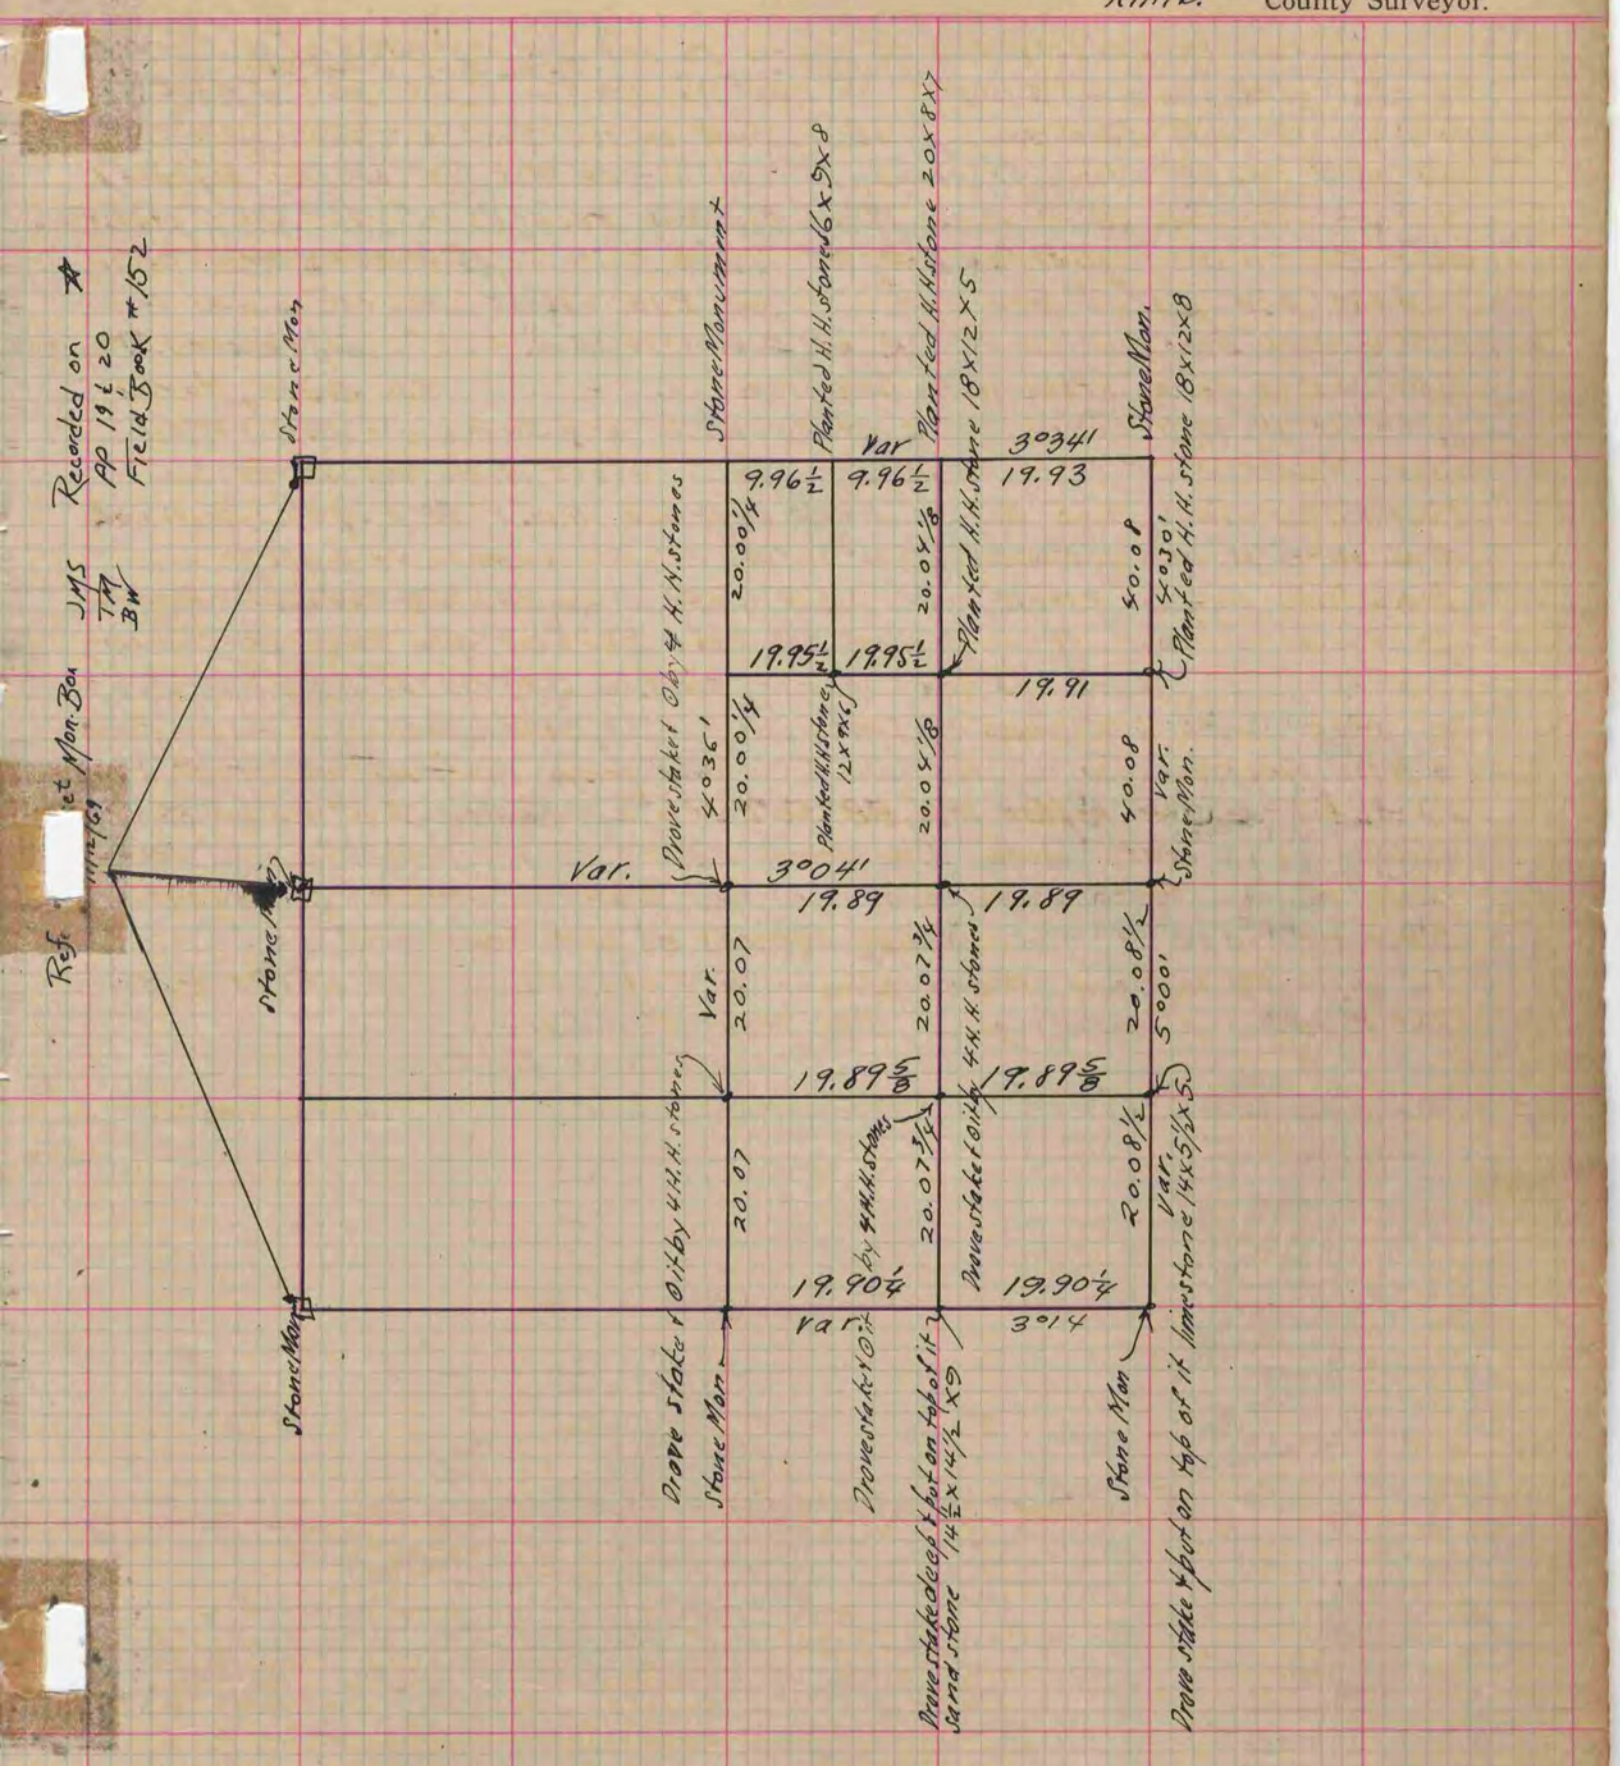

* Copied from Beloit Records
12/11/75 G.Q.

Copied from page 149 Vol. 2 Original County Surveyors Record